

Environmental Services - Water Quality
Onsite Wastewater Scan Data Entry Form

PERMIT #: 0037246

PIN #: 0688500218

OP DATE: 1110311987

SYSTEM USE:

- ☒ House
☐ Mobile Home
☐ Business
☐ Other

SEWAGE TYPE:

- ☒ Domestic
☐ Industrial

PUMP/SIPHON?:

- ☐ Yes
☒ No

PRESSURE MANIFOLD:

- ☐ Yes
☒ No

SYSTEM TYPE:

- ☐ I
☒ II
☐ III
☐ IV
☐ V
☐ VI
☐ Other

SUB TYPE:

- ☒ A
☐ B
☐ C
☐ D
☐ E
☐ F
☐ G

NBR BEDROOMS:

- ☐ 1
☐ 2
☒ 3
☐ 4
☐ 5
☐ 6
☐ Other

MAINT. SCHEDULE:

- ☐ Yes
☒ No

CERT. OPERATOR

- ☐ Yes
☒ No

GT	ST	PT	SIZE
☐	☐		750
☐	☐	☐	900
☐	☒	☐	1,000
☐	☐	☐	1,200
☐	☐	☐	1,500
☐	☐	☐	1,800
☐	☐	☐	2,100
☐	☐	☐	2,500
☐	☐	☐	3,000
☐	☐	☐	4,000
☐	☐	☐	5,000
☐	☐	☐	8,000
☐	☐	☐	10,000
☐	☐	☐	Other
☒		☒	None/NA GT or PT

DRAINFIELD SIZE(SQ. FT.)

01100

DRAIN TYPE:

- ☒ Stone
☐ EZ Flow
☐ Infiltrator
☐ Biodiffuser
☐ Cultec
☐ Drip
☐ Hancor
☐ Large Dia. Pipe
☐ Multi-Pipe
☐ Other

MAX DEPTH (IN.):

- ☐ 12 in. or less
☐ 18 in. or less
☒ 24 in. or less
☐ 26 in. or less
☐ 28 in. or less
☐ 30 in. or less
☐ 32 in. or less
☐ 36 in. or less
☐ Other

STONE DEPTH (IN.):

- ☐ 8 in. or less
☒ 12 in. or less
☐ 18 in. or less
☐ 24 in. or less
☐ Other

TRENCHES:

- ☒ Individual
☐ Bed

TRENCH WIDTH (IN.):

- ☐ 12 in. or less
☐ 18 in.
☐ 24 in.
☒ 36 in.
☐ 6 ft. or less
☐ 9 ft. or less
☐ Other

11/19/14

WAKE COUNTY HEALTH DEPARTMENT SEPTIC TANK LAYOUT AND PERMIT

37246

TAX MAP NO. 823 PARCEL NO. 45

PERMIT NO. B
OPERATION PERMIT ☐

M-CK.

CONTRACTOR Andrew McDougall

OWNER

DATE 9-2-86

LOCATION 5537 Duncallie Dr

S. R. NO. 2752

SUBDIVISION NAME Duncallie Downs LOT NO. 10

SECTION OR BLOCK NO.

REPAIR ☐ ORIGINAL PERMIT NO.

GARBAGE DISPOSAL UNIT YES ☐ NO ☒

HOUSE ☒ MOBILE HOME ☐ BUSINESS ☐

NO. BEDROOMS 3 LOT AREA 0.68 ac.

SIZE OF TANK 1000 gal.

NITRIFICATION LINE 1100 2 (123' x 3') sq. ft.

DEPTH OF STONE IN LINES: 12" ☒

RISER AND BAFFLE REQUIRED ☒ PUMP REQUIRED ☐

WATER SUPPLY: INDIVIDUAL ☐ PUBLIC ☒ OTHER ☐


* PERMIT VOID 36 MONTHS FROM DATE OF ISSUANCE.

* PERMIT VOID IF NOT IN COMPLIANCE WITH ZONING REGULATIONS

* PERMIT MAY BE VOIDED IF SITE ALTERATIONS MADE

LAYOUT BY

W. H. G. P.S.

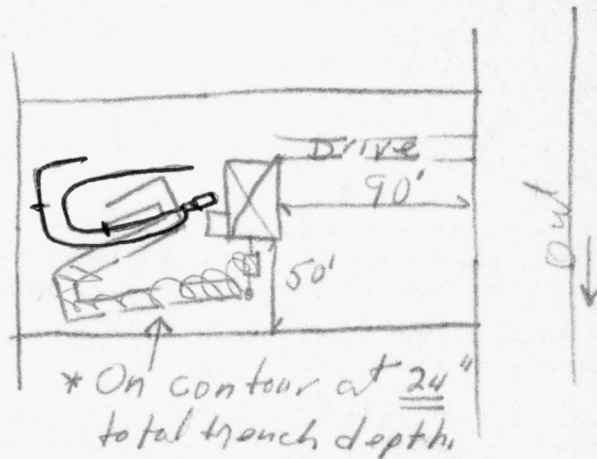

DATE

11/3/87

INSTALLED BY


Glen Todd

APPROVED BY

Robert G. Fisher P.S.

Applicant - Andrew Mc Donald

Dunnalie Drive

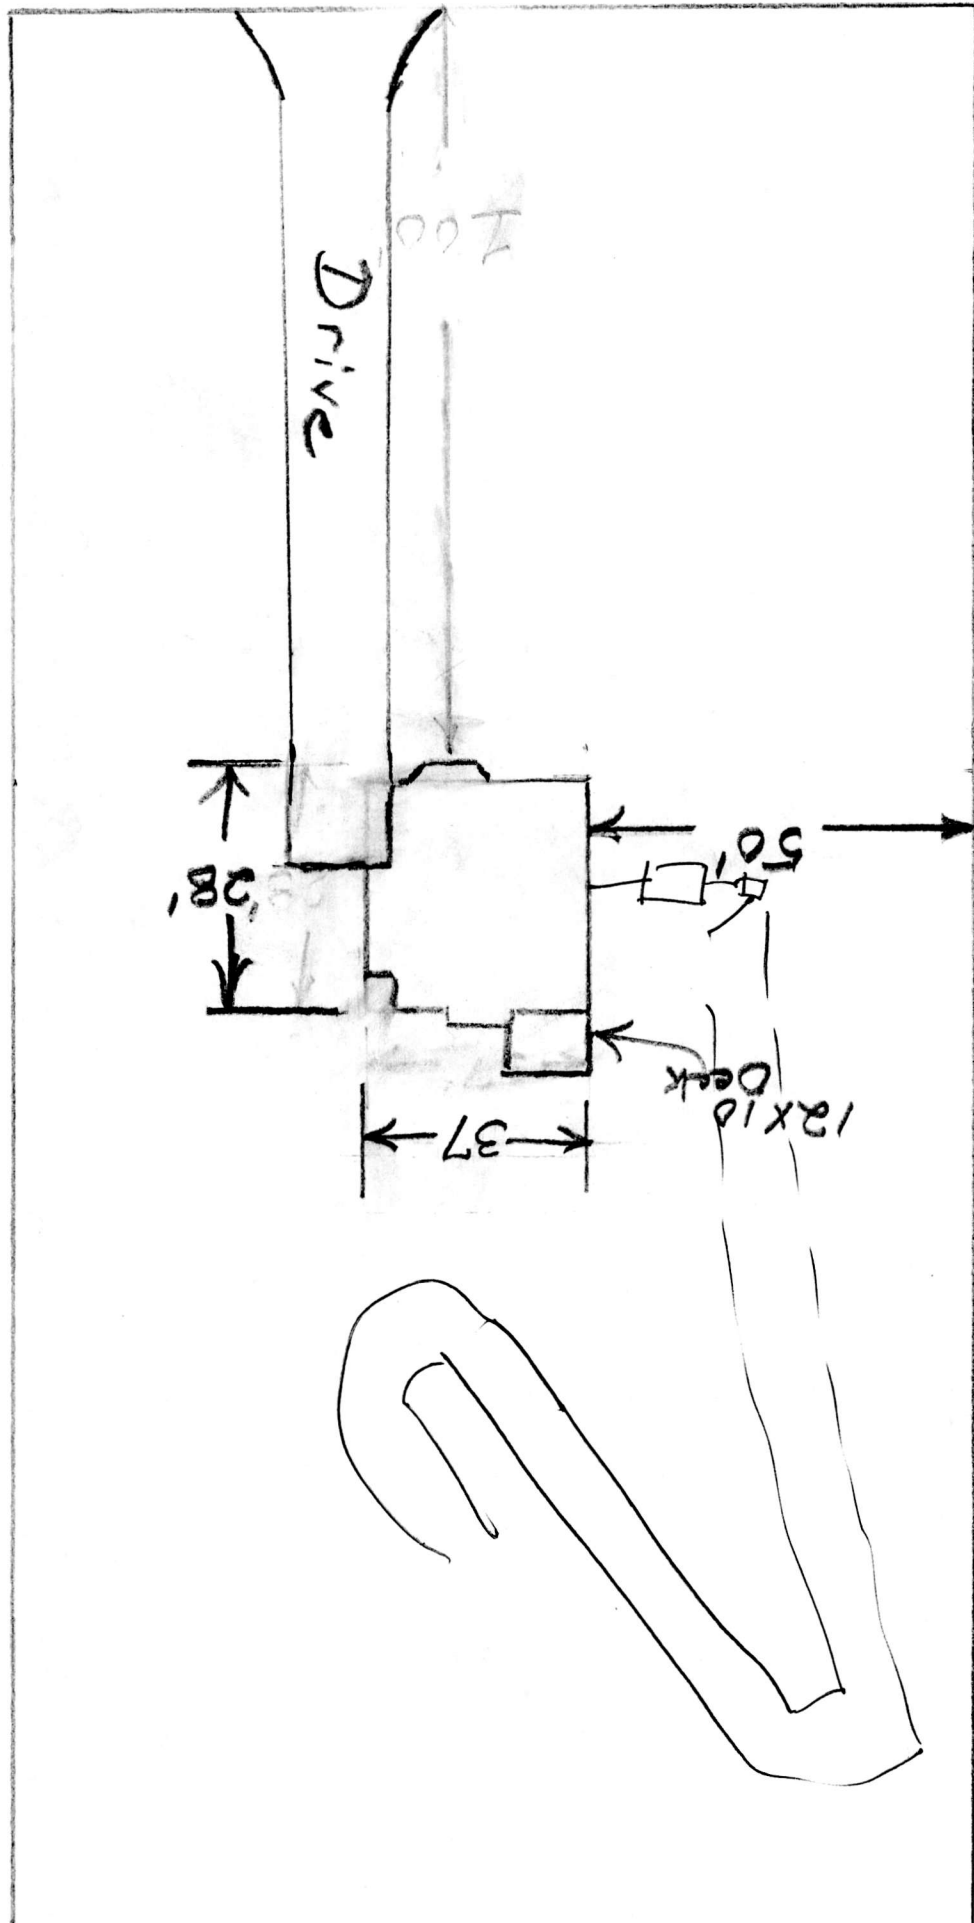

5537 Dunnalie Drive

Lot # 10