

Environmental Services - Water Quality
Onsite Wastewater Scan Data Entry Form

PERMIT #: **WA16035**

PIN #: **1607469267**

OP DATE: **07/18/2017**

SYSTEM USE:

- ☒ House
☐ Mobile Home
☐ Business
☐ Other

SEWAGE TYPE:

- ☒ Domestic
☐ Industrial

PUMP/SIPHON?:

- ☐ Yes
☒ No

PRESSURE MANIFOLD:

- ☐ Yes
☒ No

SYSTEM TYPE:

- ☐ I
☒ II
☐ III
☐ IV
☐ V
☐ VI
☐ Other

SUB TYPE:

- ☒ A
☐ B
☐ C
☐ D
☐ E
☐ F
☐ G

NBR BEDROOMS:

- ☐ 1
☐ 2
☐ 3
☒ 4
☐ 5
☐ 6
☐ Other

MAINT. SCHEDULE:

- ☐ Yes
☒ No

CERT. OPERATOR

- ☐ Yes
☒ No

GT	ST	PT	SIZE
☐	☐		750
☐	☐	☐	900
☐	☒	☐	1,000
☐	☐	☐	1,200
☐	☐	☐	1,500
☐	☐	☐	1,800
☐	☐	☐	2,100
☐	☐	☐	2,500
☐	☐	☐	3,000
☐	☐	☐	4,000
☐	☐	☐	5,000
☐	☐	☐	8,000
☐	☐	☐	10,000
☐	☐	☐	Other
☒		☒	None/NA GT or PT

DRAINFIELD SIZE(SQ. FT.)

01350

900 + 405

DRAIN TYPE:

- ☐ Stone
☒ EZ Flow
☐ Infiltrator
☐ Biodiffuser
☐ Cultec
☐ Drip
☐ Hancor
☐ Large Dia. Pipe
☐ Multi-Pipe
☐ Other

MAX DEPTH (IN.):

- ☐ 12 in. or less
☐ 18 in. or less
☒ 24 in. or less
☐ 26 in. or less
☐ 28 in. or less
☐ 30 in. or less
☐ 32 in. or less
☐ 36 in. or less
☐ Other

STONE DEPTH (IN.):

- ☐ 8 in. or less
☒ 12 in. or less
☐ 18 in. or less
☐ 24 in. or less
☐ Other


TRENCHES:

- ☒ Individual
☐ Bed

TRENCH WIDTH (IN.):

- ☐ 12 in. or less
☐ 18 in.
☐ 24 in.
☒ 36 in.
☐ 6 ft. or less
☐ 9 ft. or less
☐ Other

JTW

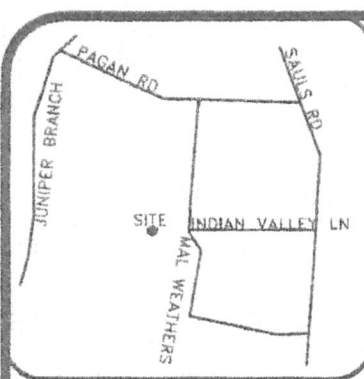


VICINITY MAP (NTS)

LEGEND

- PO=PORCH
- P=PATIO
- SW=SIDEWALK
- DW=CONC DRIVEWAY
- EB=ELECTRIC BOX
- SCO=CLEAN OUT
- TP=TELEPHONE
- WM=WATER METER
- AC=AIR COND
- BOC=BACK OF CURB
- EOP=EDGE OF PAVEMENT

- IRON PIPE FOUND
- IRON PIPE SET
- CALCULATED POINT

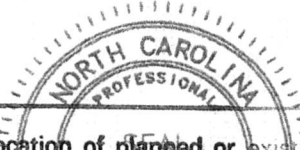

THIS SURVEY IS OF AN EXISTING PARCEL OR PARCELS OF LAND AND DOES NOT CREATE A NEW STREET OR CHANGE AN EXISTING STREET.

Shawn T. Rumberger 9-8-16
 SHAWN T. RUMBERGER, PLS L-4909 DATE



THIS MAP IS ONLY INTENDED FOR THE PARTIES AND PURPOSES SHOWN. THIS MAP IS NOT FOR RECORDATION. NO TITLE REPORT PROVIDED.

SETBACKS
CLUSTER DEVELOPMENT
ZONE R-30 (5-11)

FRONT	15'
SIDE	5'
REAR	15'
SIDE STREET	15'

I hereby certify that the location of planned or existing structure(s) are accurately shown. I understand the importance to locate structures in accordance with this site plan may require the relocation of structure(s) regardless degree of completion. I hereby grant permission to Municipal/County representatives the right of entry to make evaluations or inspections upon this property.

Signature of Owner or Authorized Agent

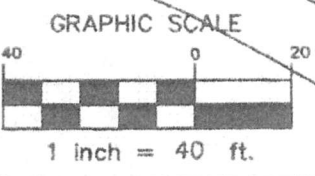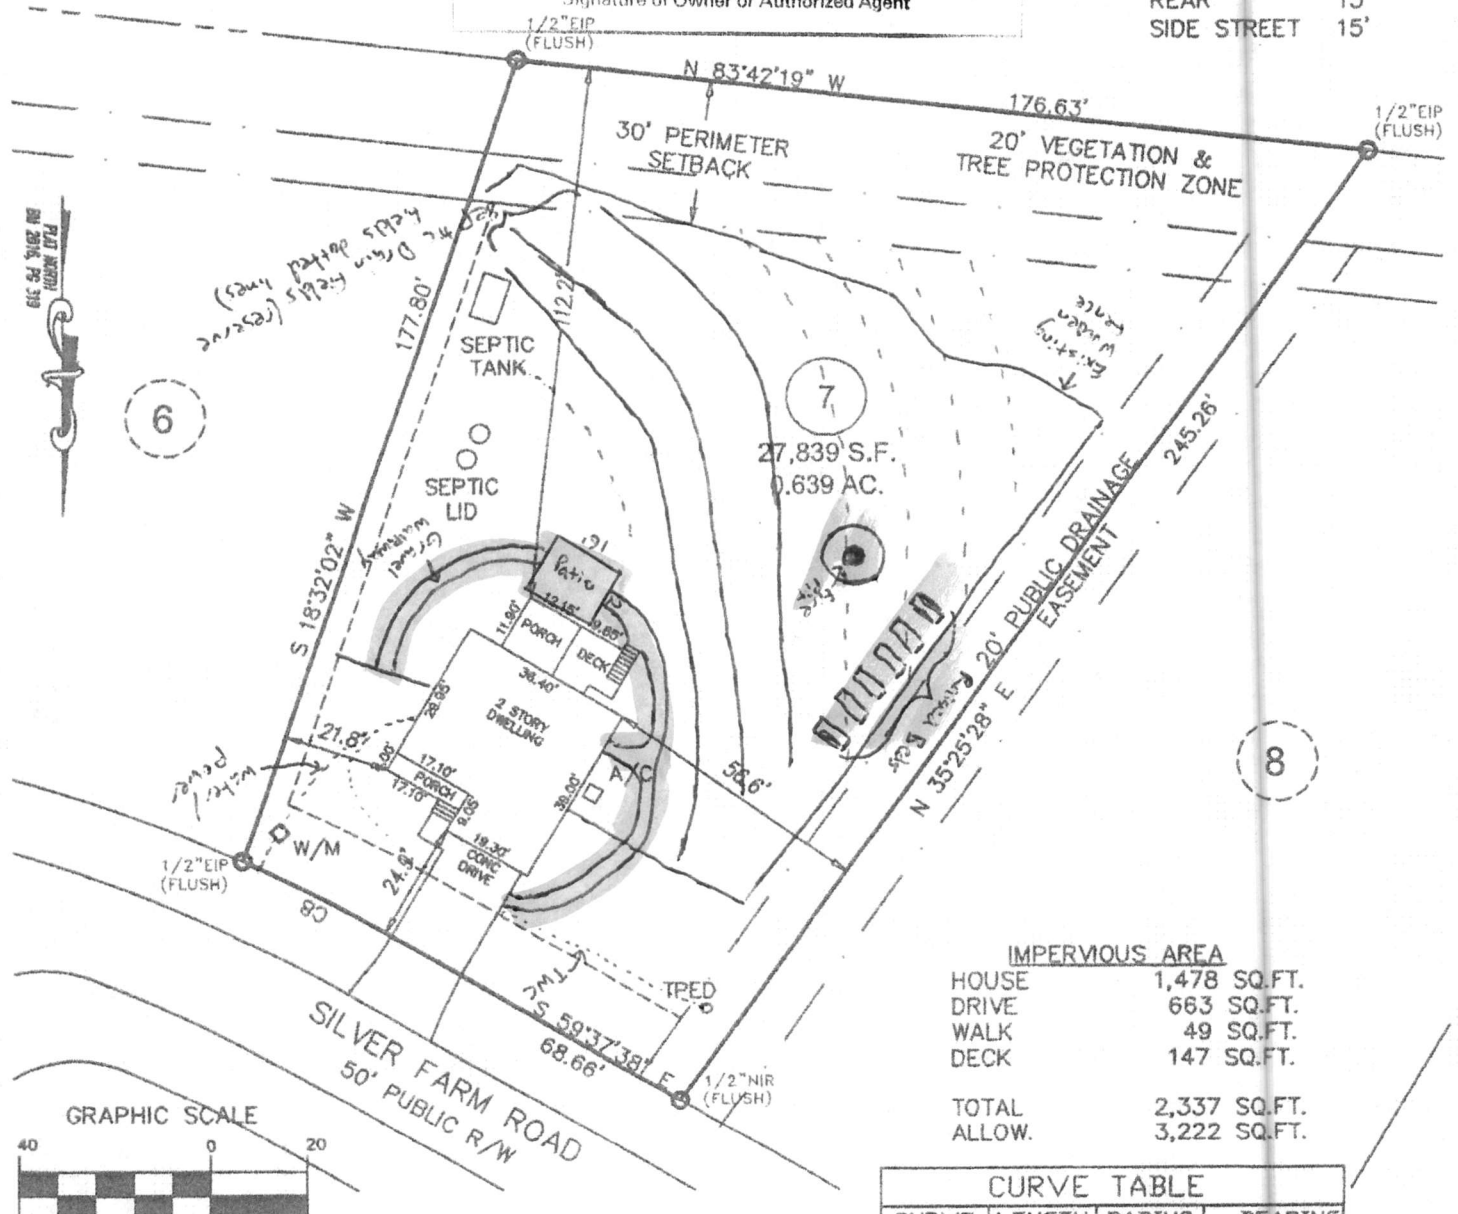

IMPERVIOUS AREA

HOUSE	1,478 SQ.FT.
DRIVE	663 SQ.FT.
WALK	49 SQ.FT.
DECK	147 SQ.FT.
TOTAL	2,337 SQ.FT.
ALLOW.	3,222 SQ.FT.

CURVE TABLE

CURVE	LENGTH	RADIUS	BEARING
C8	34.61	335.00	S62°35'13"E

FINAL SURVEY

ECLS

PROJECT: 15-002 SILVER POINTE
 DRAWN BY: APS
 SCALE: 1"=40'
 DATE: 9-8-16

FOR
 GEOFFREY PAHEL & ILMIRA KAMALOVA
 1132 SILVER FARM ROAD, RALEIGH
 LOT 7 SILVER POINTE SUBDIVISION
 PANTHER BRANCH TWP., WAKE CO., NC
 B.M. 2016, PG. 319

ECLS GLOBAL
 U.S. VETERAN-OWNED
 19 N MCKINLEY ST
 COATS, NC 27521
 910.897.3257 ECLSINC.COM
 910.897.2329 (FAX) CO#C-4175

Site plan approved as shown for FIRE PIT, GRVL SIDEWALK, PAVED PATIO, RAISED PLANT BEDS
 Any changes to site plan voids approval. All setbacks apply
 for septic systems and wells, regarding any pools, decks,
 additions and/or accessory structures. Applicant is responsible
 for protecting all portions of the septic system, repair area and
 wells from damage during construction. Adhere to all Local and
 State Rules.
 Approved by *Jim Hana* Date 7-18-2017
 Wake County Department of Environmental Services.
 Water and Waste Water Section

W-16035