

Environmental Services - Water Quality
Onsite Wastewater Scan Data Entry Form

PERMIT #: D017875

PIN #: 0646710428

OP DATE: 07/11/2000

SYSTEM USE:

- ☒ House
☐ Mobile Home
☐ Business
☐ Other

SEWAGE TYPE:

- ☒ Domestic
☐ Industrial

PUMP/SIPHON?:

- ☐ Yes
☒ No

PRESSURE MANIFOLD:

- ☐ Yes
☒ No

SYSTEM TYPE:

- ☐ I
☒ II
☐ III
☐ IV
☐ V
☐ VI
☐ Other

SUB TYPE:

- ☒ A
☐ B
☐ C
☐ D
☐ E
☐ F
☐ G

NBR BEDROOMS:

- ☐ 1
☐ 2
☒ 3
☐ 4
☐ 5
☐ 6
☐ Other

MAINT. SCHEDULE:

- ☐ Yes
☒ No

CERT. OPERATOR

- ☐ Yes
☒ No

GT	ST	PT	SIZE
☐	☐	☐	750
☐	☐	☐	900
☐	☒	☐	1,000
☐	☐	☐	1,200
☐	☐	☐	1,500
☐	☐	☐	1,800
☐	☐	☐	2,100
☐	☐	☐	2,500
☐	☐	☐	3,000
☐	☐	☐	4,000
☐	☐	☐	5,000
☐	☐	☐	8,000
☐	☐	☐	10,000
☐	☐	☐	Other
☒	☐	☒	None/NA GT or PT

DRAINFIELD SIZE(SQ. FT.)

00720

DRAIN TYPE:

- ☒ Stone
☐ EZ Flow
☐ Infiltrator
☐ Biodiffuser
☐ Cultec
☐ Drip
☐ Hancor
☐ Large Dia. Pipe
☐ Multi-Pipe
☐ Other

MAX DEPTH (IN.):

- ☐ 12 in. or less
☐ 18 in. or less
☐ 24 in. or less
☐ 26 in. or less
☐ 28 in. or less
☒ 30 in. or less
☐ 32 in. or less
☐ 36 in. or less
☐ Other

STONE DEPTH (IN.):

- ☐ 8 in. or less
☒ 12 in. or less
☐ 18 in. or less
☐ 24 in. or less
☐ Other

TRENCHES:

- ☒ Individual
☐ Bed

TRENCH WIDTH (IN.):

- ☐ 12 in. or less
☐ 18 in.
☐ 24 in.
☒ 36 in.
☐ 6 ft. or less
☐ 9 ft. or less
☐ Other

APW

WAKE COUNTY DEPARTMENT OF ENVIRONMENTAL SERVICES WELL AND SEWAGE SITE LOCATION PERMIT

NO PERMIT(S) FOR CONSTRUCTION, LOCATION OR RELOCATION ACTIVITY SHALL BE ISSUED

UNTIL AN AUTHORIZATION FOR WASTEWATER SYSTEM CONSTRUCTION HAS BEEN ISSUED

PERMIT VOID IF NOT IN COMPLIANCE WITH ZONING REGULATIONS AND/OR IF SITE IS ALTERED OR INTENDED USE CHANGED

PERMIT#: D017875 STATUS: A APP DATE: 04/05/2000 BLDG PERMIT#: 0003468
 APPLICANT: OAK RIDGE BLDRS DAY PHONE: (919) 422 - 8414
 ADDRESS: 7007 SCARLETT LN FAX#: (919) 999 - 9999
 CITY: GARNER STATE: NC ZIP: 27529
 OWNER: WILSON, RUBY C DAY PHONE: (919) 999 - 9999
 ADDRESS: 304 RALEIGH ST FAX#: (919) 999 - 9999
 CITY: FUQUAY STATE: NC ZIP: 27526
 HD USE CD: 101 ONE-FAMILY HOUSE ORIG PERMIT#: REC?: Y
 EXIST USE: TAX MAP#: 0864 0020
 BEDROOMS: 3 BSMT: N #EMPLOYEES: 0 WATER: C WASTEWATER: I GARB DISPOS: N
 TOWNSHIP: 12 MIDDLE CREEK JURIS: WC ZON: HD PIN: 0646.04 71.0650 0000 **0428**
 SUBD#: S 000 000 00 SUBD NAME: WILSONS POND LOT-SEC: 41 ACRE: 0.34
 IMPRV PRMT: ISSUED?: Y DATE: 05/01/2000 BY: SFM TYPE SYSTEM: II A PUMP:
 CNSTR AUTH: ISSUED?: Y DATE: 05/01/2000 BY: SFM MAINT: N OPER: N
 RECEIPT#: FEE: 290.00 OP DATE: BY:
 WATR SAMPL: REQ?: N APPROVED?: DATE: PROPRIETARY SYS:
 ST#: 7908 MI: DIR: NAME: WILSON POND DIR: TYP: LN
 DIRECTIONS: GO 401 S-RIGHT HWY 42-LEFT SR1101-SUB DIV ON
 RIGHT--LOT #

IMPROVEMENT PERMIT

SIZE OF TANK 1000 ST PT GALS. TOTAL SQ. FT. 720 DEPTH OF STONE 12 IN. MAX. DEPTH LINE 30 IN.

WASTEWATER: DOMESTIC ☒ INDUSTRIAL ☐

I.P. ISSUED BY

Steven Meyer, R.S.

AUTHORIZATION FOR WASTEWATER SYSTEM CONSTRUCTION

VOID SIXTY (60) MONTHS FROM DATE OF ISSUANCE

AUTHORIZATION CONDITIONS

Contractor To Follow Contours, See Attached Site Plan For Wastewater System Design And Well Location. The wastewater system shall not be covered or placed into use until inspected by the Wake County Department of Environmental Services and an Operation Permit issued.

OTHER CONDITIONS: INSTALL LINES ON CONTOUR WITH NO STEP DOWNS. MAINTAIN SETBACKS. ALL DECKS, STEPS AND SIDEWALKS SHALL BE CONTAINED WITHIN SUBMITTED BUILDING FOOTPRINT. ANY CHANGES WILL VOID PERMIT. CALL PRIOR TO CONSTRUCTION WITH ANY CHANGES OR QUESTIONS.

SIZE OF TANK 1000 ST PT GALS. TOTAL SQ. FT. 720 DEPTH OF STONE 12 IN. MAX. DEPTH LINE 30 IN.

ST FILTER REQUIRED ☒ NUMBER OF TRENCHES 3 LENGTH OF TRENCHES 80 FT. WIDTH OF TRENCHES 3 FT.

C.A. ISSUED BY *Steven Meyer, R.S.* INSTALLED BY *Patten's Backhoe* CTR. I.D. # _____

SEPTIC TANK FILTER USED _____

INNOV. APPL. #: IWWS-_____ DATE 7/11/00 INSTALLATION APPROVED BY *Janis Rowe*

WELL SYSTEM = PRIVATE ☐ SEMI-PUBLIC ☐ NEW ☐ REPLACEMENT ☐ EXISTING ☐

WELL LOG INFORMATION = DEPTH _____ CASING DEPTH _____ YIELD _____ STATIC LEVEL _____

WELL CONTRACTOR _____ REG.# _____ PUMP CONTRACTOR _____ REG.# _____

CONSTRUCTION COMPLIANCE = GROUT APPROVED ☐ DATE _____ EHS _____

WCHD ID # _____ WELLHEAD APPROVED ☐ DATE _____ EHS _____

NEGATIVE BACTERIOLOGICAL RESULTS ☐ DATE _____ EHS _____


SYSTEM FINALIZED ☐ DATE _____ EHS _____

COMMENTS: _____

This permit is based in part on information provided by the homeowner or his/her representative in the application submitted for this permit. The Environmental Health Specialist is not responsible for false or misleading information contained in the application. The Environmental Health Specialist is also not responsible for concealed conditions on the property or for statements in this report that may have resulted from false or misleading statements provided to him in the application. Neither Wake County nor the Environmental Health Specialist warrants that the septic tank system will continue to function satisfactorily in the future or that the water supply will remain potable.

0003468

P-17875

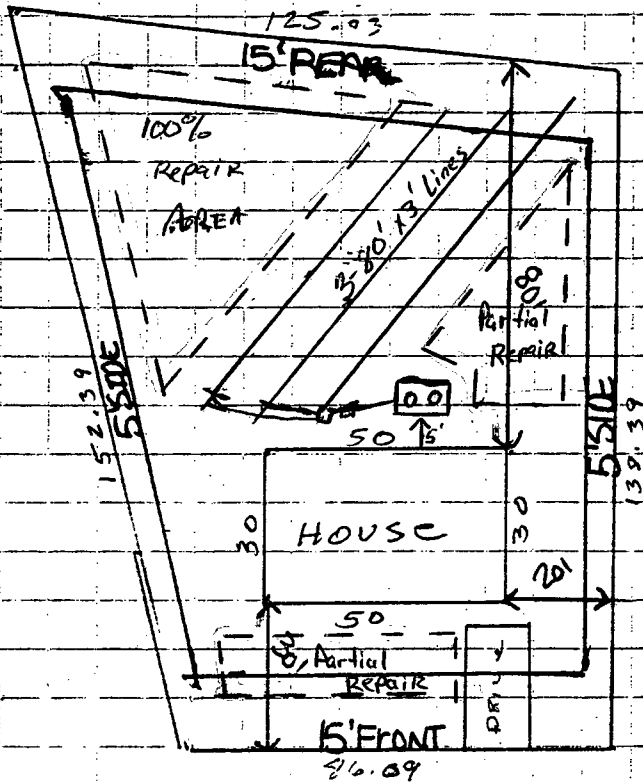

CA

- * 1000 gal ST
- * 720 SG. FT
- * 3'-80' x 3' Lines
- * 30" max trench depth
- * Maintain setbacks
- * Call Prior to Installation with any questions or changes

7908 Wilson Pond Ln.

Plot # 41
Wilson Pond Sub
Oak Ridge Bld- 422-8414
Wilson Pond Ln

PIN# 0646.0471-0650-0428

I certify that the location of planned or existing structure(s) are accurately shown. I understand failure to locate structures in accordance with this plot plan may require the relocation of structure(s) regardless degree of completion. I hereby grant permission to Municipal/County Representatives the right of entry to make evaluations or inspections upon this property.

Gina Parrish 4300
Signature of Owner or Authorized Agent

Zoning HD By CG
Approve ✓ Date 4-4-00
Revise _____ Use 101
Reject _____ MBL _____
Front 15 Rear 15
Side 15 Corner 15
Comments: CLUSTER

Scale
1 Block = 10'