

Environmental Services - Water Quality
Onsite Wastewater Scan Data Entry Form

PERMIT #: 0020271

PIN #: 0880402448

OP DATE: 0611412001

SYSTEM USE:

- ☒ House
☐ Mobile Home
☐ Business
☐ Other

SEWAGE TYPE:

- ☒ Domestic
☐ Industrial

PUMP/SIPHON?:

- ☐ Yes
☒ No

PRESSURE MANIFOLD:

- ☐ Yes
☒ No

SYSTEM TYPE:

- ☐ I
☐ II
☒ III
☐ IV
☐ V
☐ VI
☐ Other

SUB TYPE:

- ☐ A
☐ B
☐ C
☐ D
☐ E
☐ F
☒ G

NBR BEDROOMS:

- ☐ 1
☐ 2
☐ 3
☒ 4
☐ 5
☐ 6
☐ Other

MAINT. SCHEDULE:

- ☐ Yes
☒ No

CERT. OPERATOR

- ☐ Yes
☒ No

GT ST PT SIZE

- | | | | |
|-------------------------------------|-------------------------------------|-------------------------------------|------------------|
| ☐ | ☐ | | 750 |
| ☐ | ☐ | ☐ | 900 |
| ☐ | ☐ | ☐ | 1,000 |
| ☐ | ☒ | ☐ | 1,200 |
| ☐ | ☐ | ☐ | 1,500 |
| ☐ | ☐ | ☐ | 1,800 |
| ☐ | ☐ | ☐ | 2,100 |
| ☐ | ☐ | ☐ | 2,500 |
| ☐ | ☐ | ☐ | 3,000 |
| ☐ | ☐ | ☐ | 4,000 |
| ☐ | ☐ | ☐ | 5,000 |
| ☐ | ☐ | ☐ | 8,000 |
| ☐ | ☐ | ☐ | 10,000 |
| ☐ | ☐ | ☐ | Other |
| ☒ | | ☒ | None/NA GT or PT |

DRAINFIELD SIZE(SQ. FT.)

01350

DRAIN TYPE:

- ☐ Stone
☒ EZ Flow
☐ Infiltrator
☐ Biodiffuser
☐ Cultec
☐ Drip
☐ Hancor
☐ Large Dia. Pipe
☐ Multi-Pipe
☐ Other

MAX DEPTH (IN.):

- ☐ 12 in. or less
☐ 18 in. or less
☒ 24 in. or less
☐ 26 in. or less
☐ 28 in. or less
☐ 30 in. or less
☐ 32 in. or less
☐ 36 in. or less
☐ Other

STONE DEPTH (IN.):

- ☐ 8 in. or less
☒ 12 in. or less
☐ 18 in. or less
☐ 24 in. or less
☐ Other

TRENCHES:

- ☒ Individual
☐ Bed

TRENCH WIDTH (IN.):

- ☐ 12 in. or less
☐ 18 in.
☐ 24 in.
☒ 36 in.
☐ 6 ft. or less
☐ 9 ft. or less
☐ Other

04

WAKE COUNTY DEPARTMENT OF ENVIRONMENTAL SERVICES WELL AND SEWAGE SITE LOCATION PERMIT
NO PERMIT(S) FOR CONSTRUCTION, LOCATION OR RELOCATION ACTIVITY SHALL BE ISSUED
UNTIL AN AUTHORIZATION FOR WASTEWATER SYSTEM CONSTRUCTION HAS BEEN ISSUED

PERMIT VOID IF NOT IN COMPLIANCE WITH ZONING REGULATIONS AND/ OR IF SITE IS ALTERED OR INTENDED USE CHANGED

PERMIT#: D020271 STATUS: A APP. DATE: 12/15/2000 BLDG. PERMIT#: 0011997
PIN: 0880.03 40 ~~6248~~ 000 2448 TAX MAP: 0238 RECORDED: Y ORIG. PERMIT#:
TOWNSHIP: 08 LEESVILLE JURISDICTION: WC ZONING: 40W
APPLICANT: AMMONS BLDG CORP
7021 VALLEY DR
RALEIGH, NC 27612
(919) 847 - 1994
USE: HD USE: 101 ONE-FAMILY HOUSE
EXIST USE:
DISPOSAL: N BEDROOMS: 4 BASEMENT: N #EMPLOYEES: 0
SITE: ADDRESS: ~~4824~~ BOULDER CREEK LA 4829
SUBDIVISION: BOULDER LAKE LOT: 4 ACRES: 2.21
DIRECTION: SIX FORKS N L NORWOOD R VICTORY CHURCH R BOULDE
R CREEK LANE

Well System: WATER: COMMUNITY - TYPE: NEW

WELL LOG INFORMATION: DEPTH: _____ CASING DEPTH: _____ YIELD: _____ STATIC LEVEL: _____
WELLI CONTRACTOR: _____ REG.# _____ PUMP CONTRACTOR: _____ REG.# _____
Construction Compliance GROUT APPROVED ☐ DATE _____ EHS _____
WELLHEAD APPROVED ☐ DATE _____ EHS _____
SYSTEM FINALIZED ☐ DATE _____ EHS _____

COMMENTS:

Operation Permit

DESIGN FLOW: _____ gal./min. ACTUAL FLOW: _____ INNOVATIVE LETTER: _____

INSTALLED BY: Billy Kelly
PROPRIETARY SYSTEM: E-Z LAY
COMMENTS:

INSTALLATION APPROVED BY: Glenn J. J. J.
FILTER NO: ZABEL

OPERATIONS PERMIT ISSUED? _____ OP DATE: 06/14/01 BY: _____

This permit is based in part on information provided by the homeowner or his/her representative in the application submitted for this permit. The Environmental Health Specialist is not responsible for false or misleading information contained in the application. The Environmental Health Specialist is also not responsible for concealed conditions on the property or for statements in this report that may have resulted from false or misleading statements provided to him in the application. Neither Wake County nor the Environmental Health Specialist warrants that the septic tank system will continue to function satisfactorily in the future or that the water supply will remain potable.

WAKE COUNTY DEPARTMENT OF ENVIRONMENTAL SERVICES WELL AND SEWAGE SITE LOCATION PERMIT

NO PERMIT(S) FOR CONSTRUCTION, LOCATION OR RELOCATION ACTIVITY SHALL BE ISSUED

UNTIL AN AUTHORIZATION FOR WASTEWATER SYSTEM CONSTRUCTION HAS BEEN ISSUED

PERMIT VOID IF NOT IN COMPLIANCE WITH ZONING REGULATIONS AND/ OR IF SITE IS ALTERED OR INTENDED USE CHANGED

PERMIT#: D020271 STATUS: A APP. DATE: 12/15/2000 BLDG. PERMIT#: 0011997
PIN: 0880.03 40 ~~6349~~ 000 **2448** TAX MAP: 0238 0004 RECORDED: Y ORIG. PERMIT#:
TOWNSHIP: 08 LEESVILLE JURISDICTION: WC ZONING: 40W
APPLICANT: AMMONS BLDG CORP
7021 VALLEY DR
RALEIGH, NC 27612
(919) 847 - 1994
USE: HD USE: 101 ONE-FAMILY HOUSE
EXIST USE:
DISPOSAL: N BEDROOMS: 4 BASEMENT: N #EMPLOYEES: 0
SITE: ADDRESS: ~~4824~~ BOULDER CREEK LA **4829**
SUBDIVISION: BOULDER LAKE LOT: 4 ACRES: 2.21
DIRECTION: SIX FORKS N L NORWOOD R VICTORY CHURCH R BOULDE
R CREEK LANE

IMPROVEMENT PERMIT

TANK SIZE: 1200 gal. PUMP Tank: _____ gal. SQ FT: 1350 INNOVATIVE MAX DEPTH LINE: 24 in.
WASTEWATER: INDIVIDUAL SEWAGE: DOMESTIC TYPE SYSTEM: III G PUMP: N P/M: N
DAILY FLOW: 00480 gal/day WATER: COMMUNITY

COMMENTS:

IP ISSUED? Y DATE: 01/26/2001 BY: (SFM) Steve Meyer, RS PHONE#: 856-5706

AUTHORIZATION FOR WASTEWATER/WATER SYSTEM CONSTRUCTION

VOID SIXTY (60) MONTHS FROM DATE OF ISSUANCE

AUTHORIZATION CONDITIONS:

Contractors shall install system on contours, see attached site plan for wastewater system design and well location. No underground utilities, water lines or sprinkler systems may be located in the original system or repair areas. A septic tank filter with a riser for access is required. The wastewater system shall not be covered or placed into use until inspected by the Wake County Department of Environmental Services and an Operation Permit issued. **OTHER CONDITIONS:**
INSTALL LINES AS LAID OUT IN FIELD. INSTALL LINES ON CONTOUR WITH NO STEP DOWNS. SOME TREES MAY HAVE TO BE REMOVED PRIOR TO INSTALLATION. DO NOT EXCEED MAXIMUM TRENCH DEPTH. FENCE OFF SEPTIC AREAS PRIOR TO HOUSE CONSTRUCTION TO MINIMIZE CONSTRUCTION TRAFFIC OVER THESE AREAS. CALL PRIOR TO INSTALLATION WITH ANY QUESTIONS OR CHANGES.

TANK SIZE: 1200 gal. PUMP TANK: _____ gal. SQ FT: 1350 INNOVATIVE MAX DEPTH LINE: 24 in.
MAINT: N OPER: N L/O: Y TRENCH#: 3 LENGTH: 150 ft. WIDTH: 36 in.
SUBFIELDS: _ DESIGN HEAD PRESSURE: _ DESIGN FLOW: _____ gal/min DOSE VOLUME: _____ gal.

CA ISSUED? Y DATE: 01/26/2001 BY: (SFM) Steve Meyer, RS PHONE#: 856-5706

I certify that the location of planned or existing structure(s) are accurately shown. I understand failure to locate structures in accordance with this plot plan may require the relocation of structure(s) regardless degree of completion. I hereby grant permission to Municipal/County Representatives the right of entry to make evaluations or inspections upon this property.

Jill Ann

Signature of Owner or Authorized Agent

Dn:0880.03-40-0340

0011997
D20271

As Built


E 2-64Y

MILLS

1200

5/16/01

ZABEL FILTER

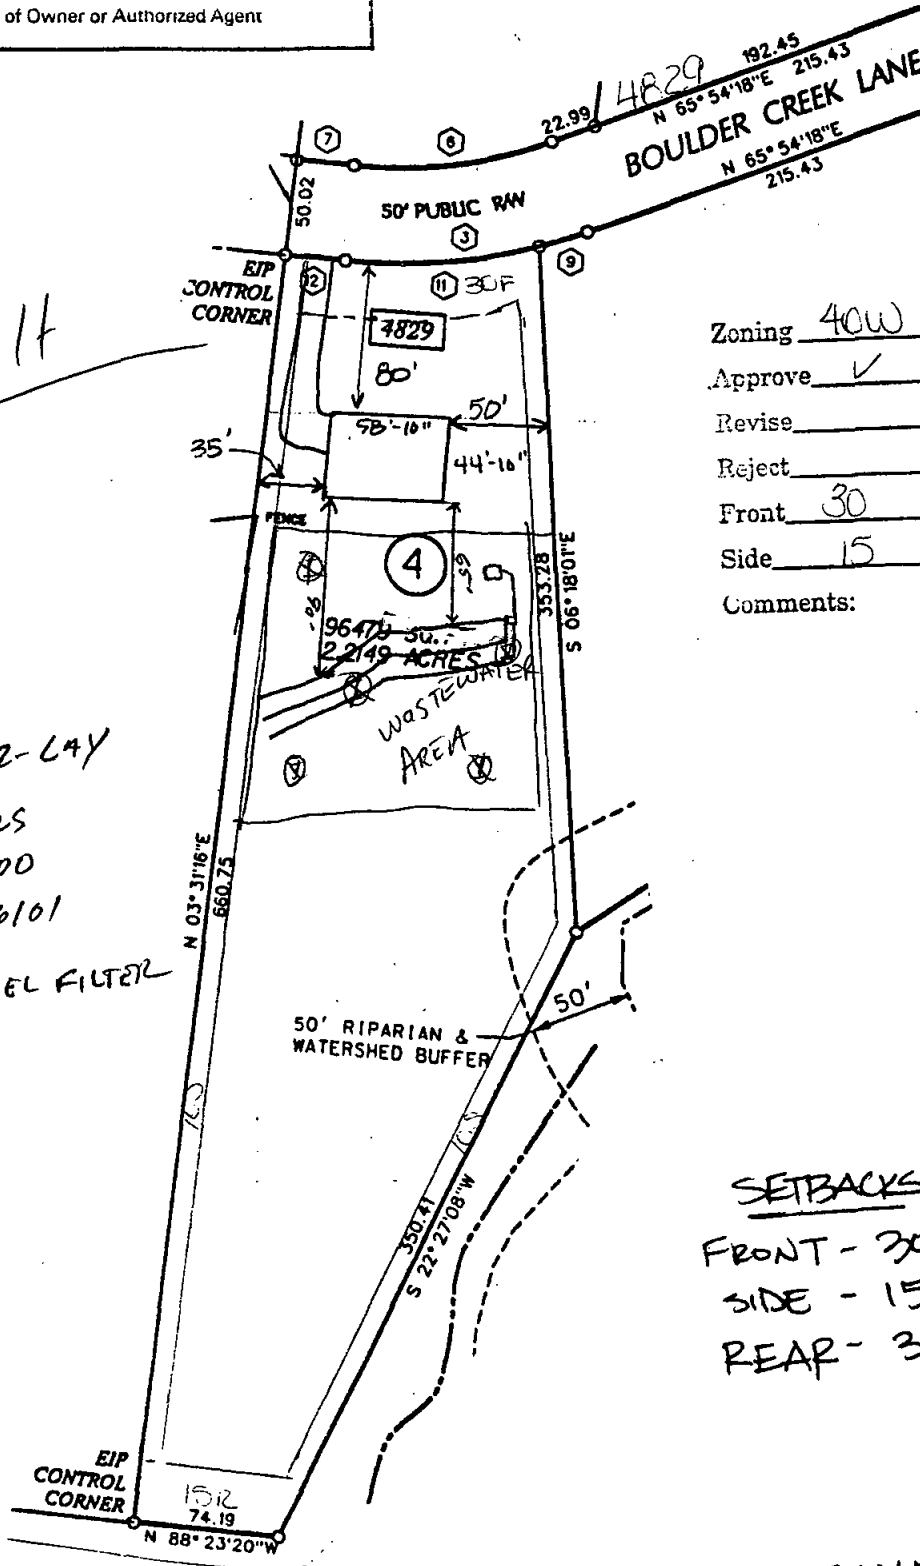

Zoning	40W	By	SJC
Approve	✓	Date	12-15-00
Revise		Use	101
Reject		MBL	
Front	30	Rear	30
Side	15	Corner	

Comments:

SETBACKS

FRONT - 30'
SIDE - 15'
REAR - 30'

SCALE
1" = 100'

4829 Boulder Creek Lane

I certify that the location of planned or existing structure(s) are accurately shown. I understand failure to locate structures in accordance with this plot plan may require the relocation of structure(s) regardless degree of completion. I hereby grant permission to Municipal/County Representatives the right of entry to make evaluations or inspections upon this property.


Jill Ann

Signature of Owner or Authorized Agent

Dn:0880.03-40-0340

0011997
D20271

- CA
- * 1200 sq ft
 - * 1350 sq. ft. Innov.
 - * 3-150' x 3' Innov.
 - * 24' max T.D.
 - * No Stepdowns
 - * Call Prior to Construction with any questions or changes

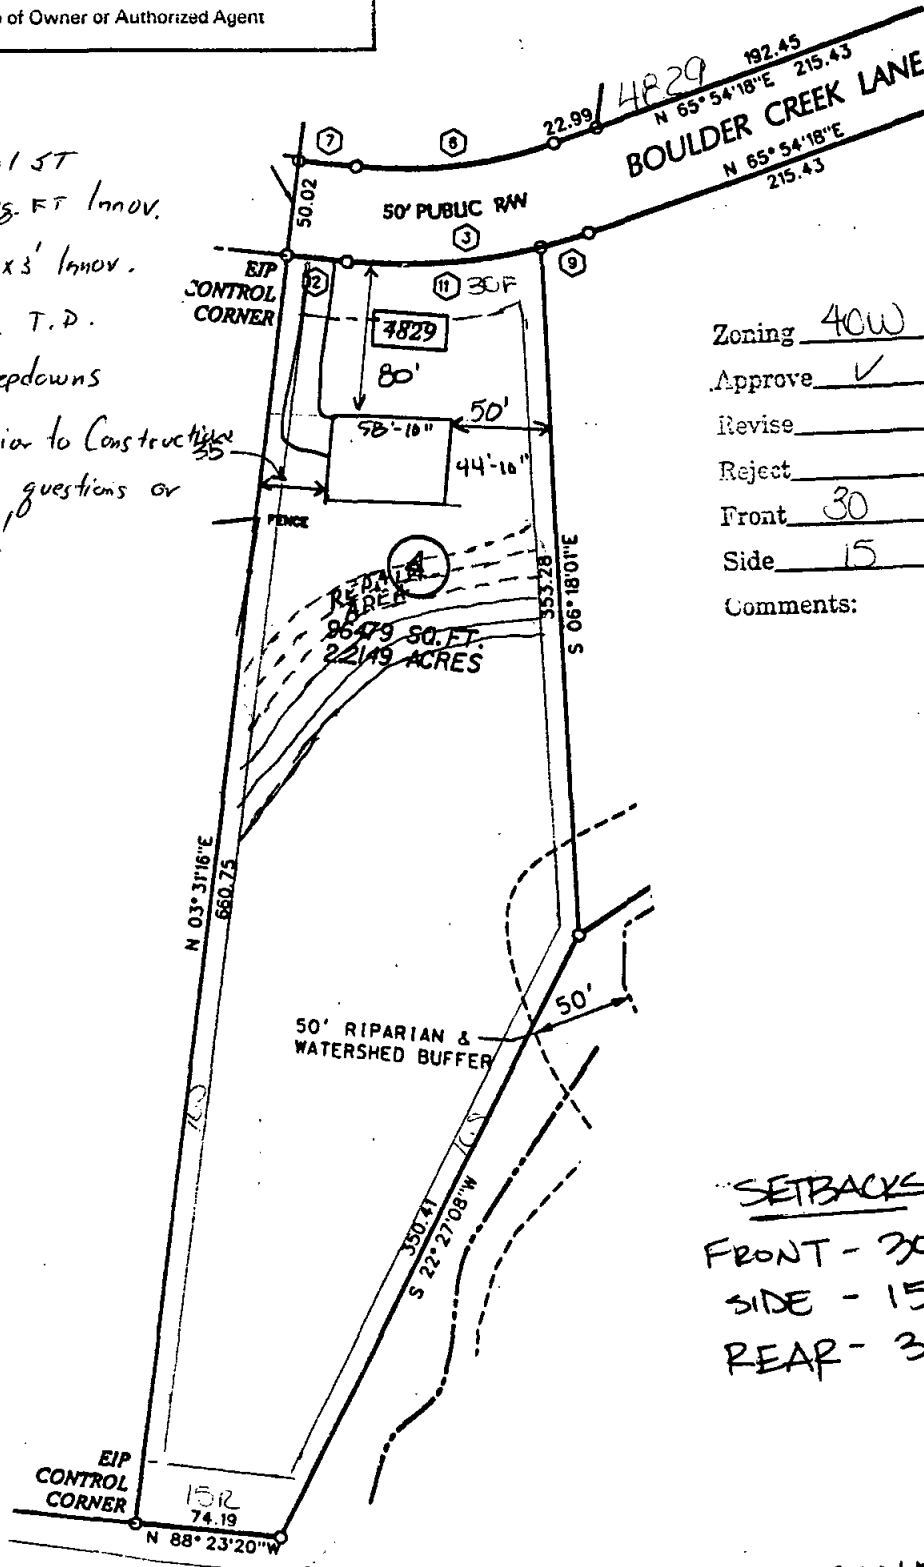

Zoning 40W By SJC
 Approve ✓ Date 12-15-00
 Revise _____ Use 101
 Reject _____ MBL _____
 Front 30 Rear 30
 Side 15 Corner _____
 Comments:

SETBACKS
 FRONT - 30'
 SIDE - 15'
 REAR - 30'

SCALE
 1" = 100'

4829 Boulder Creek Lane