

Environmental Services - Water Quality
Onsite Wastewater Scan Data Entry Form

PERMIT #: D 0 3 3 0 1 7

PIN #: 1 6 1 8 3 2 8 7 4 1

OP DATE: 0 8 1 0 3 1 2 0 0 5

SYSTEM USE:

- ☒ House
☐ Mobile Home
☐ Business
☐ Other

SEWAGE TYPE:

- ☒ Domestic
☐ Industrial

PUMP/SIPHON?:

- ☐ Yes
☒ No

PRESSURE MANIFOLD:

- ☐ Yes
☒ No

SYSTEM TYPE:

- ☐ I
☒ II
☐ III
☐ IV
☐ V
☐ VI
☐ Other

SUB TYPE:

- ☒ A
☐ B
☐ C
☐ D
☐ E
☐ F
☐ G

NBR BEDROOMS:

- ☐ 1
☐ 2
☒ 3
☐ 4
☐ 5
☐ 6
☐ Other

MAINT. SCHEDULE:

- ☐ Yes
☒ No

CERT. OPERATOR

- ☐ Yes
☒ No

GT	ST	PT	SIZE
☐	☐	☐	750
☐	☐	☐	900
☐	☒	☐	1,000
☐	☐	☐	1,200
☐	☐	☐	1,500
☐	☐	☐	1,800
☐	☐	☐	2,100
☐	☐	☐	2,500
☐	☐	☐	3,000
☐	☐	☐	4,000
☐	☐	☐	5,000
☐	☐	☐	8,000
☐	☐	☐	10,000
☐	☐	☐	Other
☒		☒	None/NA GT or PT

DRAINFIELD SIZE(SQ. FT.)

0 0 9 0 0

DRAIN TYPE:

- ☒ Stone
☐ EZ Flow
☐ Infiltrator
☐ Biodiffuser
☐ Cultec
☐ Drip
☐ Hancor
☐ Large Dia. Pipe
☐ Multi-Pipe
☐ Other

MAX DEPTH (IN.):

- ☐ 12 in. or less
☐ 18 in. or less
☒ 24 in. or less
☐ 26 in. or less
☐ 28 in. or less
☐ 30 in. or less
☐ 32 in. or less
☐ 36 in. or less
☐ Other

STONE DEPTH (IN.):

- ☐ 8 in. or less
☒ 12 in. or less
☐ 18 in. or less
☐ 24 in. or less
☐ Other

TRENCHES:

- ☒ Individual
☐ Bed

TRENCH WIDTH (IN.):

- ☐ 12 in. or less
☐ 18 in.
☐ 24 in.
☒ 36 in.
☐ 6 ft. or less
☐ 9 ft. or less
☐ Other

WAKE COUNTY DEPARTMENT OF ENVIRONMENTAL SERVICES WELL AND SEWAGE SITE LOCATION PERMIT
NO PERMIT(S) FOR CONSTRUCTION, LOCATION OR RELOCATION ACTIVITY SHALL BE ISSUED
UNTIL AN AUTHORIZATION FOR WASTEWATER SYSTEM CONSTRUCTION HAS BEEN ISSUED

PERMIT VOID IF NOT IN COMPLIANCE WITH ZONING REGULATIONS AND/ OR IF SITE IS ALTERED OR INTENDED USE CHANGED

PERMIT#: D033017 STATUS: A APP. DATE: 03/04/2005 BLDG. PERMIT#: 0052843
PIN: 1618.03 32 8741 000 TAX MAP: 0808 0000 RECORDED: Y ORIG. PERMIT#:
TOWNSHIP: 16 PANTHER BRANCH JURISDICTION: WC ZONING: R30
APPLICANT: T. G. ENNIS
1997 ZACKS MILL RD
ANGIER, NC 27501
(919) 207 - 2248
USE: HD USE: 101 ONE-FAMILY HOUSE
EXIST USE:
DISPOSAL: BEDROOMS: 3 BASEMENT: N #EMPLOYEES: 0
SITE: ADDRESS: 5208 WOODTRENT DR
SUBDIVISION: GRISSOM FARM LOT: 40 ACRES: 0.69
DIRECTION: NC 50 S OF GARNER, FIVE MILES SUBDIVISION ON R
(SEPTIC ONLY / COMM.WATER)

Well System: WATER: COMMUNITY - TYPE: EXISTING

WELL LOG INFORMATION: DEPTH: _____ CASING DEPTH: _____ YIELD: _____ STATIC LEVEL: _____ GP
WELL CONTRACTOR: _____ REG.# _____ PUMP CONTRACTOR: _____ REG.# _____
Construction Compliance GROUT APPROVED ☐ DATE _____ EHS _____
WELLHEAD APPROVED ☐ DATE _____ EHS _____
SYSTEM FINALIZED ☐ DATE _____ EHS _____

COMMENTS:

Operation Permit

DESIGN FLOW: _____ gal./min. ACTUAL FLOW: _____ INNOVATIVE LETTER: _____

INSTALLED BY: Tony Carroll INSTALLATION APPROVED BY: Carey Fulghum
PROPRIETARY SYSTEM: _____ FILTER NO: Juff Tile EF 4
COMMENTS: _____

OPERATIONS PERMIT ISSUED? Y OP DATE: 8-3-05 BY: Carey Fulghum

This permit is based in part on information provided by the homeowner or his/her representative in the application submitted for this permit. The Environmental Health Specialist is not responsible for false or misleading information contained in the application. The Environmental Health Specialist is also not responsible for concealed conditions on the property or for statements in this report that may have resulted from false or misleading statements provided to him in the application. Neither Wake County nor the Environmental Health Specialist warrants that the septic tank system will continue to function satisfactorily in the future or that the water supply will remain potable.

As Built Information:

Date: 8-3-05 Benchmark: ST Rod reading: _____ Distance to Structure: 10' ST
ST: 1000 gals ID#: STB 844 D.O.M.: 5-22-05 Elev.: 10' 3" Distance to Well: _____
PT: _____ gals ID#: _____ D.O.M.: _____ Elev.: _____
D-box/FD/PM elev.: 10' 11 1/2" Supply Line: 10 ft. Pump/Control Panel: _____
Line 1: 11' 7" _____ Date: _____
Line 2: 11' 8" _____ Date: _____
Line 3: _____ Date: _____
Line 4: _____ Date: _____
Line 5: _____ Date: _____
Distance to P/L: 10' Notes: _____

WAKE COUNTY DEPARTMENT OF ENVIRONMENTAL SERVICES WELL AND SEWAGE SITE LOCATION PERMIT
NO PERMIT(S) FOR CONSTRUCTION, LOCATION OR RELOCATION ACTIVITY SHALL BE ISSUED
UNTIL AN AUTHORIZATION FOR WASTEWATER SYSTEM CONSTRUCTION HAS BEEN ISSUED

PERMIT VOID IF NOT IN COMPLIANCE WITH ZONING REGULATIONS AND/ OR IF SITE IS ALTERED OR INTENDED USE CHANGED

PERMIT#: D033017 STATUS: A APP. DATE: 03/04/2005 BLDG. PERMIT#: 0052843
PIN: 1618.03 32 8741 000 TAX MAP: 0808 0000 RECORDED: Y ORIG. PERMIT#:
TOWNSHIP: 15 PANTHER BRANCH JURISDICTION: WC ZONING: R30
APPLICANT: T. G. ENNIS
1997 ZACKS MILL RD
ANGIER, NC 27501
(919) 207 - 2248
USE: HD USE: 101 ONE-FAMILY HOUSE
EXIST USE:
DISPOSAL: BEDROOMS: 3 BASEMENT: N #EMPLOYEES: 0 FOUND DRAIN:
SITE: ADDRESS: 6208 WOODTRENT DR
SUBDIVISION: GRISSOM FARM LOT: 40 ACRES: 0.69
DIRECTION: NC 50 S OF GARNER, FIVE MILES SUBDIVISION ON R
(SEPTIC ONLY / COMM.WATER)

IMPROVEMENT PERMIT

TANK SIZE: 1000 gal. PUMP Tank: ~~1000~~ gal. SQ FT: 900 STONE DEPTH: 12 in. MAX DEPTH LINE: 24 in.
WASTEWATER: INDIVIDUAL SEWAGE: DOMESTIC TYPE SYSTEM: II A PUMP: ~~SN~~ P/M: N
DAILY FLOW: 360 gal/day DESIGN FEE REQ?: PAID?: WATER: COMMUNITY

COMMENTS:

IP ISSUED? Y DATE: 03/14/2005 BY: (JEM)  PHONE#: 868-6410


AUTHORIZATION FOR WASTEWATER/WATER SYSTEM CONSTRUCTION

VOID SIXTY (60) MONTHS FROM DATE OF ISSUANCE

AUTHORIZATION CONDITIONS:

Contractors shall install system on contours, see attached site plan for wastewater system design and well location. No underground utilities, water lines or sprinkler systems may be located in the original system or repair areas. A septic tank filter with a riser for access is required. The wastewater system shall not be covered or placed into use until inspected by the Wake County Department of Environmental Services and an Operation Permit issued. **OTHER CONDITIONS:**
INSTALL LINES ON CONTOUR. MAINTAIN ALL SETBACKS. IF SITE OR SITE PLAN CHANGES, PERMIT IS VOID. DO NOT GRADE OR REMOVE ANY SOIL FROM SEPTIC SYSTEM OR REPAIR AREA. TAKE CARE NOT TO INSTALL UTILITIES OR IRRIGATION SYSTEM OVER SEPTIC SYSTEM OR REPAIR AREA. CALL PRIOR TO INSTALLATION WITH ANY QUESTIONS, COMMENTS OR CONCERNS.

TANK SIZE: 1000 gal. PUMP TANK: ~~1000~~ gal. SQ FT: 900 STONE DEPTH: 12 in. MAX DEPTH LINE: 24 in.
MAINT: N OPER: N L/O: Y TRENCH#: 2 LENGTH: 150 ft. WIDTH: 36 in. DESIGNER:
SUBFIELDS: _ DESIGN HEAD PRESSURE: _ DESIGN FLOW: _ gal/min DOSE VOLUME: _ gal.

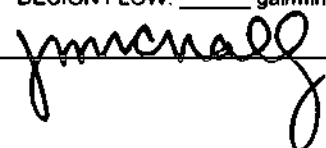CA ISSUED? Y DATE: 03/14/2005 BY: (JEM)  PHONE#: 868-6410

I certify that the location of planned or existing structure(s) are accurately shown. I understand that to create structures in accordance with the plan may require the relocation of structure(s) regardless degree of completion. I hereby grant permission to Municipal Representative the right of entry to make evaluations or inspections upon this property.

J. D. Connors

Signature of Owner or Authorized Agent

3-4-05

EIP

AS BUILT


0052843
D033017

IMPERVIOUS SURFACE AREA
HOUSE FOOTPRINT : 2923 SQ. FT.
DRIVEWAY : 1112 SQ. FT.
SIDEWALK : 332 SQ. FT.
TOTAL IMP. SURFACE : 4357 SQ. FT.
TOTAL LOT : 30,057 SQ. FT.
PERCENT IMPERVIOUS : 14.50 %

STREET ADDRESS: WOOD TRENT DRIVE
LOT: 40 GRISSOM FARM

SITE PLAN

1" = 30'

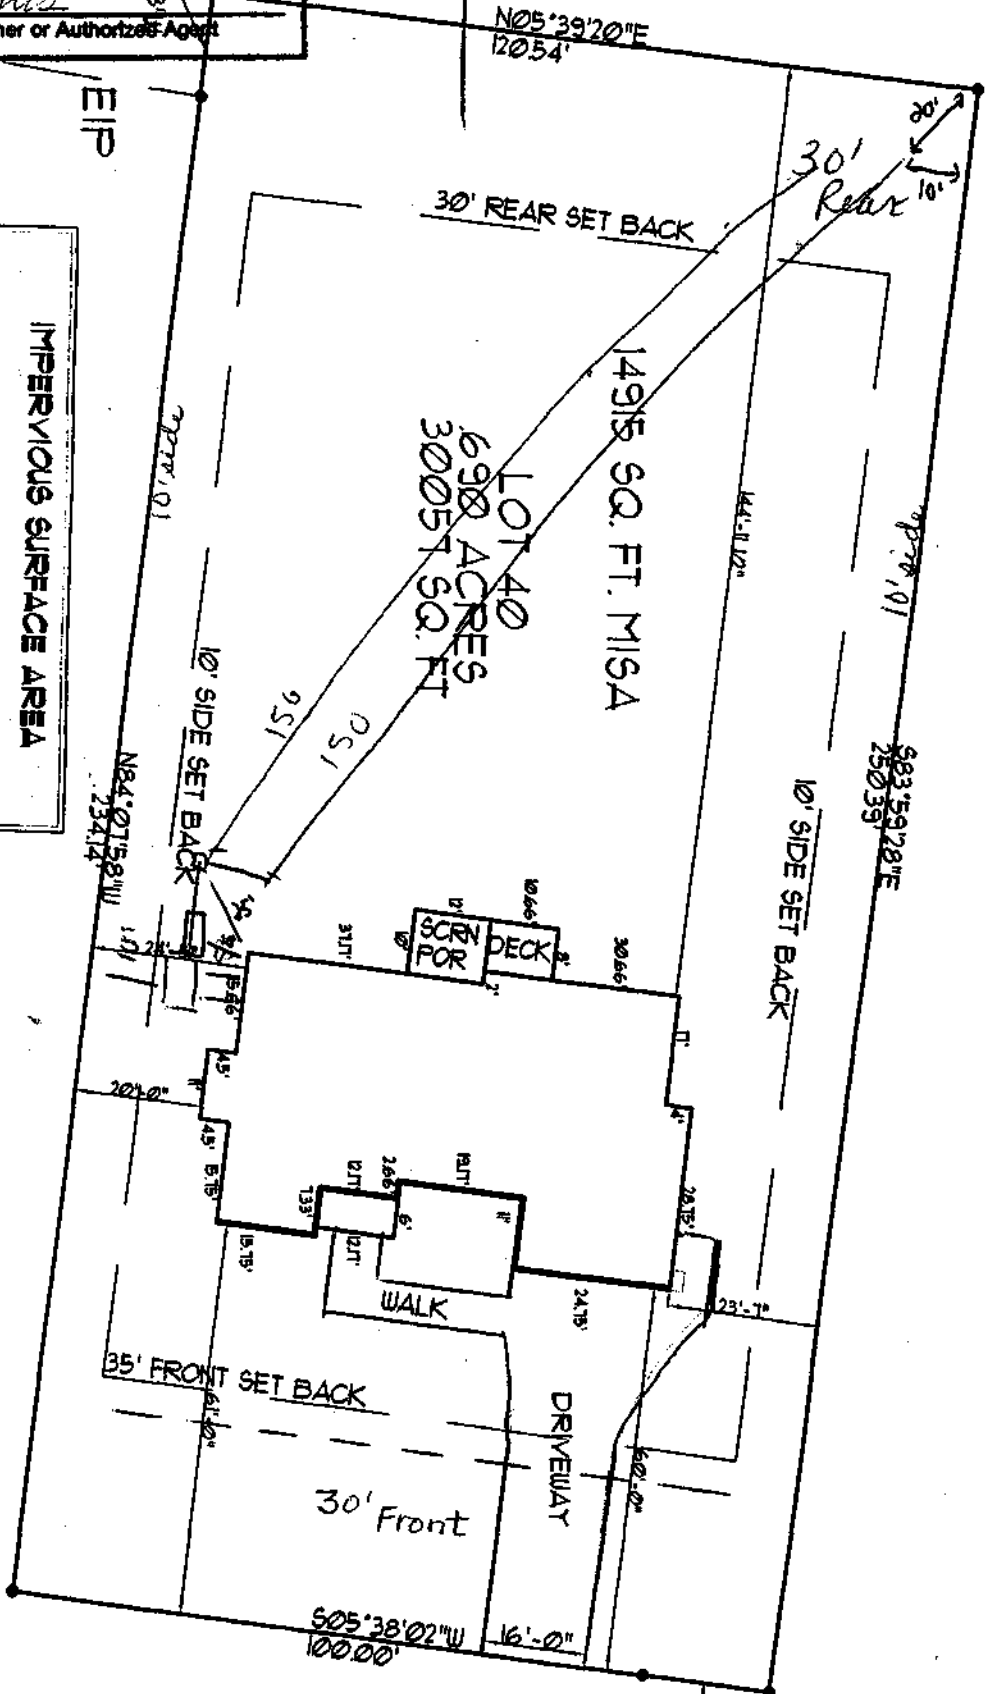

5208 WOOD TRENT DRIVE

Zoning R30 By SBC
Approve ✓ Date 3-4-05
Revised Use 101
Reject MBL
Front 30' Rear 30'
Side 10' Corner

Comments: SFD - Septic Only
Comm. WATER

PIN: 1618.03-32-8741

Signature of Owner or Authorized Agent

Signature of Owner or Authorized Agent

3-4-05

三

CA

Z

0052843
D033017

IMPERVIOUS SURFACE AREA

HOUSE FOOTPRINT	=	2923 SQ. FT.
DRIVEWAY	=	1112 SQ. FT.
<u>SIDEWALK</u>	=	<u>332 SQ. FT.</u>
TOTAL IMP. SURFACE	=	4357 SQ. FT.
TOTAL LOT	=	30,057 SQ. FT.
PERCENT IMPERVIOUS	=	14.50 %

STREET ADDRESS: WOOD TRENT DRIVE
LOT: 40 GRISCOM FARM

SITE PLAN

5208 WOOD TRENT DRIVE

Zoning R30 By SBC
 Approve ✓ Date 3-4-05
 Revises _____ Use 101
 Reject _____ MBL _____
 Front 30' Rear 30'
 Side 10' Corner _____

Comments: SFD - Septic Only
Comm. WATER

PIN: 1618.03-32-8741

2x15x3'
max depth
24"
1000 gallon
ST

* Pump may be needed.