

Environmental Services - Water Quality
Onsite Wastewater Scan Data Entry Form

PERMIT #: **B 0 I 0 3 0 8**

PIN #: **0 6 7 9 9 8 0 8 6 4**

OP DATE: **1 2 / 2 9 / 1 9 7 8**

SYSTEM USE:
☒ House
☐ Mobile Home
☐ Business
☐ Other

SEWAGE TYPE:
☒ Domestic
☐ Industrial

PUMP/SIPHON?:
☐ Yes
☒ No

PRESSURE MANIFOLD:
☐ Yes
☒ No

SYSTEM TYPE:
☐ I
☒ II
☐ III
☐ IV
☐ V
☐ VI
☐ Other

SUB TYPE:
☒ A
☐ B
☐ C
☐ D
☐ E
☐ F
☐ G

NBR BEDROOMS:
☐ 1
☐ 2
☒ 3
☐ 4
☐ 5
☐ 6
☐ Other

MAINT. SCHEDULE:
☐ Yes
☒ No

CERT. OPERATOR
☐ Yes
☒ No

GT	ST	PT	SIZE
☐	☐		750
☐	☒	☐	900
☐	☐	☐	1,000
☐	☐	☐	1,200
☐	☐	☐	1,500
☐	☐	☐	1,800
☐	☐	☐	2,100
☐	☐	☐	2,500
☐	☐	☐	3,000
☐	☐	☐	4,000
☐	☐	☐	5,000
☐	☐	☐	8,000
☐	☐	☐	10,000
☐	☐	☐	Other
☒		☒	None/NA GT or PT

DRAINFIELD SIZE(SQ. FT.)

0 1 0 0 0

DRAIN TYPE:

☒ Stone
☐ EZ Flow
☐ Infiltrator
☐ Biodiffuser
☐ Cultec
☐ Drip
☐ Hancor
☐ Large Dia. Pipe
☐ Multi-Pipe
☐ Other

MAX DEPTH (IN.):

☐ 12 in. or less
☐ 18 in. or less
☐ 24 in. or less
☐ 26 in. or less
☐ 28 in. or less
☐ 30 in. or less
☐ 32 in. or less
☐ 36 in. or less
☒ Other

STONE DEPTH (IN.):

☐ 8 in. or less
☐ 12 in. or less
☒ 18 in. or less
☐ 24 in. or less
☐ Other

TRENCHES:

☐ Individual
☒ Bed

TRENCH WIDTH (IN.):

☐ 12 in. or less
☐ 18 in.
☐ 24 in.
☐ 36 in.
☒ 6 ft. or less
☐ 9 ft. or less
☐ Other

///

PERMIT VOID IF NOT IN COMPLIANCE WITH ZONING REGULATIONS

STATE OF NEW YORK DEPARTMENT OF HEALTH
PERMIT NO. 10393
SECTION OR BLOCK NO. 11

DATE 6/21/77

LOCATION 11500 1st St. N.Y.C.

SUBDIVISION NAME Deerfield Park LOT NO. 33

GARBAGE DISPOSAL UNIT YES ☐ NO ☒

HOUSE ☒ MOBILE HOME ☐ BUSINESS ☐

NO. BEDROOMS 3 LOT AREA 11.5 300


SIZE OF TANK 1000 gal.

NITRIFICATION LINE 1000 (105 X 10) sq. ft.

DEPTH OF STONE IN LINES 18" 18" ☐

WATER SUPPLY: INDIVIDUAL ☐ PUBLIC ☒

* PERMIT VOID 12 MONTHS FROM DATE OF ISSUANCE.

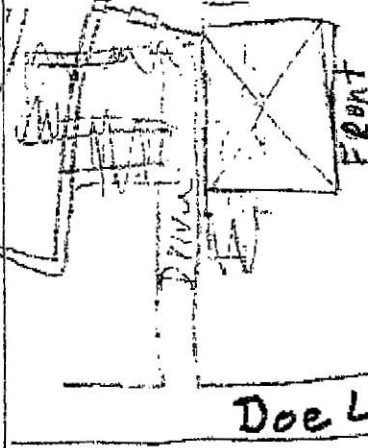

LAYOUT BY James H. McLaughlin

DATE 12-29-76

INSTALLED BY N.L. Atkins

APPROVED BY By Ward