

Environmental Services - Water Quality
Onsite Wastewater Scan Data Entry Form

PERMIT #: 0001738

PIN #: 1861227038

OP DATE: 0810611997

SYSTEM USE:

- ☒ House
☐ Mobile Home
☐ Business
☐ Other

SEWAGE TYPE:

- ☒ Domestic
☐ Industrial

PUMP/SIPHON?:

- ☐ Yes
☒ No

PRESSURE MANIFOLD:

- ☐ Yes
☒ No

SYSTEM TYPE:

- ☐ I
☒ II
☐ III
☐ IV
☐ V
☐ VI
☐ Other

SUB TYPE:

- ☒ A
☐ B
☐ C
☐ D
☐ E
☐ F
☐ G

NBR BEDROOMS:

- ☐ 1
☐ 2
☐ 3
☒ 4
☐ 5
☐ 6
☐ Other

MAINT. SCHEDULE:

- ☐ Yes
☒ No

CERT. OPERATOR

- ☐ Yes
☒ No

GT ST PT

- | | | | |
|-------------------------------------|-------------------------------------|-------------------------------------|------------------|
| ☐ | ☐ | ☐ | 750 |
| ☐ | ☐ | ☐ | 900 |
| ☐ | ☐ | ☐ | 1,000 |
| ☐ | ☒ | ☐ | 1,200 |
| ☐ | ☐ | ☐ | 1,500 |
| ☐ | ☐ | ☐ | 1,800 |
| ☐ | ☐ | ☐ | 2,100 |
| ☐ | ☐ | ☐ | 2,500 |
| ☐ | ☐ | ☐ | 3,000 |
| ☐ | ☐ | ☐ | 4,000 |
| ☐ | ☐ | ☐ | 5,000 |
| ☐ | ☐ | ☐ | 8,000 |
| ☐ | ☐ | ☐ | 10,000 |
| ☐ | ☐ | ☐ | Other |
| ☒ | | ☒ | None/NA GT or PT |

DRAINFIELD SIZE(SQ. FT.)

01350

DRAIN TYPE:

- ☒ Stone
☐ EZ Flow
☐ Infiltrator
☐ Biodiffuser
☐ Cultec
☐ Drip
☐ Hancor
☐ Large Dia. Pipe
☐ Multi-Pipe
☐ Other

MAX DEPTH (IN.):

- ☐ 12 in. or less
☒ 18 in. or less
☐ 24 in. or less
☐ 26 in. or less
☐ 28 in. or less
☐ 30 in. or less
☐ 32 in. or less
☐ 36 in. or less
☐ Other

STONE DEPTH (IN.):

- ☐ 8 in. or less
☒ 12 in. or less
☐ 18 in. or less
☐ 24 in. or less
☐ Other

TRENCHES:

- ☒ Individual
☐ Bed

TRENCH WIDTH (IN.):

- ☐ 12 in. or less
☐ 18 in.
☐ 24 in.
☒ 36 in.
☐ 6 ft. or less
☐ 9 ft. or less
☐ Other

B.W. 1/6/14

WAKE COUNTY HEALTH DEPARTMENT WELL AND SEWAGE SITE, LOCATION PERMITNO PERMIT(S) FOR CONSTRUCTION, LOCATION OR RELOCATION ACTIVITY SHALL BE ISSUED
UNTIL AN AUTHORIZATION FOR WASTEWATER SYSTEM CONSTRUCTION HAS BEEN ISSUEDPin # 1861, 03227038 Project # 0962764Improvement Permit D1738

Tax Map No. _____ Parcel No. _____

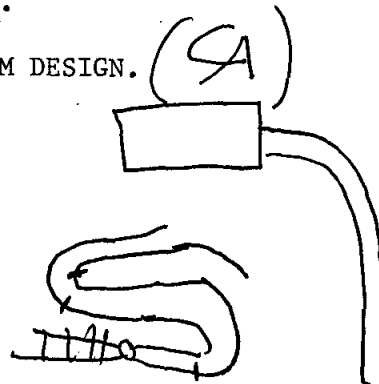
Zoning Wake Township W. F.

Well Permit No. _____

Operation Permit ☒Owner/Contractor: Testa ConstDate: 6-3-96Location/Address: 5300 Milldam Rd [US 401N, TL Averette Rd]
TL Milldam site on rd S.R. # _____Subdivision Name: Millbrae Lot No. (44) Section or Block No. _____**Preliminary Layout**

SEE ATTACHED PLOT PLAN FOR WASTEWATER DISPOSAL SITE.

SEE CONSTRUCTION AUTHORIZATION FOR WASTEWATER SYSTEM DESIGN.

Final Layout**Sewage System Specifications**Repair ☐ Original Permit No. _____Garbage Disposal Unit Yes ☐ No ☒ millsHouse ☒ Mobile Home ☐ Business ☐ 1200No. of Bedrooms 4 Lot Area 2.84 ACSize of Tank 1200 gal.Wastewater: Sewage ☒ Industrial ☐ Comments: _____Nitrification Line 1350 sq. ft.Depth of Stone: 12" ☐ Max Depth of Trenches: 18" in.Riser and Baffle Required ☒ Pump Required ☒

■ Permit void if not in compliance with zoning regulations

■ Permits may be voided if site is altered or intended use changed

Layout by: D.R. ParrellDate: 8/6/97 Installed By: Frank Pearce Approved By: D.R. Parrell**Well System**Individual ☐ Semi-Public ☐ Public ☒New ☐ Replacement ☐ Repair ☐Fee Paid: Yes ☐ No ☐Construction Compliance Yes ☐ No ☐Site Approved ☐Well Head Approved ☐Grouting Approved ☐**Date Inspected****Sanitarian****Bacteriological Results**

Initial Sample: _____ Date: _____

* Re-Sample #1 _____ Date: _____

* Re-Sample #2 _____ Date: _____

* Re-chlorination as required ☐ Yes ☐ No

* Fees for all resamples

All checks payable to: **Wake County Health Department****Final Inspection**

Yes No

Required Slab ☐ ☐Chlorinated ☐ ☐Required Certificate ☐ ☐Variance (Explain) ☐ ☐WCHD I.D. Affixed ☐ ☐Sample Collected ☐ ☐

Comments: _____

Well Installed By: _____

Date System Finalized _____

Sanitarian _____

This report is based in part on information provided by the homeowner or his/her representative in the application submitted for this permit. The sanitarian is not responsible for false or misleading information contained in the application. The sanitarian is also not responsible for concealed conditions on the property or for statements in this report that may have resulted from false or misleading statements provided to him in the application. Neither Wake County nor the sanitarian warrants that the septic tank system will continue to function satisfactorily in the future or that the water supply will remain potable.

AUTHORIZATION FOR WASTEWATER SYSTEM CONSTRUCTION

CA

VOID SIXTY(60) MONTHS FROM DATE OF ISSUANCE

0962764

DATE:	<u>6-3-96</u>	IMPROVEMENT PERMIT NO.:	<u>D 1738</u>
TAX MAP NO.:		PARCEL NO.:	
		PIN NO.:	<u>1861.03227038</u>
OWNER/CONTRACTOR:	<u>Testa Const</u>		
LOCATION/ADDRESS:	<u>5300 Milldam Road [US 401</u> <u>Tr Averette Rd, cross NC 96, TR Milldam</u> <u>Rd site on det 5</u>		
SUBDIVISION NAME:	<u>Millrace</u>		
LOT NO.:	<u>44</u>	SECTION OR BLOCK NO.:	
AUTHORIZATION ISSUED BY: _____			

PIN #:

N,

AUTHORIZATION CONDITIONS

- 1 WASTEWATER SYSTEM CONSTRUCTION AND INSTALLATION MUST MEET ALL CONDITIONS AND SPECIFICATIONS AS SET FORTH IN IMPROVEMENT PERMIT NO. D 1738 AND THE ATTACHED SITE PLAN WITH SYSTEM DETAILS. CONSTRUCTION AND INSTALLATION MUST ALSO MEET ALL REQUIREMENTS SET FORTH IN THE "REGULATIONS GOVERNING SANITARY SEWAGE COLLECTION, TREATMENT, AND DISPOSAL IN WAKE COUNTY" AND ANY OTHER APPLICABLE RULES AND LAWS.

- 2 THE WASTEWATER SYSTEM SHALL NOT BE COVERED OR PLACED INTO USE UNTIL INSPECTED BY THE WAKE COUNTY DEPARTMENT OF HEALTH AND AN OPERATION PERMIT ISSUED.

- 3 ANY ALTERATION IN SITE OR SOIL CONDITIONS (INCLUDING LOCATION OF STRUCTURES AND APPURTENANCES) OR MODIFICATION IN USE, DESIGN WASTEWATER FLOW, OR WASTEWATER CHARACTERISTICS AS SPECIFIED IN THE ASSOCIATED IMPROVEMENT PERMIT AND APPLICATION, MAY VOID THIS AUTHORIZATION AND ASSOCIATED PERMITS.

- 4 OTHER CONDITIONS: Conventional Pump:
2 conventional trenches: 18"
deep maximum 3 wide, 225' long. Contractor
establish and follow contour, use 1200
gallon septic tank and 1200 gallon pump tank

Millrace Lot 44

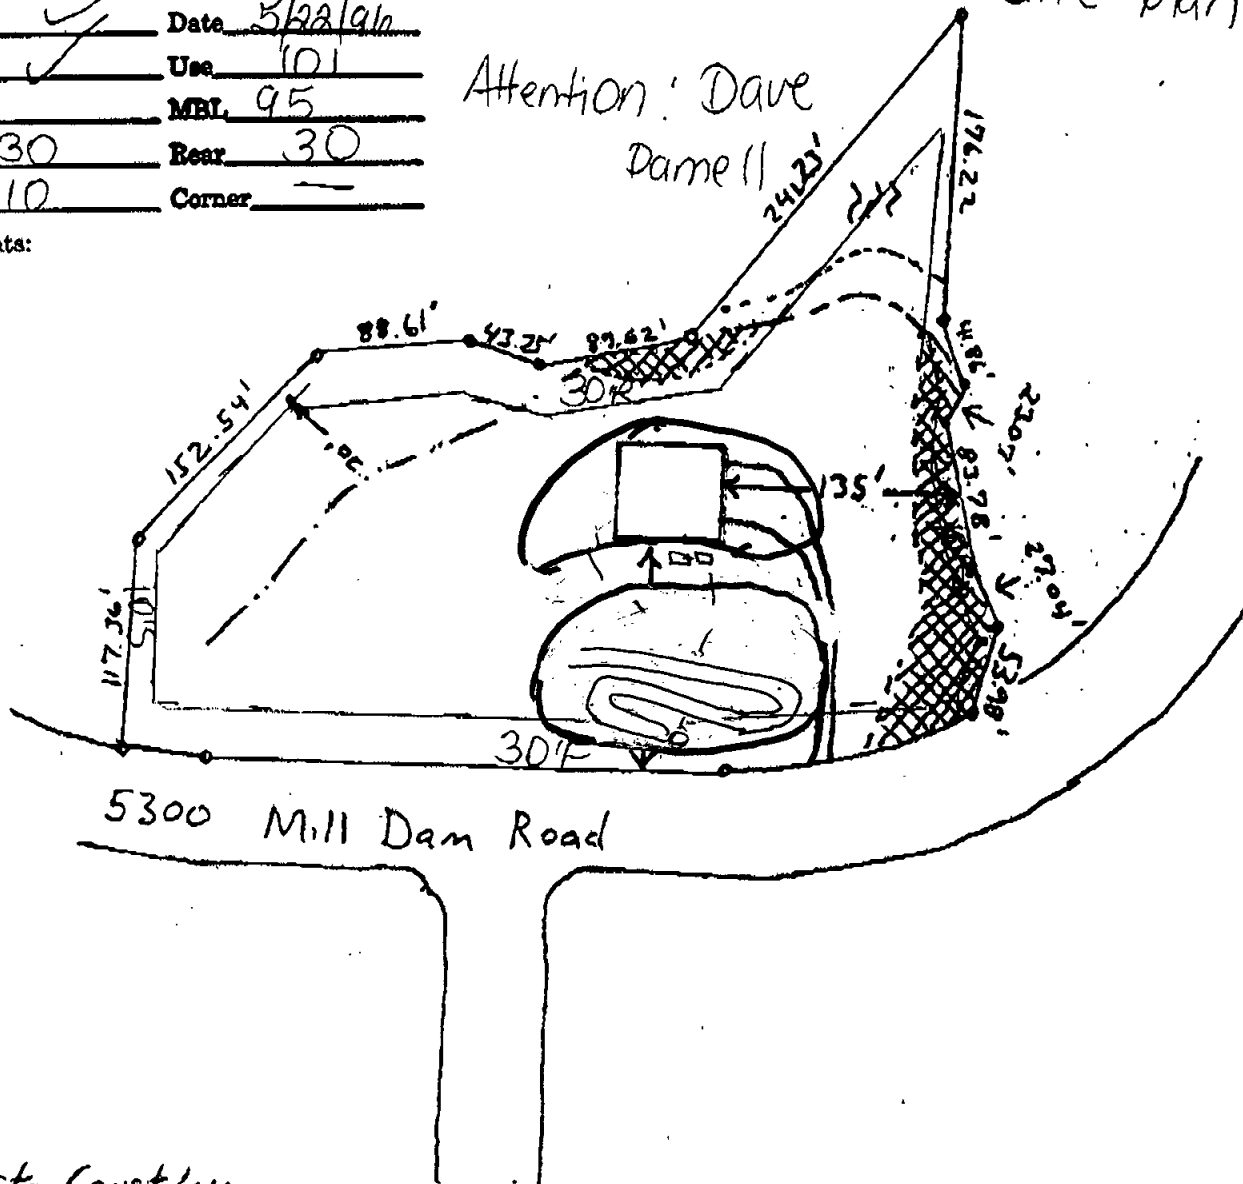
0962764

Relocation

Revised Site plan

Zoning B-30 By TH
 Approve ✓ Date 5/22/96
 Revise ✓ Use 101
 Reject MBL 95
 Front 30 Rear 30
 Side 10 Corner

Comments:

Attention: Dave
Daneil

Testa Const Inc.

Robert Testa

O-266-2315

M-612-8775

Fax-266-0903

I certify that the location of this structure is accurately shown. Failure to locate this structure in accordance with this plot plan could require relocation of the structure regardless of its degree of completion:

X

Signature

Check one: () Owner () Builder/Contractor () Other

Date

Millrace Ph II

Tax Map 207

Book of Maps 1995

Page 821