

Environmental Services - Water Quality
Onsite Wastewater Scan Data Entry Form

PERMIT #: C010083

PIN #: 0791320455

OP DATE: 0212711991

SYSTEM USE:

- ☒ House
☐ Mobile Home
☐ Business
☐ Other

SEWAGE TYPE:

- ☒ Domestic
☐ Industrial

PUMP/SIPHON?:

- ☐ Yes
☒ No

PRESSURE MANIFOLD:

- ☐ Yes
☒ No

SYSTEM TYPE:

- ☐ I
☒ II
☐ III
☐ IV
☐ V
☐ VI
☐ Other

SUB TYPE:

- ☒ A
☐ B
☐ C
☐ D
☐ E
☐ F
☐ G

NBR BEDROOMS:

- ☐ 1
☐ 2
☒ 3
☐ 4
☐ 5
☐ 6
☐ Other

MAINT. SCHEDULE:

- ☐ Yes
☒ No

CERT. OPERATOR

- ☐ Yes
☒ No

GT ST PT SIZE

- | | | | |
|-------------------------------------|-------------------------------------|-------------------------------------|------------------|
| ☐ | ☐ | | 750 |
| ☐ | ☐ | ☐ | 900 |
| ☐ | ☒ | ☐ | 1,000 |
| ☐ | ☐ | ☐ | 1,200 |
| ☐ | ☐ | ☐ | 1,500 |
| ☐ | ☐ | ☐ | 1,800 |
| ☐ | ☐ | ☐ | 2,100 |
| ☐ | ☐ | ☐ | 2,500 |
| ☐ | ☐ | ☐ | 3,000 |
| ☐ | ☐ | ☐ | 4,000 |
| ☐ | ☐ | ☐ | 5,000 |
| ☐ | ☐ | ☐ | 8,000 |
| ☐ | ☐ | ☐ | 10,000 |
| ☐ | ☐ | ☐ | Other |
| ☒ | | ☒ | None/NA GT or PT |

DRAINFIELD SIZE(SQ. FT.)

01200

DRAIN TYPE:

- ☒ Stone
☐ EZ Flow
☐ Infiltrator
☐ Biodiffuser
☐ Cultec
☐ Drip
☐ Hancor
☐ Large Dia. Pipe
☐ Multi-Pipe
☐ Other

MAX DEPTH (IN.):

- ☐ 12 in. or less
☐ 18 in. or less
☒ 24 in. or less
☐ 26 in. or less
☐ 28 in. or less
☐ 30 in. or less
☐ 32 in. or less
☐ 36 in. or less
☐ Other

STONE DEPTH (IN.):

- ☐ 8 in. or less
☒ 12 in. or less
☐ 18 in. or less
☐ 24 in. or less
☐ Other

TRENCHES:

- ☒ Individual
☐ Bed

TRENCH WIDTH (IN.):

- ☐ 12 in. or less
☐ 18 in.
☐ 24 in.
☒ 36 in.
☐ 6 ft. or less
☐ 9 ft. or less
☐ Other

MJ
5/11/15

0791320455

WAKE COUNTY HEALTH DEPARTMENT WELL AND SEWAGE SITE LOCATION PERMIT

Tax Map No. 478 Parcel No. 409Improvement Permit 10083
Well Permit No. CContractor: Southern Custom Homes

Operation Permit []

Owner: _____

Date: 10-5-90Location/Address: 2549 Whippeltree DrLake Wheeler Rd 510 on LtS.R. # 136Subdivision Name: Greenbrook FarmsLot No. 202

Section or Block No. _____

Zoning: WAKE Township: Swift Creek*May be Void if Intended Use Changes Whippeltree Dr

Sewage System

Repair [] Original Permit No. _____

Garbage Disposal Unit Yes [] No [x]

House [x] Mobile Home [] Business []

No. Bedrooms 3 Lot Area 1.25 ac

Size of Tank _____ 1000 gal.

Nitrification Line 213 x 240 1200 sq. ft.Depth of Stone: 12" [x] Max. Depth of Trenches: 24 in.

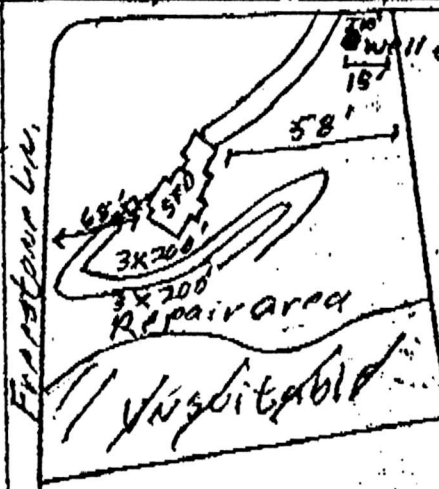
Riser and Baffle Required [] Pump Required []

60 Improvement Permit

*Permit Void 36 months from date of issuance

*Permit Void if not in compliance with zoning regulations

*Permit may be voided if site alterations made

Layout By: Edward J. Wilson

*Stubout
Shallow

*Maximum
Trench
Depth
24 in.

*Follow
Contour

2-27-91

Woody Wilson

Karen P. Hight, RS

Date

Installed By

Approved By

Well System

Individual [x] Semi-Public [] Public []

New [] Replacement [] Repair []

Fee Paid Yes [x] No []

Construction Compliance Yes No

Site Approved [x] []

Well Head Approved [x] []

Grouting Approved [x] []

10/10/90

Date Inspected

Sanitarian

Final Inspection Yes No

Required Slab [x] []

Chlorinated [x] []

Required Certificate [x] []

Variance (Explain) [] [x]

WCHD I.D. Affixed 2322 [x] []

Sample Collected [x] []

**Well permit void 36 months from issuance date

Bacteriological Results

Initial Sample: _____ Date: _____

*Re-sample #1 _____ Date: _____

*Re-sample #2 _____ Date: _____

Re-chlorination as required * Yes [] No []

Comments: _____

\$10.00 fee for all re-samples

All checks payable to: Wake County Health Department

Well Installed By: Council Well

Date System Finalized _____ Sanitarian _____

This report is based in part on information provided by the homeowner or his/her representative in the application submitted for this permit. The sanitarian is not responsible for false or misleading information contained in the application. The sanitarian is also not responsible for concealed conditions on the property or for statements in this report that may have resulted from false or misleading statements provided to him in the application. Neither Wake County nor the sanitarian warrants that the septic tank system will continue to function satisfactorily in the future or that the water supply will remain potable.