

WARREN COUNTY HEALTH DEPARTMENT

540 West Ridgeway Street

Warrenton, N. C. 27589

Phone (919) 257-1185

8-29-95 gpd

11:45

IMPROVEMENTS PERMIT

☒ Suitable
☐ Provisionally Suitable
☐ Upgrading of Existing System
☐ Repair of Existing System

Fee: 35.00
Paid: 35.00
Permit No 0243

Owner: John Brown Phone: 252-2920

Address: Pl. 2, Box 171, Warrenton, NC 27589

Subdivision Name: N/A Lot # Block # Sect #

Direction To Lot (RPR#) 50420 401 101 1020 1020 - 50 1020 50100
101 on Right 2 1/2 mi

Land Use: SFD No. Of Bedrooms 3 No. Of People 4 Other

Water Supply: private well Distance From Well And/Or Water Lines 100 ft

Design Daily Flow Of Sewage 300 Gallons; Kitchen Garbage Grinder no Other

Septic Tank Capacity 1000 Gallons; Nitrification Field 900 ft² Square Feet

Maximum Trench Depth 36 Inches; Artificial Drainage Required (If Yes See Attached Plan)

COMMENTS: 2 Septic tanks auto to locate well, drawing of
septic system. 100 problems noted

The Septic Tank System and any other improvements that are made shall be installed as shown in the Site Sketch Plan. No changes shall be made without approval from the Health Department.

Any variations from the conditions and requirements previously described will void this permit. This permit shall be valid for 36 months from the date of issue. This is an official document. Please retain with other valuable papers.

DATE: 7-11-87 SANITARIAN John Brown
SEPTIC TANK APPROVAL


DATE: 7-24-87 SANITARIAN Mary G. Butler
CERTIFICATE OF COMPLETION

CONTRACTOR: C.G. 21510

NOTE: The Septic Tank, nitrification and drain lines must be inspected by a representative of the Health Department before they are covered.

The signing of this certificate shall indicate that this system has been installed in compliance with the current law & rules for sanitary sewage collection, treatment and disposal set forth in Article 11 of General Statute 130A. Section .1900 of the North Carolina Administrative Code Title 10, Department of Human Resources Chapter 10 Health Services, Environmental Health subchapter 10A Sanitation and shall in no way be a guarantee that the septic tank system will function satisfactorily for any given period of time.


Site Sketch Plan

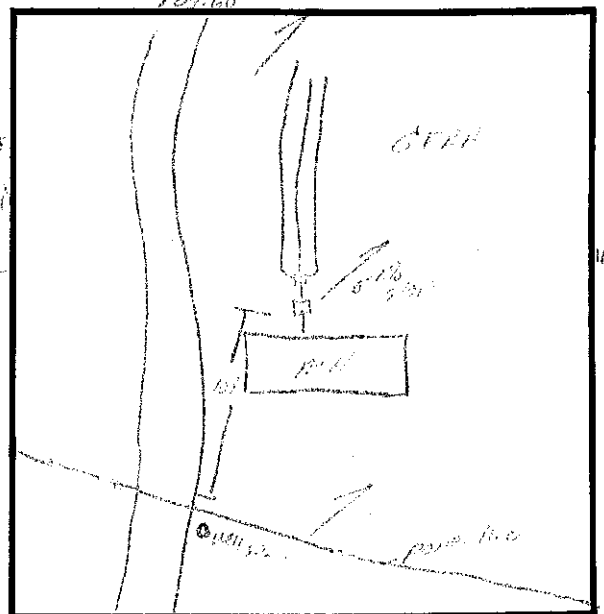

Front Of House

IOLA D. BROWN		TAX MAP:		ZONE:
COUNTY: WARREN		SHOCCO		STATE: NORTH CAROLINA
DATE: AUG. 15, 1986		SCALE: 1" = 40'		REVISED:
SURVEYED BY: HMM		DRAWN BY: HMM		
HARRY M. WILLIAMS, III REGISTERED LAND SURVEYOR L-2825 ROUTE 3, BOX 92-A WARRENTON, N. C. 27589				

BLOUNT WILLIAMS
DEED BOOK 158 PAGE 422

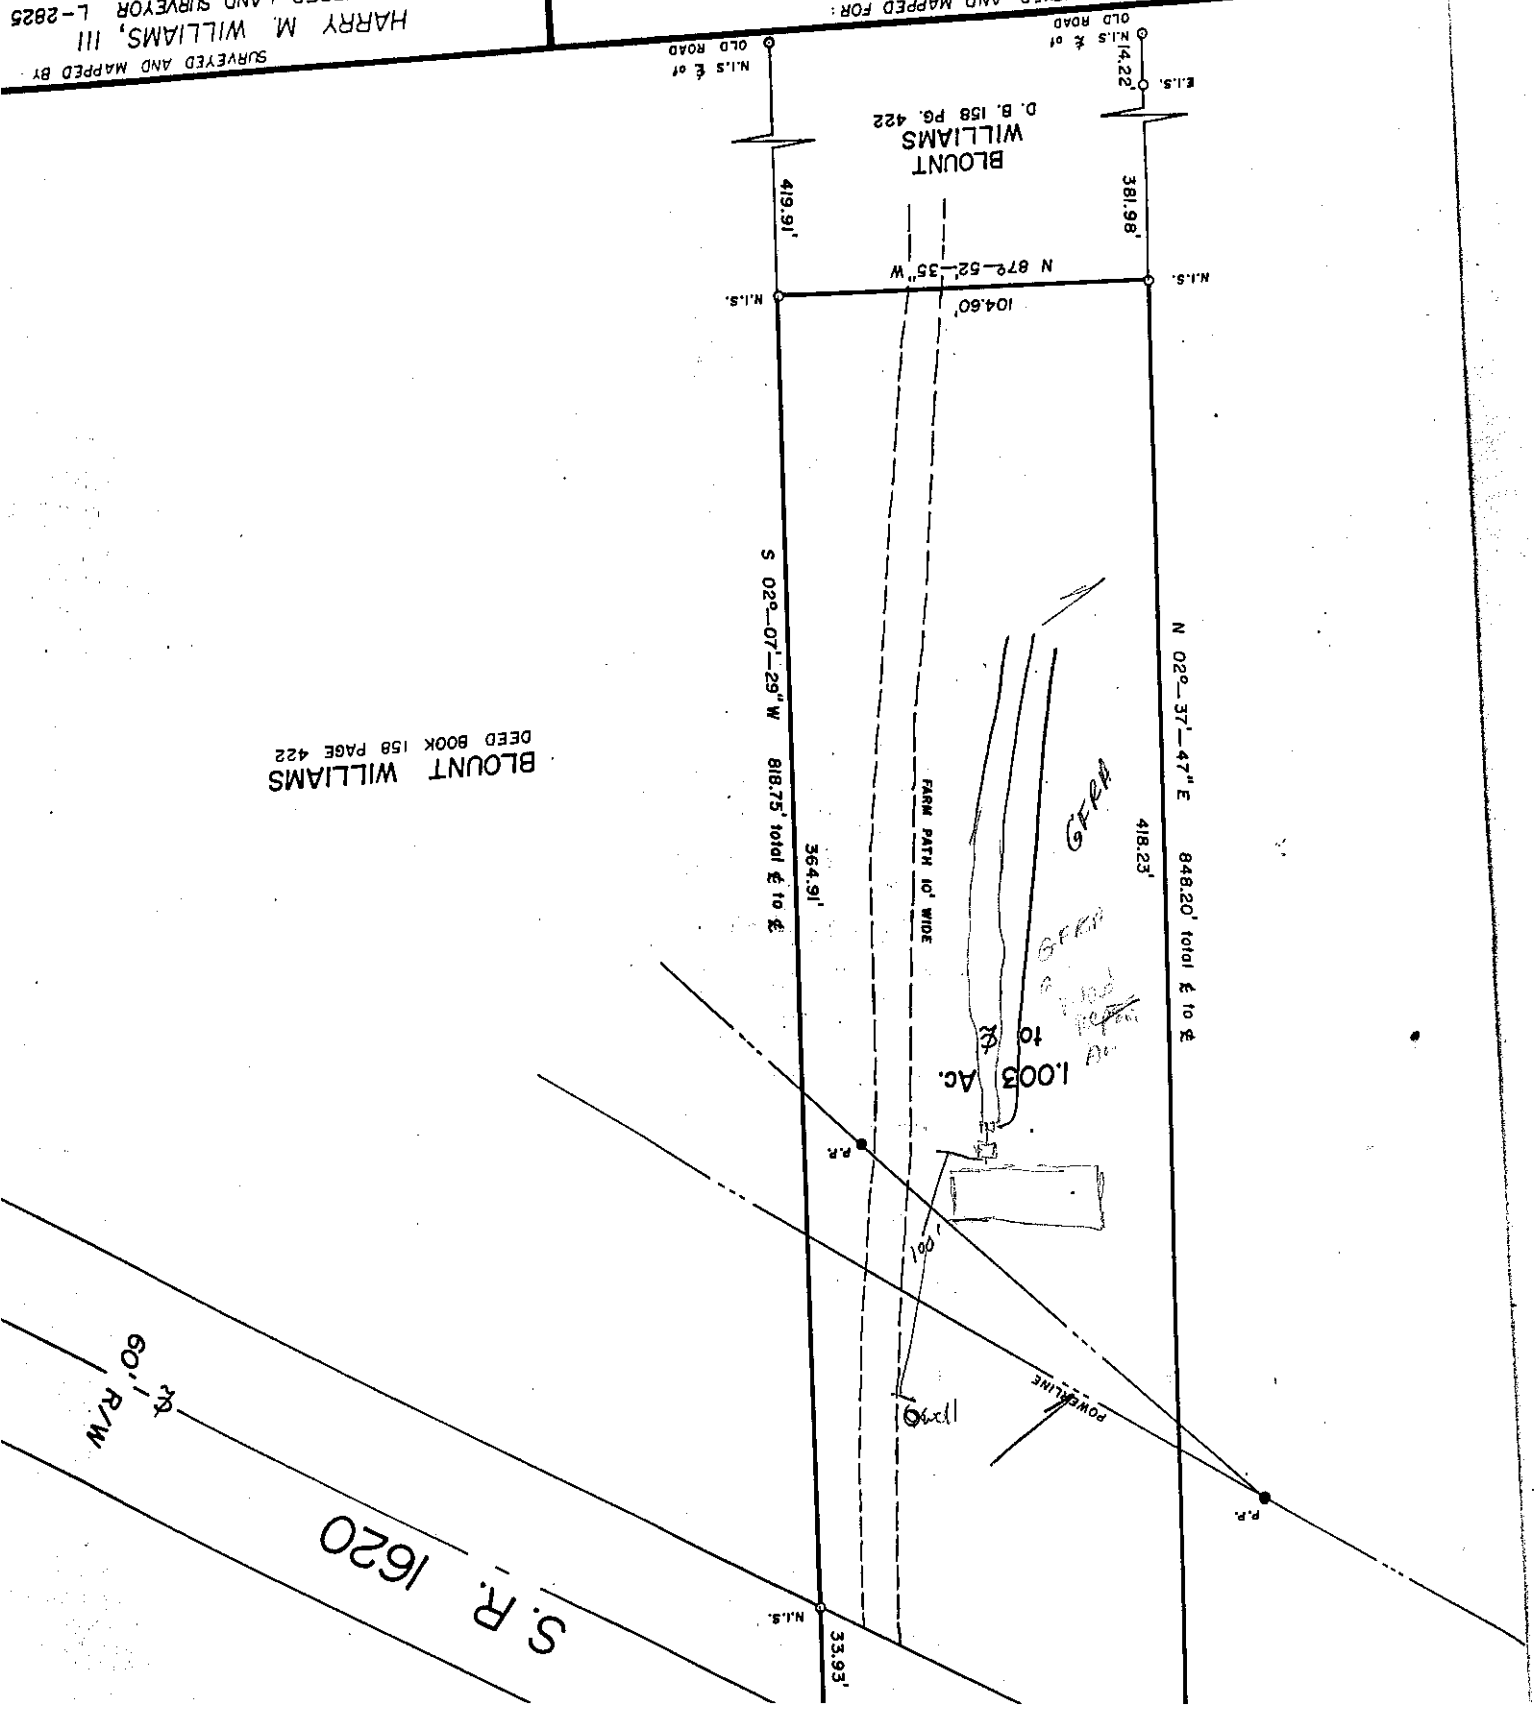

WARREN COUNTY HEALTH DEPARTMENT
540 W. RIDGEWAY ST.
WARRENTON, NC 27589
PHONE (919) 257-1185

SITE EVALUATION FORM

OWNER: Toliz Brown

STATE ROAD # 1620

FACTORS	AREA 1	AREA 2	AREA 3	AREA 4
1. SLOPE (%)	S PS U 0-2%	S PS U	S PS U	S PS U
2. SOIL TEXTURE (12-36 IN.) (SANDY, LOAMY CLAYEY, NOTE 2:1 CLAY)	S PS U 2:1 SCL Fertile	S PS U	S PS U	S PS U
3. SOIL STRUCTURE (12-36 IN.) (CLAYEY SOILS)	S PS U 5AB	S PS U	S PS U	S PS U
4. SOIL DEPTH (IN.)	S PS U 36" +	S PS U	S PS U	S PS U
5. RESTRICTIVE HORIZONS (IN.) (IMPERVIOUS STRATA, ROCK)	S PS U none noted	S PS U	S PS U	S PS U
6. SOIL DRAINAGE/GROUNDWATER (EXTERNAL & INTERNAL)	S PS U Ext 30" Int 10"	S PS U	S PS U	S PS U
7. SOIL PERMEABILITY (PERCOLATION RATE)	S PS U .36 - .4	S PS U	S PS U	S PS U
8. OTHER (SPECIFY)	S PS U	S PS U	S PS U	S PS U
9. SITE CLASSIFICATION*	S PS U	S PS U	S PS U	S PS U

S-SUITABLE PS-PROVISIONALLY SUITABLE U-UNSUITABLE

*SEE DIAGRAM ON BACK (INCLUDE: SOIL AREAS, PROPERTY LINES, ROADS, STREAMS,
GULLIES, WET AREAS, FILL AREAS, WATER BODIES, SLOPE
PATTERNS, ETC.)

RECOMMENDATIONS/COMMENTS:

DESCRIBED BY:

TITLE:

DATE: