

PERMIT NUMBER 2112

GRANVILLE-VANCE DISTRICT HEALTH DEPARTMENT IMPROVEMENT AND OPERATION PERMITS

COUNTY:	TAX NO.	TYPE OF ESTABLISHMENTS			*THIS PERMIT SHALL BE ACCOMPANIED BY A LAYOUT SHOWN ON A PLAT, INCLUDING SYSTEM REQUIREMENTS.
APPLICANT: Wade Journey Homes	SR. NO.	RESIDENCE ☒	NUMBER OF BEDROOMS:	NUMBER OF OCCUPANTS:	
	APPLICANT'S NAME & ADDRESS:	BUSINESS ☐	4	8 MAX	
		OTHER ☐			
PROPERTY ADDRESS/LOCATION:	WATER SUPPLY	WELL ☒	OTHER ☐		*THIS IMPROVEMENT PERMIT IS SUBJECT TO REVOCATION IF THE INTENDED USES CHANGE FROM THOSE SHOWN ON THE IMPROVEMENT PERMIT. CHANGES SHALL REQUIRE HEALTH DEPARTMENT APPROVAL.
	4537 Gresham Dr.	PUBLIC ☐			
SUBDIVISION:	TYPE OF WASTEWATER SYSTEM	INITIAL INSTALLATION	REPAIR		
LOT NUMBER:	DESIGN FLOW:				
REFERENCE SKETCH (SEE PLAT FOR DETAILS)	LTAR:				
	4537 Gresham Dr.				
French Drain 30" deep	ABSORPTION AREA:				
Risers on tanks	TRENCH WIDTH:				
NEMA 4x Control panel with alarm	TRENCH DEPTH:				
1/2" - 3/4" taps with adjustment valves	TRENCH SPACING:				
	TOTAL TRENCH LENGTH:				
	NUMBER OF TRENCHES:				
	GRAVEL DEPTH:				
	TANK SIZE:				
	PUMP TANK SIZE:				
	DISTRIBUTION DEVICE:				

PERMIT VALID FOR: 5 YEARS
YES ☒ NO ☐

NO EXPIRATION
YES ☐ NO ☒

IMPROVEMENT PERMIT

DATE: 9-6-17

FOR: Wade Journey Homes
ISSUED BY: Adam Corbin

CONSTRUCTION AUTHORIZATION FOR IMPROVEMENT PERMIT# 9179

Unless otherwise indicated, the same conditions above apply regarding system type, layout, location and installation requirements.
(The wastewater system cannot be installed until authorization is signed)

Comments:

Date: 9-6-17 Environmental Health Specialist: Adam Corbin

Construction Authorization Addendum ☐ Yes ☒ No

OPERATION PERMIT

DATE: 6-25-19 (tanks & lines) AWC

SYSTEM INSTALLED BY: David Brantley & Son

12-8-19 (pump)

ISSUED BY:

PERFORMANCE, MONITORING, MAINTENANCE AND OPERATION
AS REQUIRED BY RULE .1961

Granville - Vance District Health Department
Environmental Health

Pin _____

Permit Number 9179

___ Improvement Permit

___ Construction Authorization

Final Sketch

Traditions Builder
Applicants Name


Gresham Crossing / 1-1-3
Subdivision - Section + Lot

Physical Address: 4537 Gresham Dr

Number of Bedrooms 4

Brantley
System Installer

6-25-19
Date

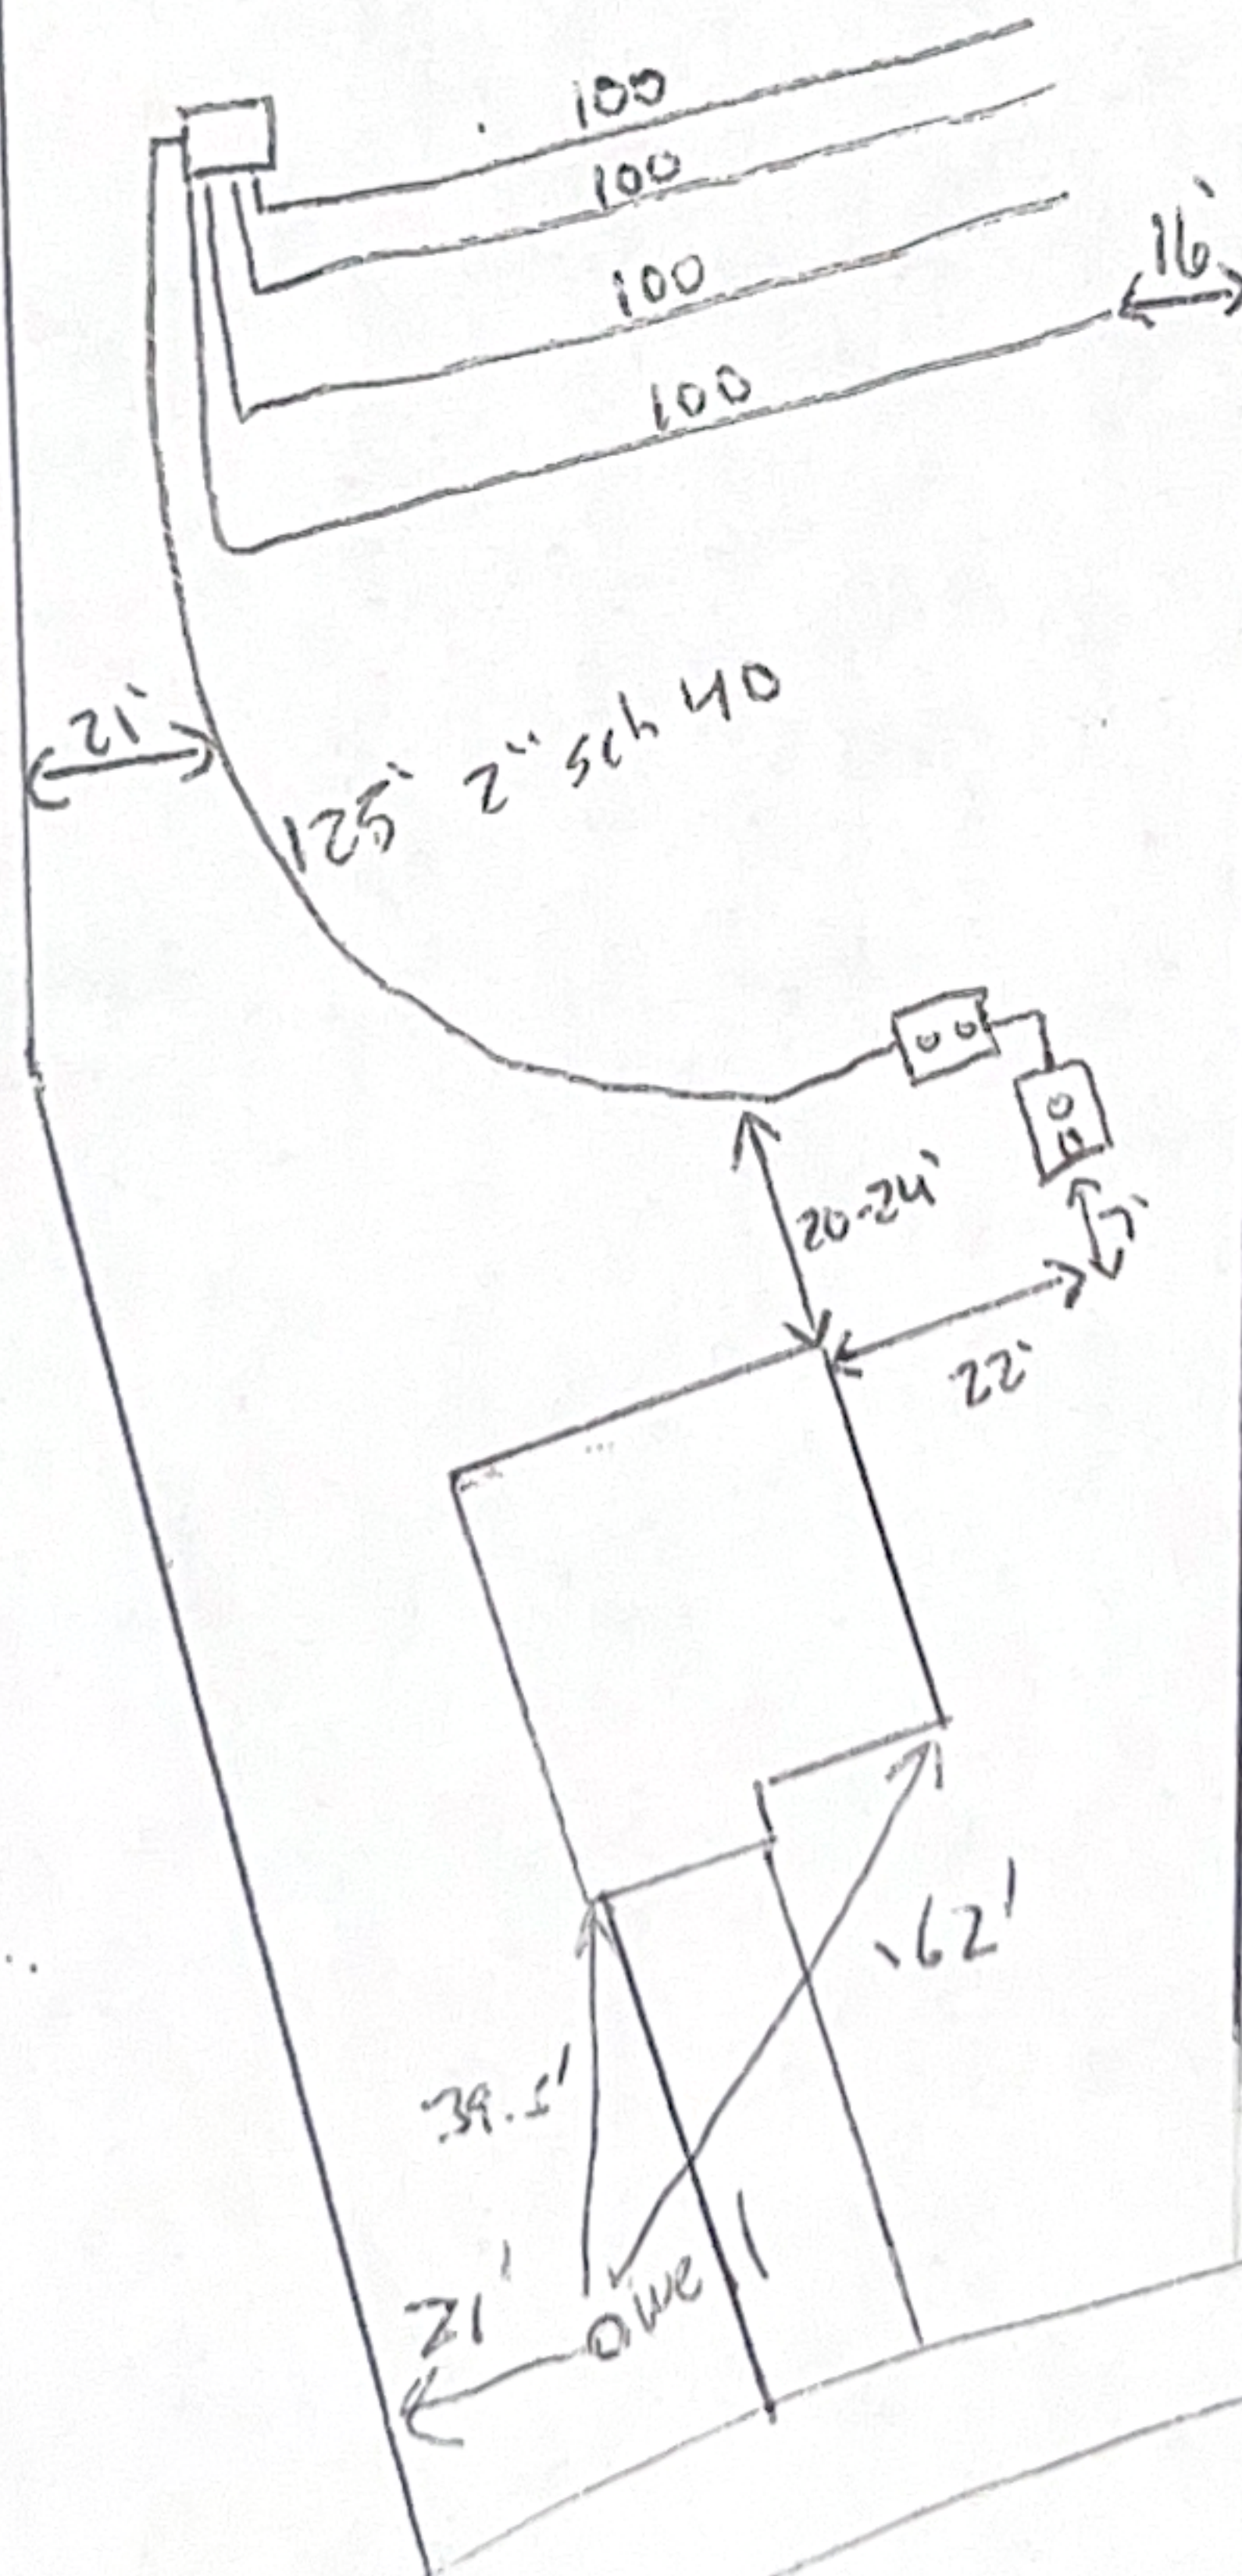

Adam Cross
Authorized Signature

6-25-19
Date