



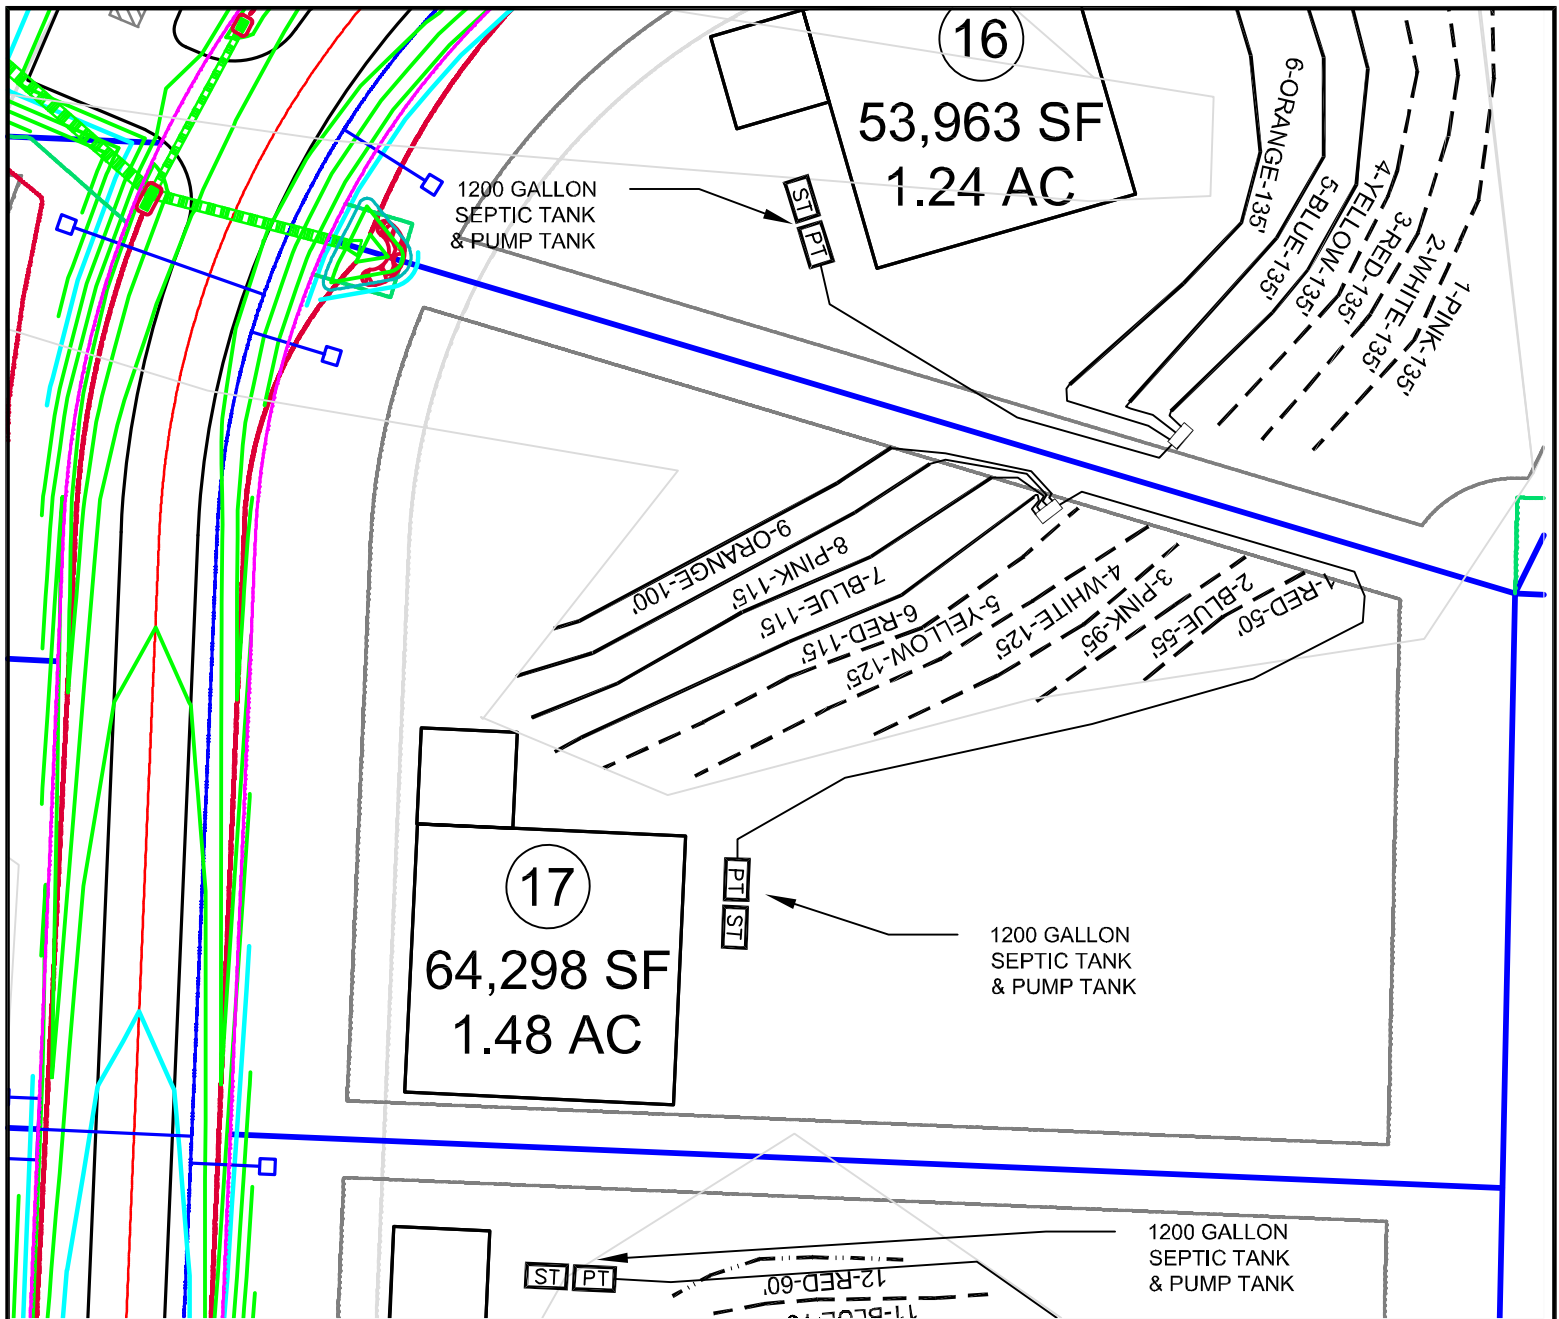

GRAPHIC SCALE
1" = 50'

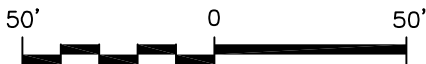

4-BEDROOM PRESSURE MANIFOLD SYSTEM
LINES 6-9 0.275 LTAR 25% REDUCTION PRODUCT
4-BEDROOM PRESSURE MANIFOLD REPAIR
LINES 1-5 0.275 LTAR 25% REDUCTION PRODUCT

LEGEND

—	SYSTEM LINE
- - - -	REPAIR LINE
- . - . -	EXTRA LINE
ST	SEPTIC TANK
PT	PUMP TANK

NOTES:

- 1) SITE DATA TO INCLUDE PROPERTY BOUNDARIES, STRUCTURE LOCATION, UTILITIES, ROADS, AND OTHER SITE FEATURES WERE PROVIDED BY THE SURVEYOR AND ARE SHOWN TO DISPLAY GENERAL SITE CONDITIONS.
- 2) ALL SEPTIC SYSTEM COMPONENTS TO INCLUDE TANKS, PUMPS, MANIFOLDS, AND SYSTEM AND REPAIR LINES HAVE BEEN GPS LOCATED BY SOIL AND ENVIRONMENTAL CONSULTANTS, PC. ALL LOCATIONS, ELEVATIONS, AND DIMENSIONS ARE APPROXIMATE AND AS SUCH NO SPECIFIC ACCURACY EITHER VERTICAL OR HORIZONTAL IS IMPLIED.
- 3) THIS MAP AND CORRESPONDING SITE EVALUATION IS NOT CONFORMANT TO THE ENGINEERED OPTION PERMIT (EOP) PROCESS. ADDITIONAL SITE TESTING AND EVALUATIONS WILL BE REQUIRED TO UTILIZE THE EOP PROCESS.
- 4) PROPERTY AND EASEMENT BOUNDARIES SHOWN ON THIS SITE SKETCH ARE APPROXIMATE AND ARE NOT INTENDED FOR LOCATING PROPERTY OR IDENTIFYING PROPERTY OR EASEMENT CORNERS. THIS IS NOT A SURVEY.

Project:

ROSSLARE, LOT 17

Project No.: 15531.SJ

Project Manager: RP
Drawn: JM, MB

Location:

WAKE CO., NC

Client:

ANHUT PROPERTIES

Scale:

1" = 50'

Field Work:

JM, MB, CC

Sheet Title:

SEPTIC SYSTEM & REPAIR LAYOUT

Sheet No.:

1 of 1

S&EC

Soil & Environmental Consultants, Inc.

8412 Falls of Neuse Rd., Suite 104 • Raleigh, North Carolina 27615 • www.SandEC.com
Phone: (919) 846-5900 • Fax: (919) 846-9467