




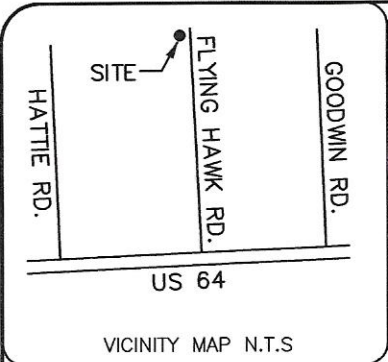


EXISTING IMPERVIOUS SURFACE:
7588 S.F. OR 8% OF AREA

NORTH BM 1980, PAGE 296

LEGEND

- IPS—Iron Pin Set
- EIP—Existing Iron Pin
- PKS—Parker—Kalon Nail Set
- EPK—Existing Parker—Kalon Nail
- PP—Power Pole
- OHP—Over Head Power
- CL—Center Line
- R/W—Right of Way
- PL—Property Line
- Lines Not Surveyed
- ECM—Existing Concrete Monument

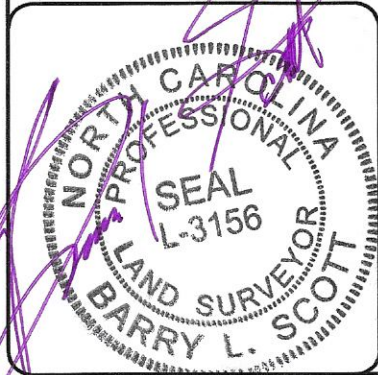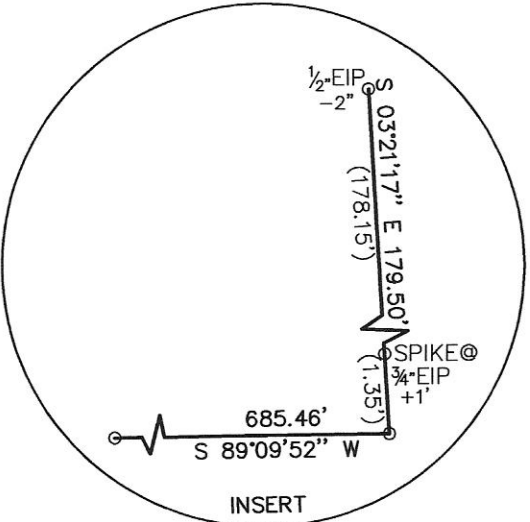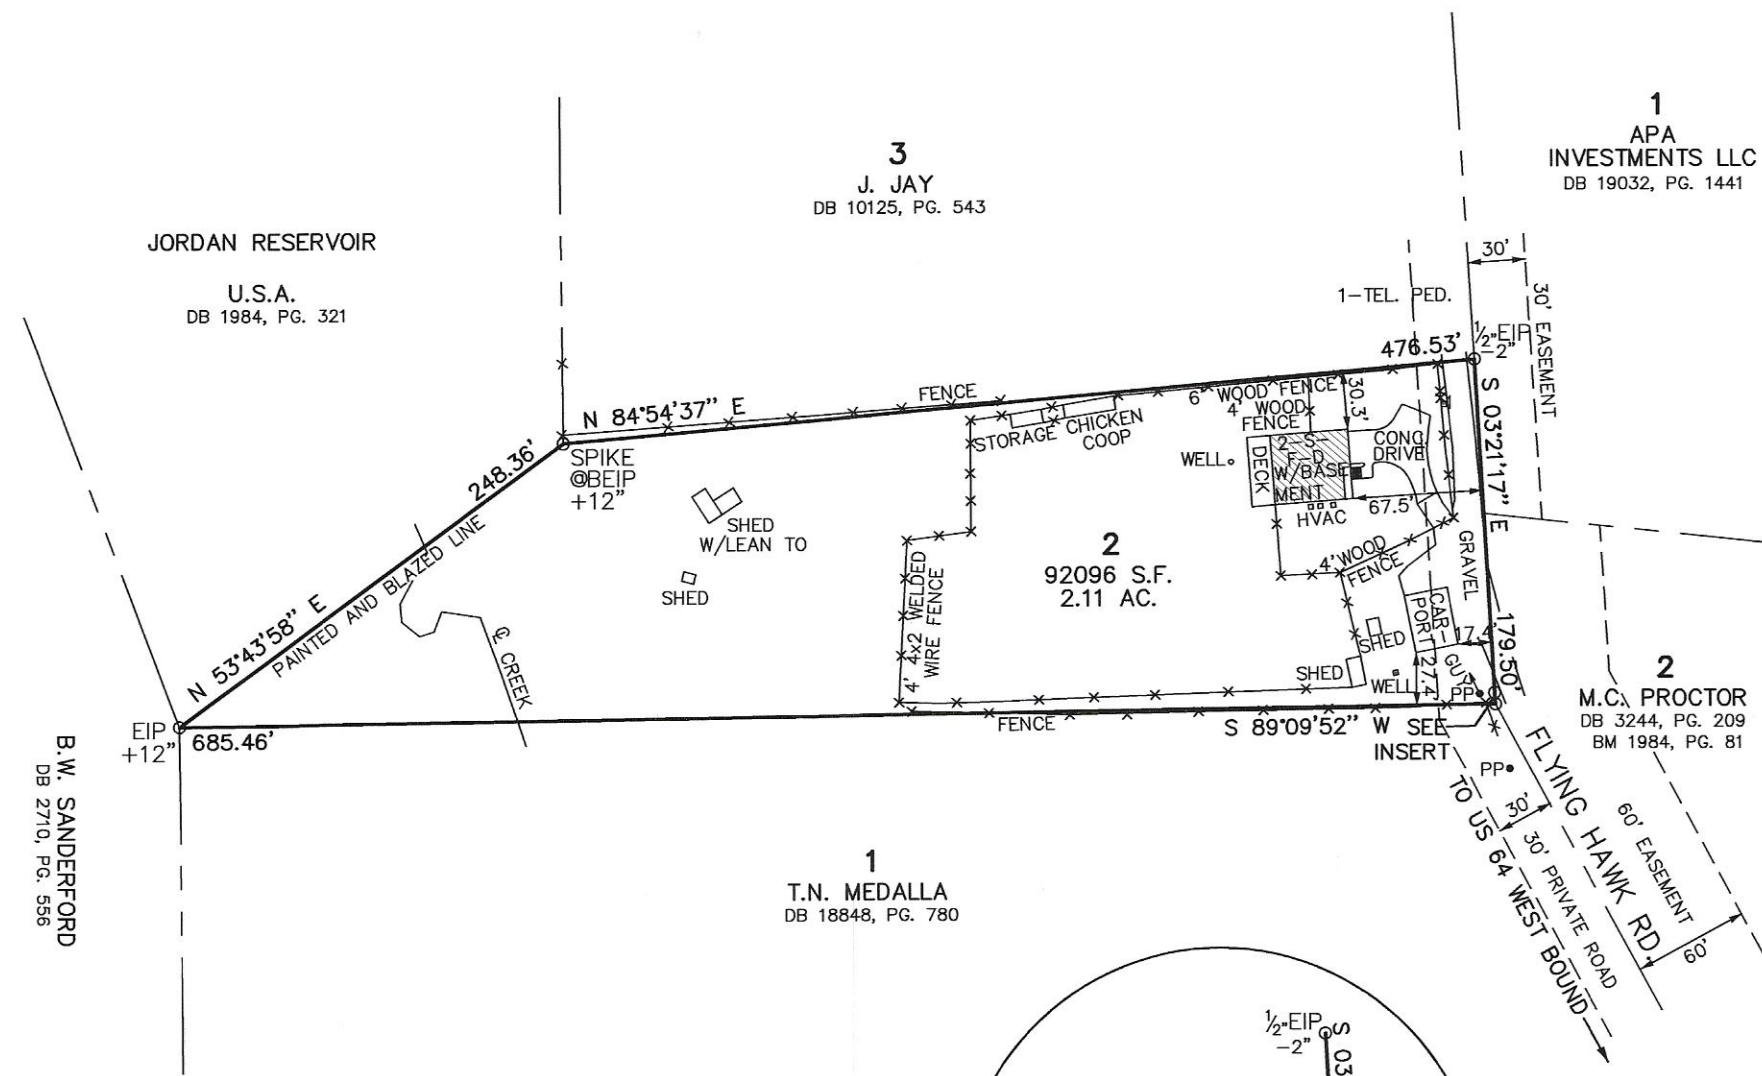


2-28-2023

PIN#: 0712977778 TOWNSHIP: WHITE OAK ZONE: R80W
LOT 2, GODFREY PROPERTY
AS RECORDED IN BOM 1980, PAGE 296 W.C.R.

AS BUILT SURVEY

I, Barry L. Scott, certify that this plat was drawn under my supervision from (an actual survey made under my supervision) (deed description recorded in Book 16697, page 2156 etc.) (other), that the ratio of precision as calculated by latitude and departures is 1/10,000, that the boundaries not surveyed are shown as broken lines plotted from information found in (SEE REFERENCE).
Witness my original signature, registration number and seal this 28th day of February, A.D. 2023

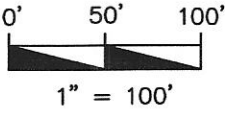

PROPERTY OF MAGDA KAREN ALFARO		
1304 FLYING HAWK RD.	WAKE COUNTY	APEX, N.C.
SCALE: 1" = 100'	BARRY L. SCOTT LAND SURVEYING PROFESSIONAL LAND SURVEYORS P. O. BOX 12403 - RALEIGH, NORTH CAROLINA 27605 TEL: 919/859-0464 FAX: 919/859-1880	
DATE: 02-28-23		
BOOK M967/51		