

Environmental Services - Water Quality
Onsite Wastewater Scan Data Entry Form

PERMIT #: W 0 I 6 9 2 6

PIN #: 1 7 4 3 3 6 2 5 1 6

OP DATE: 1 2 / 0 9 / 2 0 0 2

SYSTEM USE:

- ☒ House
☐ Mobile Home
☐ Business
☐ Other

SEWAGE TYPE:

- ☒ Domestic
☐ Industrial

PUMP/SIPHON?:

- ☐ Yes
☒ No

PRESSURE MANIFOLD:

- ☐ Yes
☒ No

SYSTEM TYPE:

- ☐ I
☒ II
☐ III
☐ IV
☐ V
☐ VI
☐ Other

SUB TYPE:

- ☒ A
☐ B
☐ C
☐ D
☐ E
☐ F
☐ G

NBR BEDROOMS:

- ☐ 1
☐ 2
☒ 3
☐ 4
☐ 5
☐ 6
☐ Other

MAINT. SCHEDULE:

- ☐ Yes
☒ No

CERT. OPERATOR

- ☐ Yes
☒ No

GT	ST	PT	SIZE
☐	☐		750
☐	☐	☐	900
☐	☒	☐	1,000
☐	☐	☐	1,200
☐	☐	☐	1,500
☐	☐	☐	1,800
☐	☐	☐	2,100
☐	☐	☐	2,500
☐	☐	☐	3,000
☐	☐	☐	4,000
☐	☐	☐	5,000
☐	☐	☐	8,000
☐	☐	☐	10,000
☐	☐	☐	Other
☒		☒	None/NA GT or PT

DRAINFIELD SIZE(SQ. FT.)

0 1 0 0 0

DRAIN TYPE:

- ☒ Stone
☐ EZ Flow
☐ Infiltrator
☐ Biodiffuser
☐ Cultec
☐ Drip
☐ Hancor
☐ Large Dia. Pipe
☐ Multi-Pipe
☐ Other

MAX DEPTH (IN.):

- ☐ 12 in. or less
☐ 18 in. or less
☒ 24 in. or less
☐ 26 in. or less
☐ 28 in. or less
☐ 30 in. or less
☐ 32 in. or less
☐ 36 in. or less
☐ Other

STONE DEPTH (IN.):


- ☐ 8 in. or less
☒ 12 in. or less
☐ 18 in. or less
☐ 24 in. or less
☐ Other


TRENCHES:

- ☒ Individual
☐ Bed

TRENCH WIDTH (IN.):

- ☐ 12 in. or less
☐ 18 in.
☐ 24 in.
☒ 36 in.
☐ 6 ft. or less
☐ 9 ft. or less
☐ Other

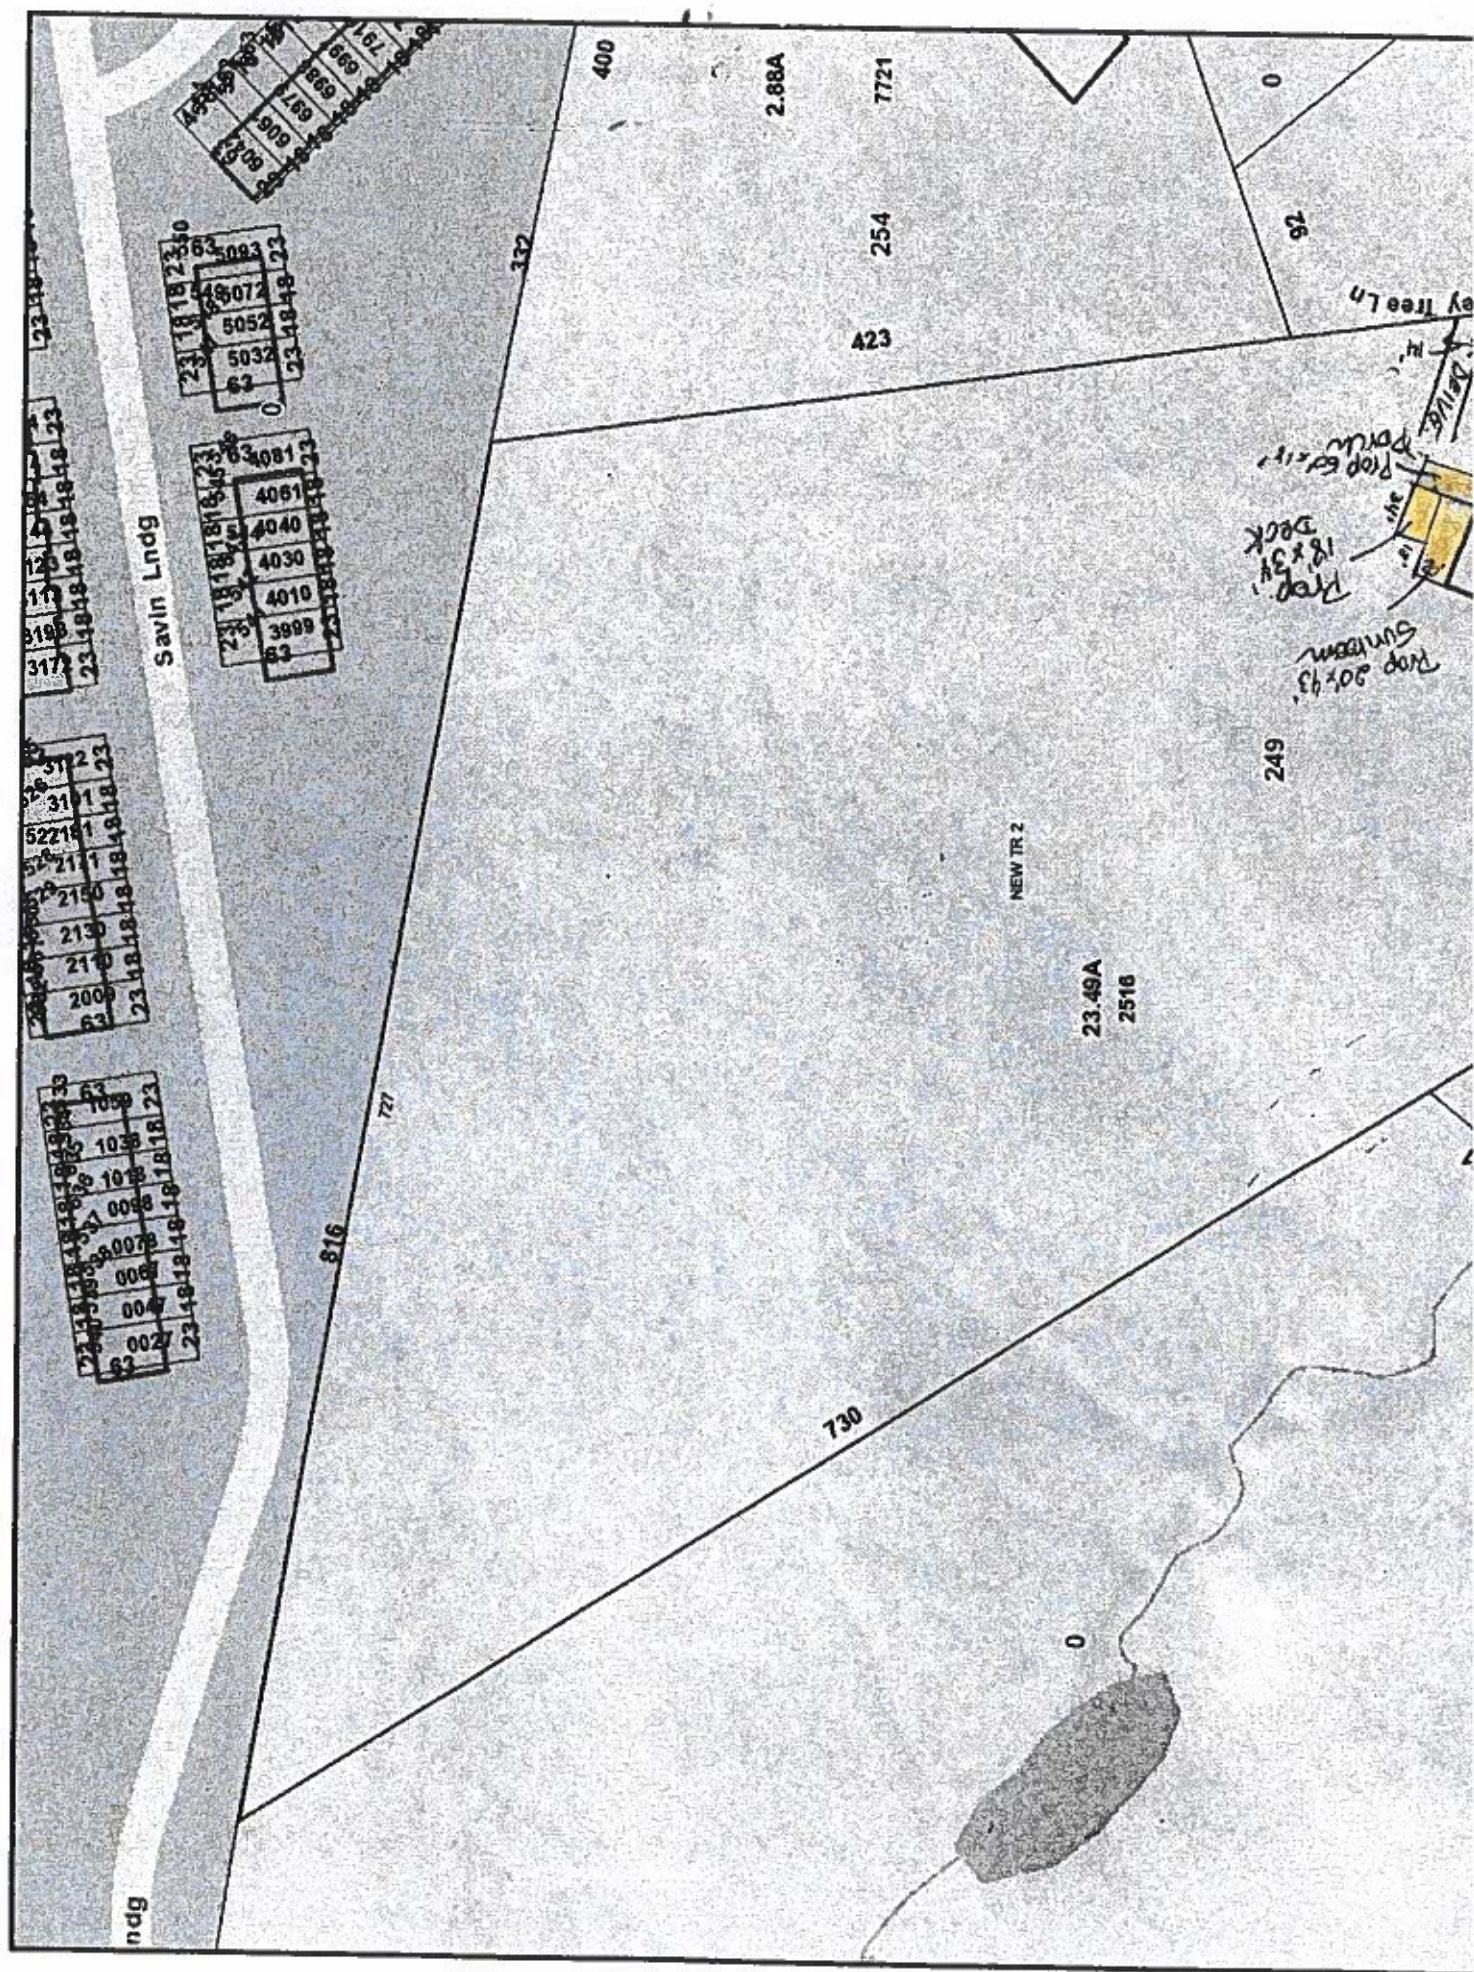

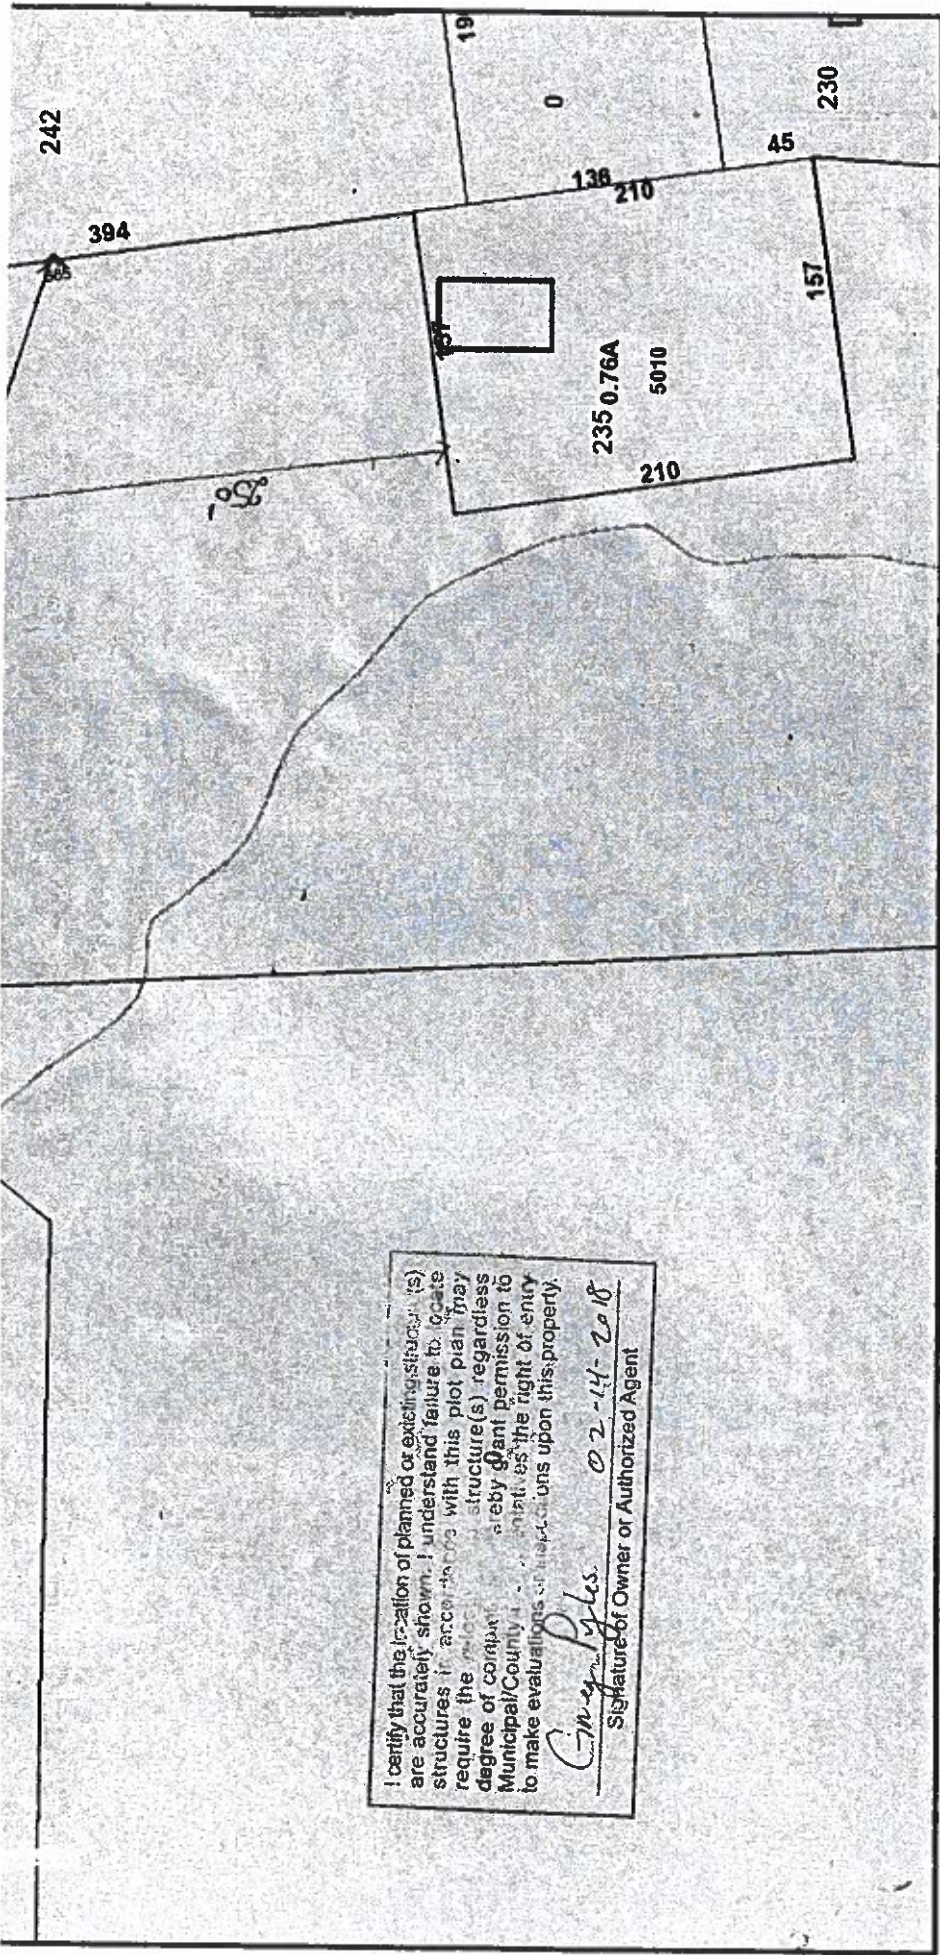

249 Money Tree Ln

W016926

20'x43' SYMPOM
18'x34' DECK

Site plan approved as shown for 18'x60' EXIST. POOL.
Any changes to site plan voids approval. All setbacks apply
for septic systems and wells, regarding any pools, decks,
additions and/or accessory structures. Applicant is responsible
for protecting all portions of the septic system, repair area and
wells from damage during construction. Adhere to all Local and
State Rules.

Approved by MLH KASB Date 2-14-18
Wake County Department of Environmental Services
Water and Waste Water Section

I certify that the location of planned or existing structure(s)
are accurately shown. I understand failure to locate
structures in accordance with this plot plan may
require the applicant to obtain a permit from the
degree of completion of the structure(s) regardless
Municipal/County. I hereby grant permission to
to make evaluations and measurements upon this property.

Gregory Pyles 02-14-2018
Signature of Owner or Authorized Agent