

TAX MAP NO. 341
PARCEL NO. 158

WAKE COUNTY HEALTH DEPARTMENT
SEPTIC TANK LAYOUT AND PERMIT

PERMIT NO. B 77

OWNER OR CONTRACTOR Frank Heaver

DATE 6-27-79

LOCATION 217 Emorywood

S. R. NO. 11000

SUBDIVISION NAME Shore Valley

LOT NO. 101 SECTION OR BLOCK NO.

GARBAGE DISPOSAL UNIT YES ☐ NO ☒

HOUSE ☒ MOBILE HOME ☐ BUSINESS ☐

NO. BEDROOMS 4 LOT AREA 40,000 sq. ft.

SIZE OF TANK 1800 gal.

NITRIFICATION LINE 1200' x 12" 1200 sq. ft.

DEPTH OF STONE IN LINES: 12" ☐ 18" ☒

WATER SUPPLY: INDIVIDUAL ☐ PUBLIC ☒


* PERMIT VOID 12 MONTHS FROM DATE OF ISSUANCE.

LAYOUT BY James E. Brown

DATE 9-4-79

INSTALLED BY James E. Brown

APPROVED BY James E. Brown

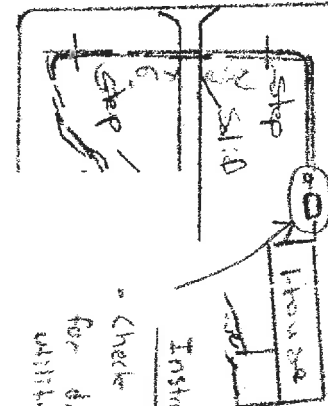

* 1800 house high in lot
* Drive switched - repair area filled.

Instructions

- Check tank & drain for damage from utility trenches
- Check box & lines for blockages