

Environmental Services - Water Quality
Onsite Wastewater Scan Data Entry Form

PERMIT #: 0009948

PIN #: 1607147508

OP DATE: 0712011998

SYSTEM USE:

- ☒ House
☐ Mobile Home
☐ Business
☐ Other

SEWAGE TYPE:

- ☒ Domestic
☐ Industrial

PUMP/SIPHON?:

- ☐ Yes
☒ No

PRESSURE MANIFOLD:

- ☐ Yes
☒ No

SYSTEM TYPE:

- ☐ I
☒ II
☐ III
☐ IV
☐ V
☐ VI
☐ Other

SUB TYPE:

- ☒ A
☐ B
☐ C
☐ D
☐ E
☐ F
☐ G

NBR BEDROOMS:

- ☐ 1
☐ 2
☒ 3
☐ 4
☐ 5
☐ 6
☐ Other

MAINT. SCHEDULE:

- ☐ Yes
☒ No

CERT. OPERATOR

- ☐ Yes
☒ No

GT ST PT SIZE

- | | | | |
|-------------------------------------|-------------------------------------|-------------------------------------|------------------|
| ☐ | ☐ | | 750 |
| ☐ | ☐ | ☐ | 900 |
| ☐ | ☒ | ☐ | 1,000 |
| ☐ | ☐ | ☐ | 1,200 |
| ☐ | ☐ | ☐ | 1,500 |
| ☐ | ☐ | ☐ | 1,800 |
| ☐ | ☐ | ☐ | 2,100 |
| ☐ | ☐ | ☐ | 2,500 |
| ☐ | ☐ | ☐ | 3,000 |
| ☐ | ☐ | ☐ | 4,000 |
| ☐ | ☐ | ☐ | 5,000 |
| ☐ | ☐ | ☐ | 8,000 |
| ☐ | ☐ | ☐ | 10,000 |
| ☐ | ☐ | ☐ | Other |
| ☒ | | ☒ | None/NA GT or PT |

DRAINFIELD SIZE(SQ. FT.)

01200

DRAIN TYPE:

- ☒ Stone
☐ EZ Flow
☐ Infiltrator
☐ Biodiffuser
☐ Cultec
☐ Drip
☐ Hancor
☐ Large Dia. Pipe
☐ Multi-Pipe
☐ Other

MAX DEPTH (IN.):

- ☐ 12 in. or less
☐ 18 in. or less
☒ 24 in. or less ^{20 in.}
☐ 26 in. or less
☐ 28 in. or less
☐ 30 in. or less
☐ 32 in. or less
☐ 36 in. or less
☐ Other

STONE DEPTH (IN.):

- ☐ 8 in. or less
☒ 12 in. or less
☐ 18 in. or less
☐ 24 in. or less
☐ Other

TRENCHES:

- ☒ Individual
☐ Bed

TRENCH WIDTH (IN.):

- ☐ 12 in. or less
☐ 18 in.
☐ 24 in.
☒ 36 in.
☐ 6 ft. or less
☐ 9 ft. or less
☐ Other

CS

WAKE COUNTY DEPARTMENT OF ENVIRONMENTAL SERVICES WELL AND SEWAGE SITE LOCATION PERMIT

NO PERMIT(S) FOR CONSTRUCTION, LOCATION OR RELOCATION ACTIVITY SHALL BE ISSUED

UNTIL AN AUTHORIZATION FOR WASTEWATER SYSTEM CONSTRUCTION HAS BEEN ISSUED

PERMIT VOID IF NOT IN COMPLIANCE WITH ZONING REGULATIONS AND/ OR IF SITE IS ALTERED OR INTENDED USE CHANGED

PERMIT#: D009948 STATUS: A APP DATE: 03/31/1998 BLDG PERMIT#: 0983342
 APPLICANT: EATMON BUILDING CO., INC. DAY PHONE: (919) 481 - 4568
 ADDRESS: 202 DOWELL DRIVE FAX#: (999) 999 - 9999
 CITY: CARY STATE: NC ZIP: 27511
 OWNER: ANDERSON ENTERPRISES INC DAY PHONE: (999) 999 - 9999
 ADDRESS: RR 2 BOX 232B FAX#: (999) 999 - 9999
 CITY: FUQUAY-VARINA STATE: NC ZIP: 27526
 HD USE CD: 101 ONE-FAMILY HOUSE ORIG PERMIT#: REC?: Y
 EXIST USE: TAX MAP#: 0844
 BEDROOMS: 3 BSMT: N #EMPLOYEES: 0 WATER: C WASTEWATER: I GARB DISPOS: N
 TOWNSHIP: 15 PANTHER BRANCH JURIS: WC ZON: R30 PIN: 1607.03 14 ~~6526~~ 000 7508
 SUBD#: S 000 000 00 SUBD NAME: TYLER FARMS LOT-SEC: 3 ACRE: 2.08
 IMPRV PRMT: ISSUED?: Y DATE: 04/21/1998 BY: RJD TYPE SYSTEM: II PUMP:
 CNSTR AUTH: ISSUED?: Y DATE: 04/21/1998 BY: RJD DATE EXPIRED: 04/21/2003
 RECEIPT#: 0026757 FEE: 145.00 OP DATE: BY:
 WATR SAMPL: REQ?: N APPROVED?: DATE: PROPRIETARY SYS:
 ST#: 1004 MI: DIR: NAME: TYLER FARMS DIR: TYP: DR
 DIRECTIONS: 401 SOUTH L ON OLD STAGE L ON ROCK SERVICE STAT
 ION RIGHT INTO SUBD.

*BTS-1000 S-24
STB 103*

IMPROVEMENT PERMIT

SIZE OF TANK 1000 ST PT GALS. TOTAL SQ. FT. 1200 DEPTH OF STONE 12 IN. MAX. DEPTH LINE 20 IN.

WASTEWATER: DOMESTIC ☒ INDUSTRIAL ☐

I.P. ISSUED BY

Ron Dudley R.S.

AUTHORIZATION FOR WASTEWATER SYSTEM CONSTRUCTION

VOID SIXTY (60) MONTHS FROM DATE OF ISSUANCE

AUTHORIZATION CONDITIONS

Contractor To Follow Contours, See Attached Site Plan For Wastewater System Design And Well Location. The wastewater system shall not be covered or placed into use until inspected by the Wake County Department of Environmental Services and an Operation Permit issued.

OTHER CONDITIONS:

SIZE OF TANK 1000 ST PT GALS. TOTAL SQ. FT. 1200 DEPTH OF STONE 12 IN. MAX. DEPTH LINE 20 IN.
 ST FILTER REQUIRED ☒ NUMBER OF TRENCHES 2 LENGTH OF TRENCHES 200 FT. WIDTH OF TRENCHES 3 FT.

C.A. ISSUED BY *Ron Dudley R.S.* INSTALLED BY *Clint Adams* CTR. I.D. # _____

SEPTIC TANK FILTER USED _____

INNOV. APPRL. #: IWWS-_____ DATE 7/20/98 INSTALLATION APPROVED BY *Joan Rose*

YT

WELL SYSTEM = PRIVATE ☐ SEMI-PUBLIC ☒ NEW ☐ REPLACEMENT ☐ EXISTING ☐

WELL LOG INFORMATION = DEPTH _____ CASING DEPTH _____ YIELD _____ STATIC LEVEL _____

WELL CONTRACTOR _____ REG.# _____ PUMP CONTRACTOR _____ REG.# _____

CONSTRUCTION COMPLIANCE = GROUT APPROVED ☐ DATE _____ EHS _____

WCHD ID # _____ WELLHEAD APPROVED ☐ DATE _____ EHS _____

NEGATIVE BACTERIOLOGICAL RESULTS ☐ DATE _____ EHS _____

SYSTEM FINALIZED ☐ DATE _____ EHS _____

COMMENTS:

This permit is based in part on information provided by the homeowner or his/her representative in the application submitted for this permit. The Environmental Health Specialist is not responsible for false or misleading information contained in the application. The Environmental Health Specialist is also not responsible for concealed conditions on the property or for statements in this report that may have resulted from false or misleading statements provided to him in the application. Neither Wake County nor the Environmental Health Specialist warrants that the septic tank system will continue to function satisfactorily in the future or that the water supply will remain potable.

*Lines & D Box OK
Need Effluent Riser & Filter*

#0983342

Lot 3 Tyler Farms
1004 Tyler Farms Dr
Raleigh NC - 27603


Book 1997 Page 1847

I certify that the location of planned or existing structure(s) are accurately shown. I understand failure to locate structures in accordance with this plot plan may require the relocation of structure(s) regardless degree of completion. I hereby grant permission to Municipal/County Representatives the right of entry to make evaluations or inspections upon this property.

[Signature]
Signature of Owner or Authorized Agent

D-9948

Zoning R-30 By SWM
Approve ✓ Date 3/3/98
Revise _____ Use 10
Reject _____ MBL _____
Front 30" Rear 30"
Side 10" Corner 30"
Comments _____

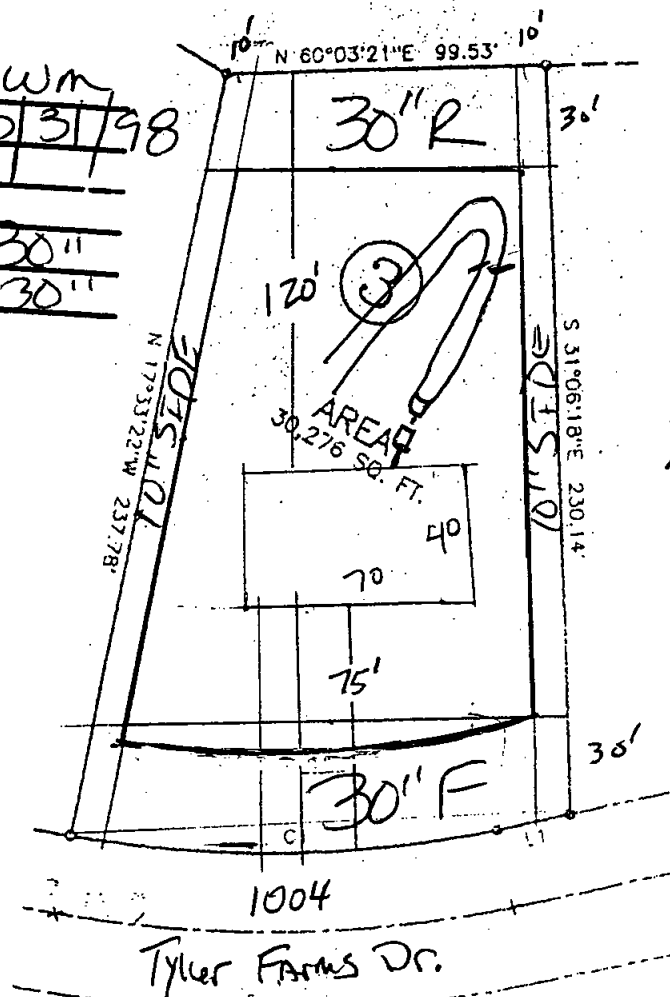

1000 GAL. TANK
2(200' x 3')
20"

CDS
INSPECTIONS &
LAND USE DIVISION

DATE 03/31/1998 TUE

0050630-0921	\$145.00
117200-01009	\$24.00
NON-ADD NO.	#983342
NON-ADD NO.	#9942
TOTAL	\$169.00
CHECK	\$169.00
00000005WM	#01
TIME 10:19	NO. 026757

1' = 60'