

Environmental Services - Water Quality
Onsite Wastewater Scan Data Entry Form

PERMIT #: WA11940

PIN #: 6770153881

OP DATE: 08/29/1984

SYSTEM USE:
☒ House
☐ Mobile Home
☐ Business
☐ Other

SEWAGE TYPE:
☒ Domestic
☐ Industrial

PUMP/SIPHON?:
☐ Yes
☒ No

PRESSURE MANIFOLD:
☐ Yes
☒ No

SYSTEM TYPE:
☐ I
☒ II
☐ III
☐ IV
☐ V
☐ VI
☐ Other

SUB TYPE:
☒ A
☐ B
☐ C
☐ D
☐ E
☐ F
☐ G

NBR BEDROOMS:
☐ 1
☐ 2
☒ 3
☐ 4
☐ 5
☐ 6
☐ Other

MAINT. SCHEDULE:
☐ Yes
☒ No

CERT. OPERATOR
☐ Yes
☒ No

GT	ST	PT	SIZE
☐	☐		750
☐	☐	☐	900
☐	☒	☐	1,000
☐	☐	☐	1,200
☐	☐	☐	1,500
☐	☐	☐	1,800
☐	☐	☐	2,100
☐	☐	☐	2,500
☐	☐	☐	3,000
☐	☐	☐	4,000
☐	☐	☐	5,000
☐	☐	☐	8,000
☐	☐	☐	10,000
☐	☐	☐	Other
☒		☒	None/NA GT or PT

DRAINFIELD SIZE(SQ. FT.)

61100

DRAIN TYPE:

☒ Stone
☐ EZ Flow
☐ Infiltrator
☐ Biodiffuser
☐ Cultec
☐ Drip
☐ Hancor
☐ Large Dia. Pipe
☐ Multi-Pipe
☐ Other

MAX DEPTH (IN.):

☐ 12 in. or less
☐ 18 in. or less
☒ 24 in. or less
☐ 26 in. or less
☐ 28 in. or less
☐ 30 in. or less
☐ 32 in. or less
☐ 36 in. or less
☐ Other

STONE DEPTH (IN.):

☐ 8 in. or less
☒ 12 in. or less
☐ 18 in. or less
☐ 24 in. or less
☐ Other

TRENCHES:

☒ Individual
☐ Bed

TRENCH WIDTH (IN.):

☐ 12 in. or less
☐ 18 in.
☐ 24 in.
☒ 36 in.
☐ 6 ft. or less
☐ 9 ft. or less
☐ Other

BEING LOT 131, SECTION 1, REVISED OF LYNNHAVEN SUBD.,
RECORDED IN BOOK OF MAPS 1984, PG. 346.

ADDRESS:

2900 MEADOWVIEW CT.
APEX, N.C.

Pin: 0710153881

I certify that the location of planned or existing structure(s) are accurately shown. I understand failure to locate structures in accordance with this lot plan may require the relocation of structure(s) regardless of degree of completion. I hereby grant permission to Municipal/County Representatives the right of entry to make evaluations or inspections upon this property.


Signature of Owner or Authorized Agent

0151455

2351
~~2139~~
111
1280.
121
336
~~576~~
4199
30,143
.14
14%


Concrete
Walk
House
Shed
Garage (New)

24x24 1/2 ST.
ATTACHED GARAGE

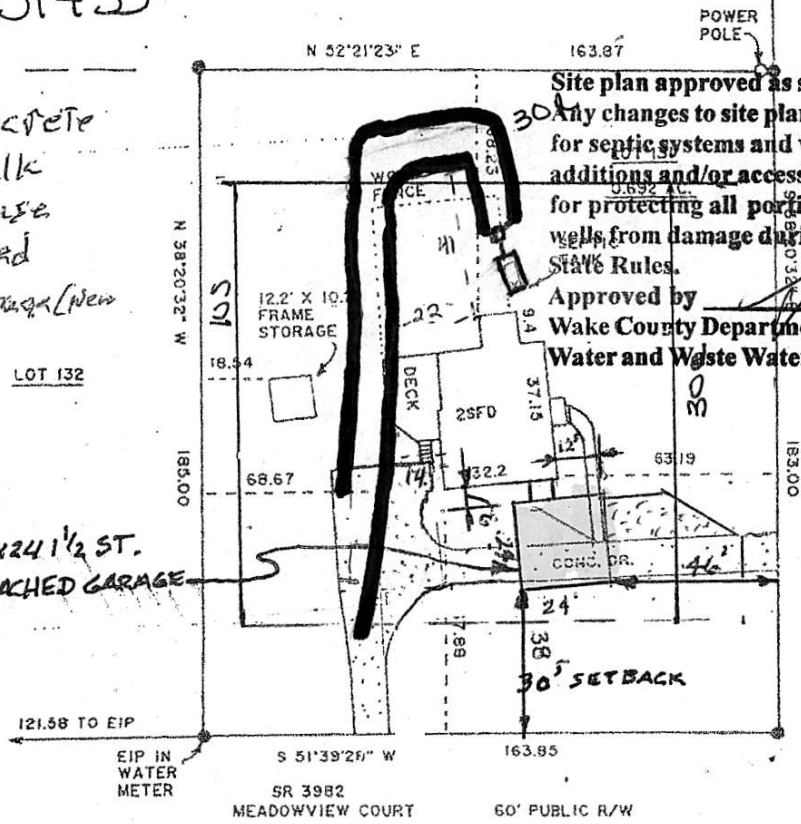

Site plan approved as shown for 24'x24' Garage.
Any changes to site plan voids approval. All setbacks apply
for septic systems and wells, regarding any pools, decks,
additions and/or accessory structures. Applicant is responsible
for protecting all portions of the septic system, repair area and
wells from damage during construction. Adhere to all Local and
State Rules.

Approved by [Signature] Date 2/9/15
Wake County Department of Environmental Services,
Water and Waste Water Section

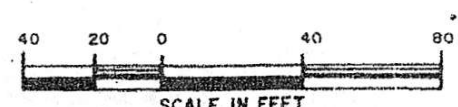

LEGEND
● EXISTING IRON PIPE

Zoning R30 By [Signature] Date 2.9.15
Approve [Signature] Use 4300B
Revise [Signature] Project 101A
Front 30 Rear 30
Side 10 Corner 30
Comments



HOUSE LOCATION FOR
WILLIAM H. McMILLIAN & WIFE
ANDREA J. McMILLIAN
SWIFT CREEK TOWNSHIP
WAKE COUNTY
NORTH CAROLINA

I, ROBERT G. WILLIAMS, certify that under my direction and supervision this map was drawn from an actual field survey; that the error of closure of the survey as calculated by latitudes and departures is 1:10,000; that this map was prepared in accordance with G.S. 47-30 as amended.

Witness my hand and seal this 22 day of SEPTEMBER, 1997.
R.L.S. L-1417 Robert G. Williams

ROBERT G. WILLIAMS
REGISTERED LAND SURVEYOR
ZEBULON, NORTH CAROLINA

Telephone: 269-5700

DRAWN BY: RGW & ELW

CHECKED BY: RGW

DATE: 9-22-97

Sworn to and subscribed before me this 22 day of SEPTEMBER 1997