

WAKE COUNTY DEPARTMENT OF ENVIRONMENTAL SERVICES WELL AND SEWAGE SITE LOCATION PERMIT
NO PERMIT(S) FOR CONSTRUCTION, LOCATION OR RELOCATION ACTIVITY SHALL BE ISSUED
UNTIL AN AUTHORIZATION FOR WASTEWATER SYSTEM CONSTRUCTION HAS BEEN ISSUED

PERMIT VOID IF NOT IN COMPLIANCE WITH ZONING REGULATIONS AND/ OR IF SITE IS ALTERED OR INTENDED USE CHANGED

PERMIT#: D030776 STATUS: A APP. DATE: 06/24/2004 BLDG. PERMIT#:
PIN: 0772.04 51 2251 000 TAX MAP: 0627 0166 RECORDED: Y ORIG. PERMIT#:
TOWNSHIP: 18 SWIFT CREEK JURISDICTION: WC ZONING:
APPLICANT: SUGGS, ANN
PO BOX 386
RALEIGH, NC 27602
(999) 999 - 9999
USE: HD USE: 0001 REPAIR/EXISTING SYSTEM
EXIST USE: 101 ONE-FAMILY HOUSE
DISPOSAL: BEDROOMS: 2 BASEMENT: N #EMPLOYEES: 0 FOUND DRAIN: N
SITE: ADDRESS: 7000 HOLLY SPRINGS RD
SUBDIVISION: LOT: ACRES: 0.01
DIRECTION: OFF HOLLY SPRINGS RD. NEAR CARY PARKWAY INTERSE
CTION

IMPROVEMENT PERMIT

TANK SIZE: EXIST gal. PUMP Tank: _____ gal. SQ FT: 900 STONE DEPTH: 12 in. MAX DEPTH LINE: 30 in.
WASTEWATER: INDIVIDUAL SEWAGE: DOMESTIC TYPE SYSTEM: II A PUMP: N P/M: N
DAILY FLOW: 240 gal/day DESIGN FEE REQ?: PAID?: WATER: INDIVIDUAL

COMMENTS:

IP ISSUED? DATE: BY: () PHONE#:

AUTHORIZATION FOR WASTEWATER/WATER SYSTEM CONSTRUCTION

VOID SIXTY (60) MONTHS FROM DATE OF ISSUANCE

AUTHORIZATION CONDITIONS:


Contractors shall install system on contours, see attached site plan for wastewater system design and well location. No underground utilities, water lines or sprinkler systems may be located in the original system or repair areas. A septic tank filter with a riser for access is required. The wastewater system shall not be covered or placed into use until inspected by the Wake County Department of Environmental Services and an Operation Permit issued. **OTHER CONDITIONS:**
INSTALL LINES ON CONTOUR. MAINTAIN ALL SETBACKS. IF SITE OR SITE PLAN CHANGES, PERMIT IS VOID. CALL PRIOR TO ISNTALLATION WITH ANY QUESTIONS, COMMENTS OR CONCERNS. MAY BE CHANGED TO INNOVATIVE AT HOMEOWNERS REQUEST WITH A 25% REDUCTION.

TANK SIZE: EXIST gal. PUMP TANK: _____ gal. SQ FT: 900 STONE DEPTH: 12 in. MAX DEPTH LINE: 30 in.
MAINT: N OPER: N L/O: Y TRENCH#: 4 LENGTH: 75 ft. WIDTH: 36 in. DESIGNER: _____
SUBFIELDS: _____ DESIGN HEAD PRESSURE: _____ DESIGN FLOW: _____ gal/min DOSE VOLUME: _____ gal.

CA ISSUED? Y DATE: 06/24/2004 BY: (JEM) *Joe McNeal* PHONE#: 856-7342

CA/AS Built

REID:	012421
OWNER1:	SUGGS
ADDR1:	PO BOX
ADDR2:	RALEIGH
ADDR3:	
DEED BOOK:	08874
DEED PAGE:	1527
DEED DATE:	4/11/2001
DEED ACRES:	0.92
BLDG VAL:	51553
LAND VAL:	66000
BILLING CLASS:	INDIVID
DESCRIPTION:	LOT 1 F POWEL
MAP NAME:	077204
PIN NUM:	077251
PIN EXT:	
CITY:	
PLAN JURIS:	WC
TOWNSHIP:	SWIFT
YEAR BUILT:	1957
SALEPRICE:	118500
SALEDATE:	4/11/2001
TYPE USE:	Single F
DESIGN STYLE:	Conven
UNITS:	1
LAND CLASS:	RESIDE
ZONING:	HOME
OLD PARCEL NUMBER:	R-40
ADDRESS	627-00C
ST NUM:	7000
ST MISC:	
DIR PREFIX:	
ST NAME:	HOLLY
ST TYPE:	RD
DIR SUFFIX:	

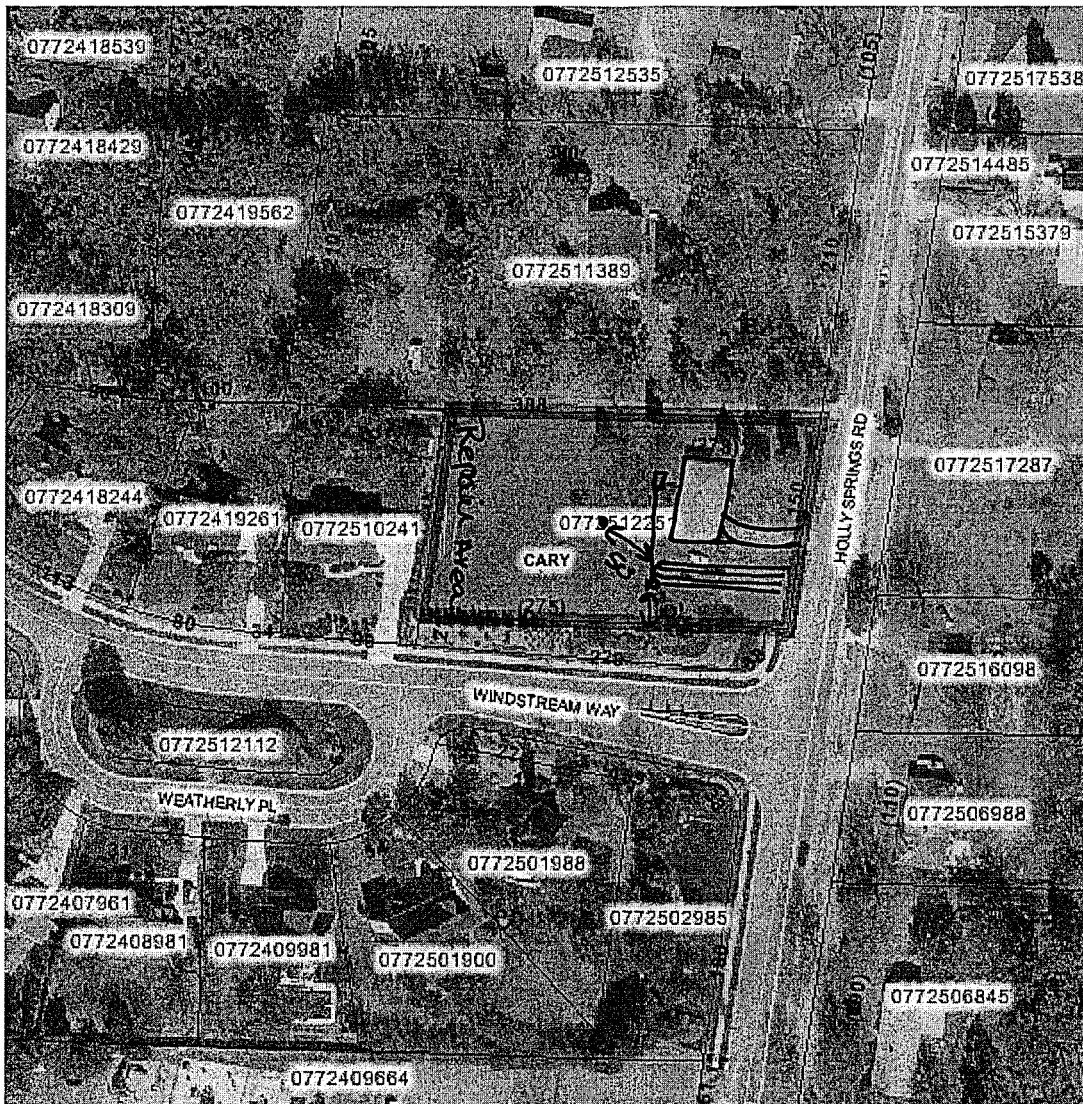

Parcel Number: 0772512251

Map created on 6/29/2004 9:08:24 AM.

Copyright 2003. City of Raleigh, Wake County.

4x75x3
 Conventional
 Existing ST

0 58 ft

D30776