

Environmental Services - Water Quality
Onsite Wastewater Scan Data Entry Form

PERMIT #: 1033171

PIN #: 1793370370

OP DATE: 0412612005

SYSTEM USE:

- ☒ House
☐ Mobile Home
☐ Business
☐ Other

SEWAGE TYPE:

- ☒ Domestic
☐ Industrial

PUMP/SIPHON?:

- ☐ Yes
☒ No

PRESSURE MANIFOLD:

- ☐ Yes
☒ No

SYSTEM TYPE:

- ☐ I
☒ II
☐ III
☐ IV
☐ V
☐ VI
☐ Other

SUB TYPE:

- ☒ A
☐ B
☐ C
☐ D
☐ E
☐ F
☐ G

NBR BEDROOMS:

- ☐ 1
☐ 2
☒ 3
☐ 4
☐ 5
☐ 6
☐ Other

MAINT. SCHEDULE:

- ☐ Yes
☒ No

CERT. OPERATOR

- ☐ Yes
☒ No

GT ST PT

- ☐ ☐ ☐
☐ ☐ ☐
☐ ☒ ☐
☐ ☐ ☐
☐ ☐ ☐
☒ ☐ ☒

SIZE

- 750
900
1,000 *EST. IMP. TAD*
1,200
1,500
1,800
2,100
2,500
3,000
4,000
5,000
8,000
10,000
Other
None/NA GT or PT

DRAINFIELD SIZE(SQ. FT.)

01440

DRAIN TYPE:

- ☒ Stone
☐ EZ Flow
☐ Infiltrator
☐ Biodiffuser
☐ Cultec
☐ Drip
☐ Hancor
☐ Large Dia. Pipe
☐ Multi-Pipe
☐ Other

MAX DEPTH (IN.):

- ☐ 12 in. or less
☐ 18 in. or less
☐ 24 in. or less
☐ 26 in. or less
☐ 28 in. or less
☐ 30 in. or less
☐ 32 in. or less
☒ 36 in. or less
☐ Other

STONE DEPTH (IN.):

- ☐ 8 in. or less
☒ 12 in. or less
☐ 18 in. or less
☐ 24 in. or less
☐ Other

TRENCHES:

- ☒ Individual
☐ Bed

TRENCH WIDTH (IN.):

- ☐ 12 in. or less
☐ 18 in.
☐ 24 in.
☒ 36 in.
☐ 6 ft. or less
☐ 9 ft. or less
☐ Other

WAKE COUNTY DEPARTMENT OF ENVIRONMENTAL SERVICES WELL AND SEWAGE SITE LOCATION PERMIT
NO PERMIT(S) FOR CONSTRUCTION, LOCATION OR RELOCATION ACTIVITY SHALL BE ISSUED
UNTIL AN AUTHORIZATION FOR WASTEWATER SYSTEM CONSTRUCTION HAS BEEN ISSUED

PERMIT VOID IF NOT IN COMPLIANCE WITH ZONING REGULATIONS AND/ OR IF SITE IS ALTERED OR INTENDED USE CHANGED

PERMIT#: D033171 STATUS: A APP. DATE: 03/18/2005 BLDG. PERMIT#: _____
PIN: 1793.10 37 0370 000 TAX MAP: 0564 0031 RECORDED: Y ORIG. PERMIT#: _____
TOWNSHIP: 10 MARKS CREEK JURISDICTION: WEX ZONING: RAX
APPLICANT: GROSSMAN, ROBERT J & ANN M
869 LIONS CLUB RD
WENDELL, NC 27691
(919) 369-2197
USE: HD USE: 0001 REPAIR/EXISTING SYSTEM
EXIST USE: 112 MOBILE HOME
DISPOSAL: BEDROOMS: 3 BASEMENT: N #EMPLOYEES: 0
SITE: ADDRESS: 869 LIONS CLUB RD
SUBDIVISION: HOBGOOD EST LOT: 3 ACRES: 1.10
DIRECTION: 64 E, R ON 64 BUSINESS INTO WENDELL, R ON
231, L ON LIONS CLUB, HOUSE ON L

Well System: WATER: INDIVIDUAL - TYPE: EXISTING

WELL LOG INFORMATION: DEPTH: _____ CASING DEPTH: _____ YIELD: _____ STATIC LEVEL: GP
WELL CONTRACTOR: _____ REG.# _____ PUMP CONTRACTOR: _____ REG.# _____
Construction Compliance GROUT APPROVED ☐ DATE _____ EHS _____
WELLHEAD APPROVED ☐ DATE _____ EHS _____
SYSTEM FINALIZED ☐ DATE _____ EHS _____

COMMENTS: _____

DESIGN FLOW: _____ gal./min. ACTUAL FLOW: _____ INNOVATIVE LETTER: _____
INSTALLED BY: ED Faison INSTALLATION APPROVED BY: Aaron L. Elbert
PROPRIETARY SYSTEM: _____ FILTER NO: _____
COMMENTS: _____

OPERATIONS PERMIT ISSUED? Y OP DATE: 4/26/05 BY: Aaron L. Elbert

This permit is based in part on information provided by the homeowner or his/her representative in the application submitted for this permit. The Environmental Health Specialist is not responsible for false or misleading information contained in the application. The Environmental Health Specialist is also not responsible for concealed conditions on the property or for statements in this report that may have resulted from false or misleading statements provided to him in the application. Neither Wake County nor the Environmental Health Specialist warrants that the septic tank system will continue to function satisfactorily in the future or that the water supply will remain potable.

As Built Information:

Date: _____ Benchmark: _____ Rod reading: _____ Distance to Structure: _____
ST: _____ gals ID#: _____ D.O.M.: _____ Elev.: _____ Distance to Well: _____
PT: _____ gals ID#: _____ D.O.M.: _____ Elev.: _____
D-box/FD/PM elev.: _____ Supply Line: _____ ft. Pump/Control Panel: _____
Line 1: _____ Date: _____
Line 2: _____ Date: _____
Line 3: _____ Date: _____
Line 4: _____ Date: _____
Line 5: _____ Date: _____
Distance to P/L: _____ Notes: _____

WAKE COUNTY DEPARTMENT OF ENVIRONMENTAL SERVICES WELL AND SEWAGE SITE LOCATION PERMIT
NO PERMIT(S) FOR CONSTRUCTION, LOCATION OR RELOCATION ACTIVITY SHALL BE ISSUED
UNTIL AN AUTHORIZATION FOR WASTEWATER SYSTEM CONSTRUCTION HAS BEEN ISSUED

PERMIT VOID IF NOT IN COMPLIANCE WITH ZONING REGULATIONS AND/ OR IF SITE IS ALTERED OR INTENDED USE CHANGED

PERMIT#: D033171 STATUS: A APP. DATE: 03/18/2005 BLDG. PERMIT#:
PIN: 1793.10 37 0370 000 TAX MAP: 0564 0031 RECORDED: Y ORIG. PERMIT#:
TOWNSHIP: 10 MARKS CREEK JURISDICTION: WEX ZONING: RAX
APPLICANT: GROSSMAN, ROBERT J & ANN M
869 LIONS CLUB RD
WENDELL, NC 27591
(919) 369 - 2197
USE: HD USE: 0001 REPAIR/EXISTING SYSTEM
EXIST USE: 112 MOBILE HOME
DISPOSAL: BEDROOMS: 3 BASEMENT: N #EMPLOYEES: 0 FOUND DRAIN: N
SITE: ADDRESS: 869 LIONS CLUB RD
SUBDIVISION: HOBGOOD EST LOT: 3 ACRES: 1.10
DIRECTION: 64 E, R ON 64 BUSINESS INTO WENDELL, R ON
231, L ON LIONS CLUB, HOUSE ON L

IMPROVEMENT PERMIT

TANK SIZE: EXIST gal. PUMP Tank: ____ gal. SQ FT: 1440 STONE DEPTH: 12 in. MAX DEPTH LINE: 36 in.
WASTEWATER: INDIVIDUAL SEWAGE: DOMESTIC TYPE SYSTEM: II B PUMP: N P/M: N
DAILY FLOW: 360 gal/day DESIGN FEE REQ?: PAID?: WATER: INDIVIDUAL

COMMENTS:

IP ISSUED? DATE: BY: () NA PHONE#: _____

AUTHORIZATION FOR WASTEWATER/WATER SYSTEM CONSTRUCTION


VOID SIXTY (60) MONTHS FROM DATE OF ISSUANCE

AUTHORIZATION CONDITIONS:


Contractors shall install system on contours, see attached site plan for wastewater system design and well location. No underground utilities, water lines or sprinkler systems may be located in the original system or repair areas. A septic tank filter with a riser for access is required. The wastewater system shall not be covered or placed into use until inspected by the Wake County Department of Environmental Services and an Operation Permit issued. **OTHER CONDITIONS:**

TANK SIZE: EXIST gal. PUMP TANK: ____ gal. SQ FT: 1440 STONE DEPTH: 12 in. MAX DEPTH LINE: 36 in.
MAINT: N OPER: N L/O: N TRENCH#: 4 LENGTH: 120 ft. WIDTH: 36 in. DESIGNER: ____
SUBFIELDS: ____ DESIGN HEAD PRESSURE: ____ DESIGN FLOW: ____ gal/min DOSE VOLUME: ____ gal.

CA ISSUED? Y DATE: 03/18/2005 BY: (ELC) Everett L. Costa PHONE#: 856-5380

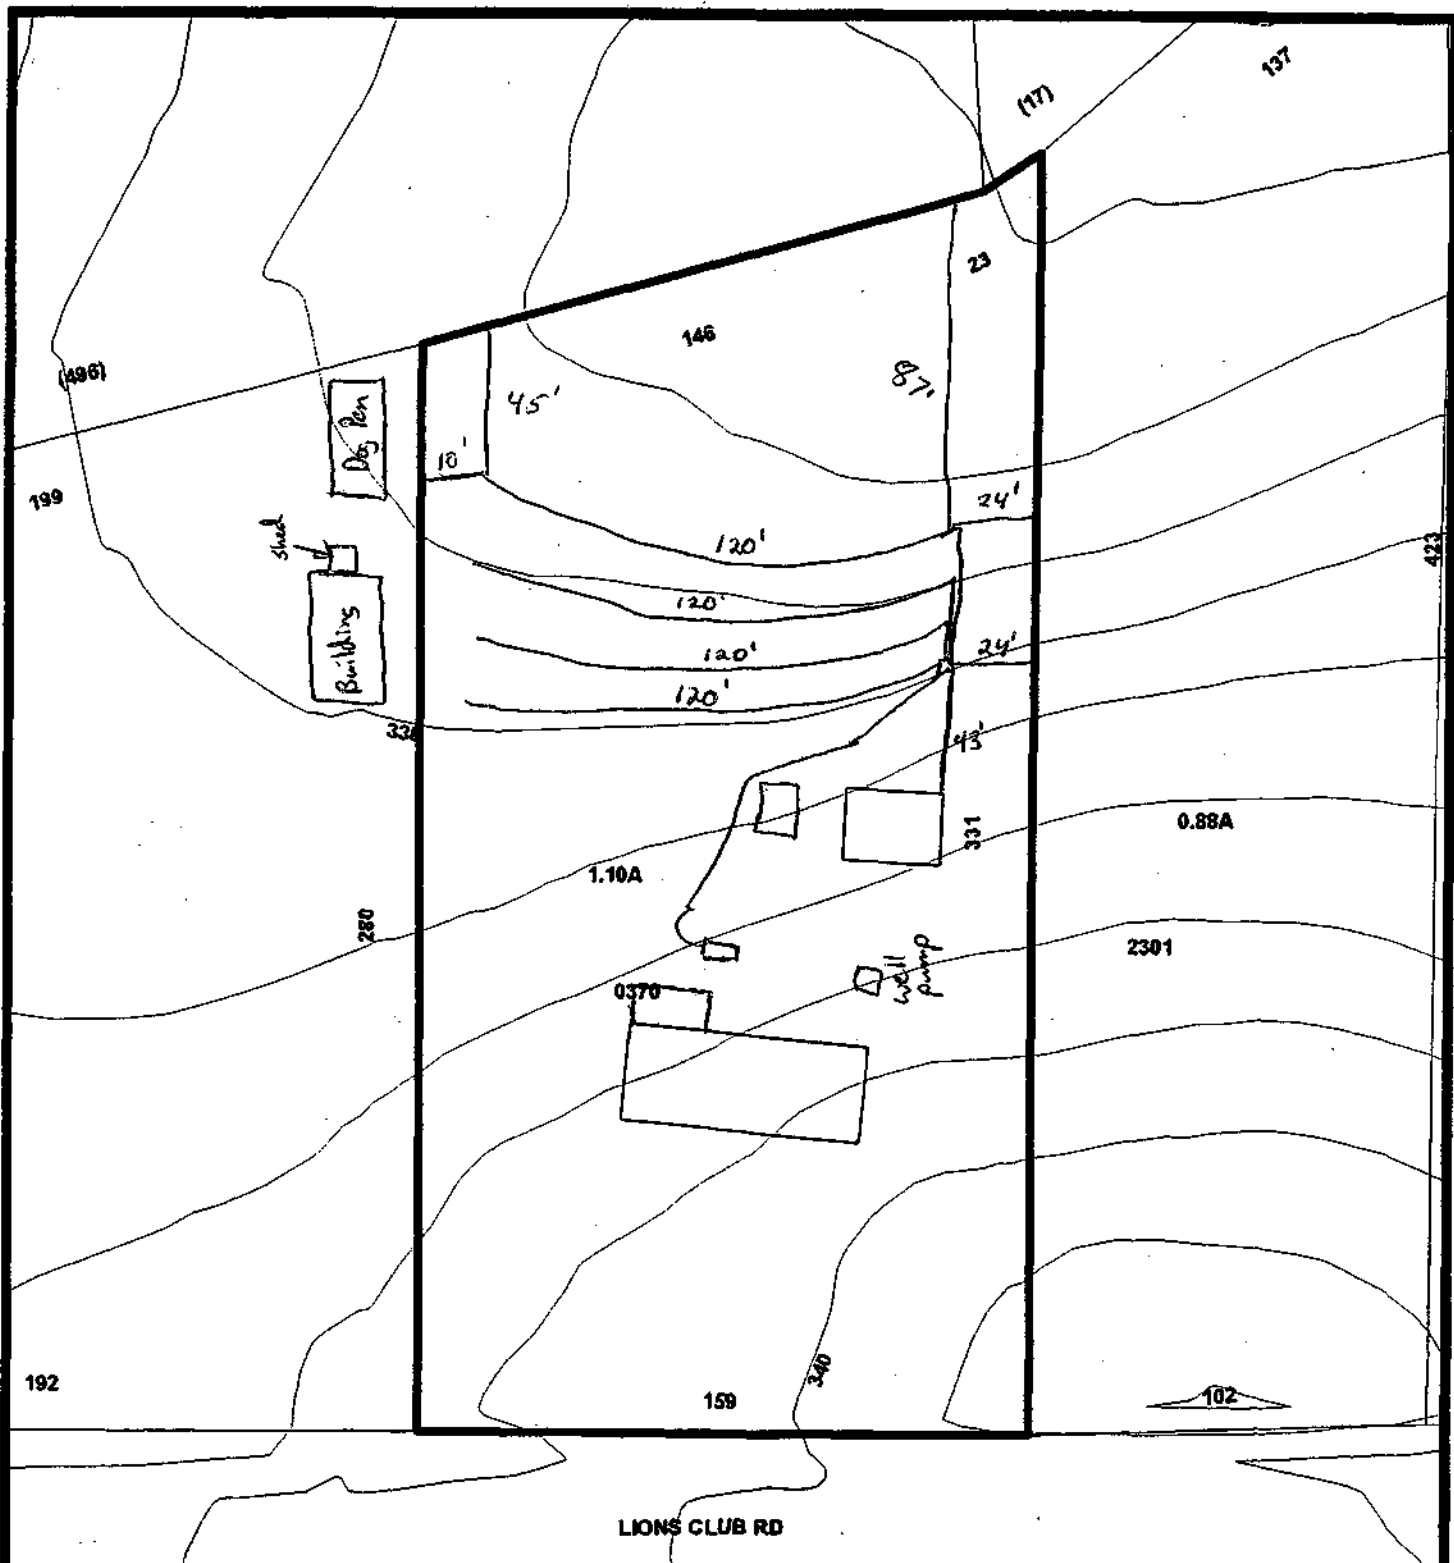


Environmental
Services

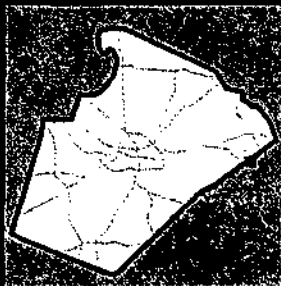

D 33171
As-Built



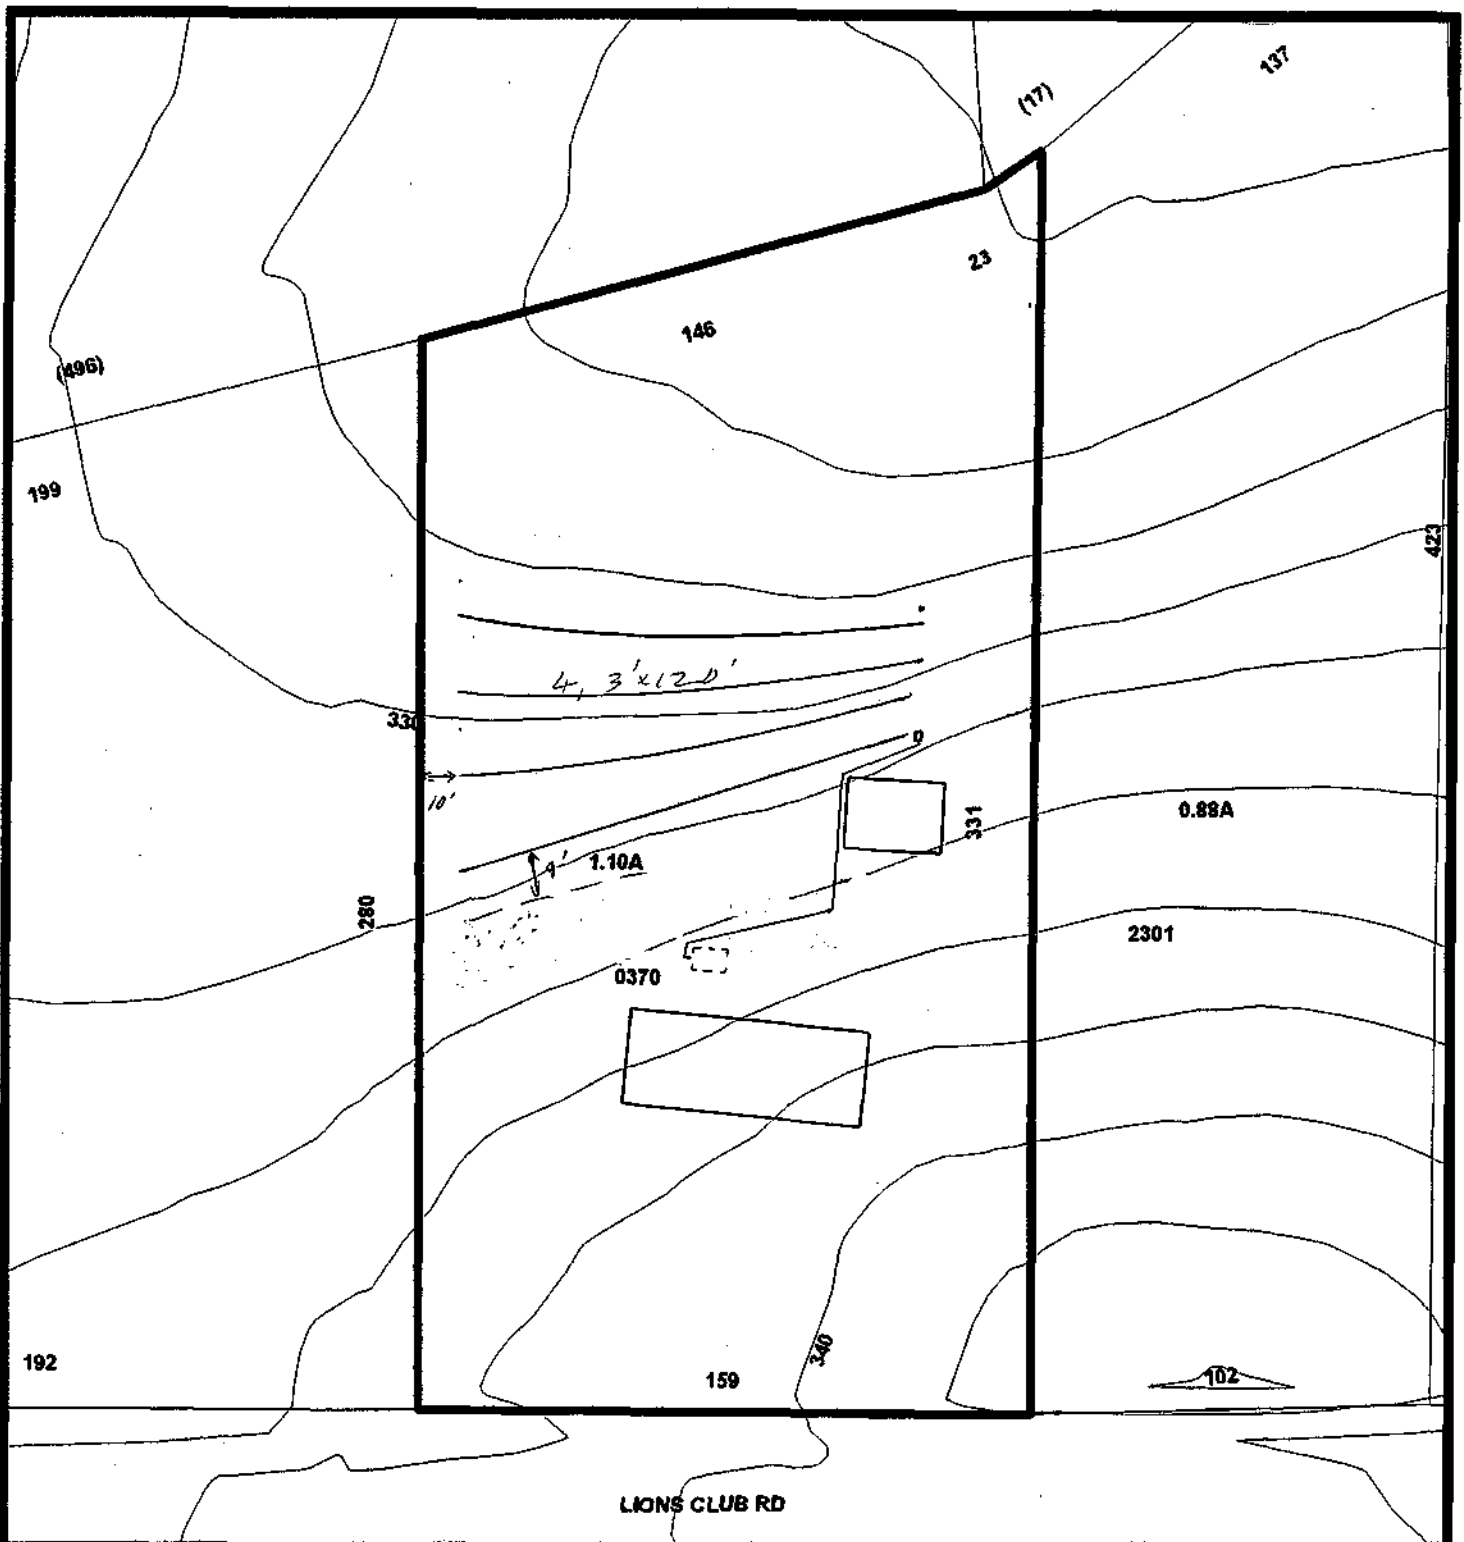


**Environmental
Services**



*D33171
Construction Authorization
Site Plan*



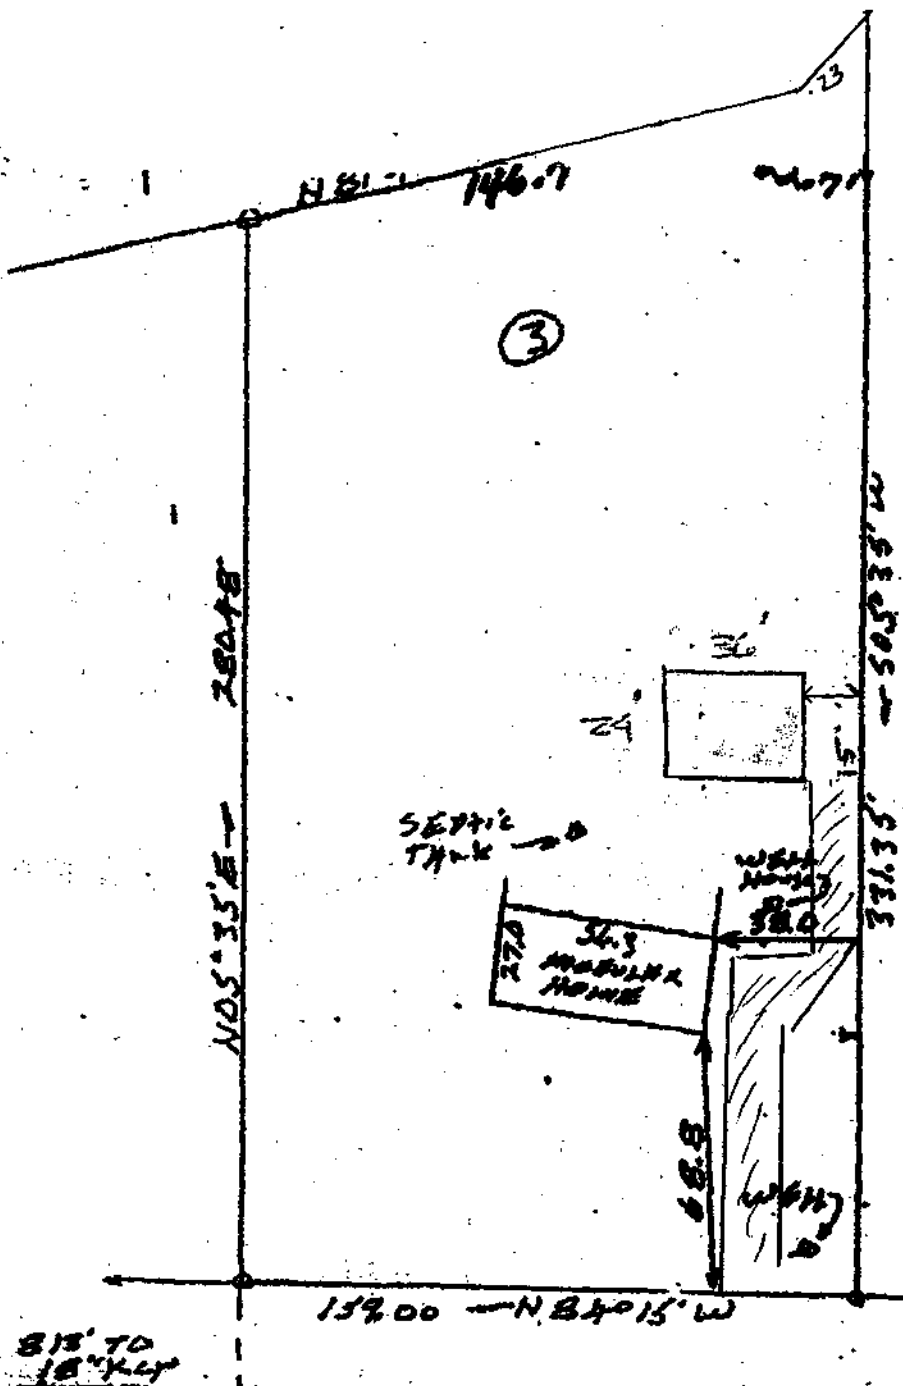

Site plan approved as shown for Detached Garage
 Any changes to site plan voids approval. All setbacks apply
 for septic systems and wells, regarding any pools, decks,
 additions and/or accessory structures. Applicant is responsible
 for protecting all portions of the septic system, repair area and
 wells from damage during construction. Adhere to all Local and
 State Rules.
 Approved by Christie H. Hays Date 3-10-11
 Wake County Department of Environmental Services,
 Water and Waste Water Section

PROPOSED HOUSE
 LOCATION



MAP REF: PROPERTY SURVEY FOR:
 JERRY UPCHURCH BY HAROLD B. MULLIN
 DATED MARCH 14, 1975
 DEED REFERENCE BOOK 5742 PAGE 111

I, WALTER B. BUNN, hereby certify that,
 on the date shown, this map is correct and
 that the buildings lie wholly on the lot and
 that there are no encroachments of other
 buildings on the said lot.

Walter B. Bunn
 Registered Surveyor

PROPERTY OF
 LUIS MENDEZ
 CLAUDIA GONZALEZ
 869 LIONS CLUB ROAD, WEAVER DAM, NC,
 HAYES CREEK TOWNSHIP, WAKE CO., NC

SCALE:
 1" = 50'
 DATE:
 7-29-96
 BOOK:
 964, P. 27

WALTER B. BUNN
 Land Surveying - L-1078
 Zebulon, N. C.