

WAKE COUNTY DEPARTMENT OF ENVIRONMENTAL SERVICES WASTEWATER PERMIT
NO PERMIT(S) FOR CONSTRUCTION, LOCATION OR RELOCATION ACTIVITY SHALL BE ISSUED UNTIL AN
AUTHORIZATION FOR WASTEWATER SYSTEM CONSTRUCTION AUTHORIZATION HAS BEEN ISSUED
***PERMIT VOID IF NOT IN COMPLIANCE WITH ZONING REGULATIONS AND/OR IF SITE IS ALTERED OR
INTENDED USE CHANGED***

OPERATIONS PERMIT

PERMIT # D059435 **APPLICATION DATE:** 03/26/2018 **BLDG. PERMIT#:** 0183169
PIN: 1822938001 **RECORDED:** Yes
TOWNSHIP: 14 - New Light **JURISDICTION:** Wake County **ZONING:** R40W
APPLICANT: Richard A Newton Jr **BUSINESS PHONE:**
HOME PHONE:
MOBILE PHONE: (919) 669-9607

HD USE: 101A CONVENTIONAL ONE-FAMILY HOUSE **EXISTING USE:**
SITE ADDRESS: 2025 Pleasant Forest
SUBDIVISION: GALLOWAY **LOT:** 02 **ACRES:** 0.82
DIRECTIONS:

Systems defined as either type III-b, III-g with a pump, IV, V or VI, in accordance with the North Carolina administrative code 15A NCAC 18a .1961, table V as adopted by reference in the "Regulations Governing Wastewater Treatment Dispersal Systems in Wake County", requires Wake County Environmental Services to conduct periodic inspections of the system type pursuant to 15A NCAC 18a. 1961 (j). Fees for these inspections will be charged as per the approved Fee Schedule. In addition, all systems are to be operated and maintained as specified in 15A NCAC 18A .1961. This permit is based in part on information provided by the homeowner and/or his/her representative in the application submitted for this permit. The Environmental Health Specialist is not responsible for false or misleading information contained in the application. The environmental health specialist is also not responsible for concealed conditions on the property or for statements in this report that may have resulted from false or misleading statements provided to him/her in the application. Neither Wake County nor the Environmental Health Specialist warrants that the septic tank system will continue to function satisfactorily in the future or that the water supply will remain potable.

OPERATION PERMIT VALID FOR:

INSTALLED BY: THORNTON, ANTHONY F - 2534 - II

PROPRIETARY SYSTEM: EZ1203HG - EZFlow EZ 1203H Geo **PRETREATMENT SYSTEM:**

SYSTEM TYPE INSTALLED: III B

OPERATION PERMIT: STATUS: Issued **ISSUED BY:** Jeremy Davis **ISSUED DATE:** 4/12/2019

SEPTIC TANK: Mitchell Concrete - STB-381 - 1250 gallons **DATE OF MANUFACTURE:** 10/12/2018 **FILTER:** Polylok - PL-68

GREASE TRAP: **DATE OF MANUFACTURE:** **FILTER:**

DOSING PUMP TANK: Mitchell - PT-364 - 1200 gal - 25.6 gal/in **DATE OF MANUFACTURE:** 11/12/2018 **FILTER:**

CC1: 13 **ETM1:** 11 **CC2:** **ETM2:**

RECIRCULATION TANK: **DATE OF MANUFACTURE:**

CC1: **ETM1:** **CC2:** **ETM2:**

SEPTIC TANK ELEVATION: 7 **GREASE TRAP ELEVATION:** **DOSING PUMP TANK ELEVATION:** 7

RECIRCULATION TANK ELEVATION:

DISTRIBUTION DEVICE ELEVATION: 2

INSTALLED TRENCH DEPTH	INSTALLED AGGREGATE DEPTH	INSTALLED TRENCH LENGTH	INSTALLED TRENCH BOTTOM ELEVATION
24	12	55	7.6
24	12	60	6.62
24	12	80	6.04
24	12	100	5.54
24	12	130	4.62

ACTUAL PRESSURE HEAD: 2

ACTUAL FLOW RATE: 44

ACTUAL DOSE VOLUME: 218

SPECIFIC OPERATION REQUIREMENTS:

ISSUED BY:

A handwritten signature in blue ink, appearing to be 'J. J. J.', is written over a horizontal line.

DATE: 4/12/2019

PRELIMINARY PLOT PLAN FOR

2025 PLEASANT FOREST WAY

REF: B.M 2017 PG. 2510

NEW LIGHT TOWNSHIP



WAKE COUNTY, NORTH CAROLINA

MARCH 15, 2018

ZONING R-40W



SCALE 1"=60'

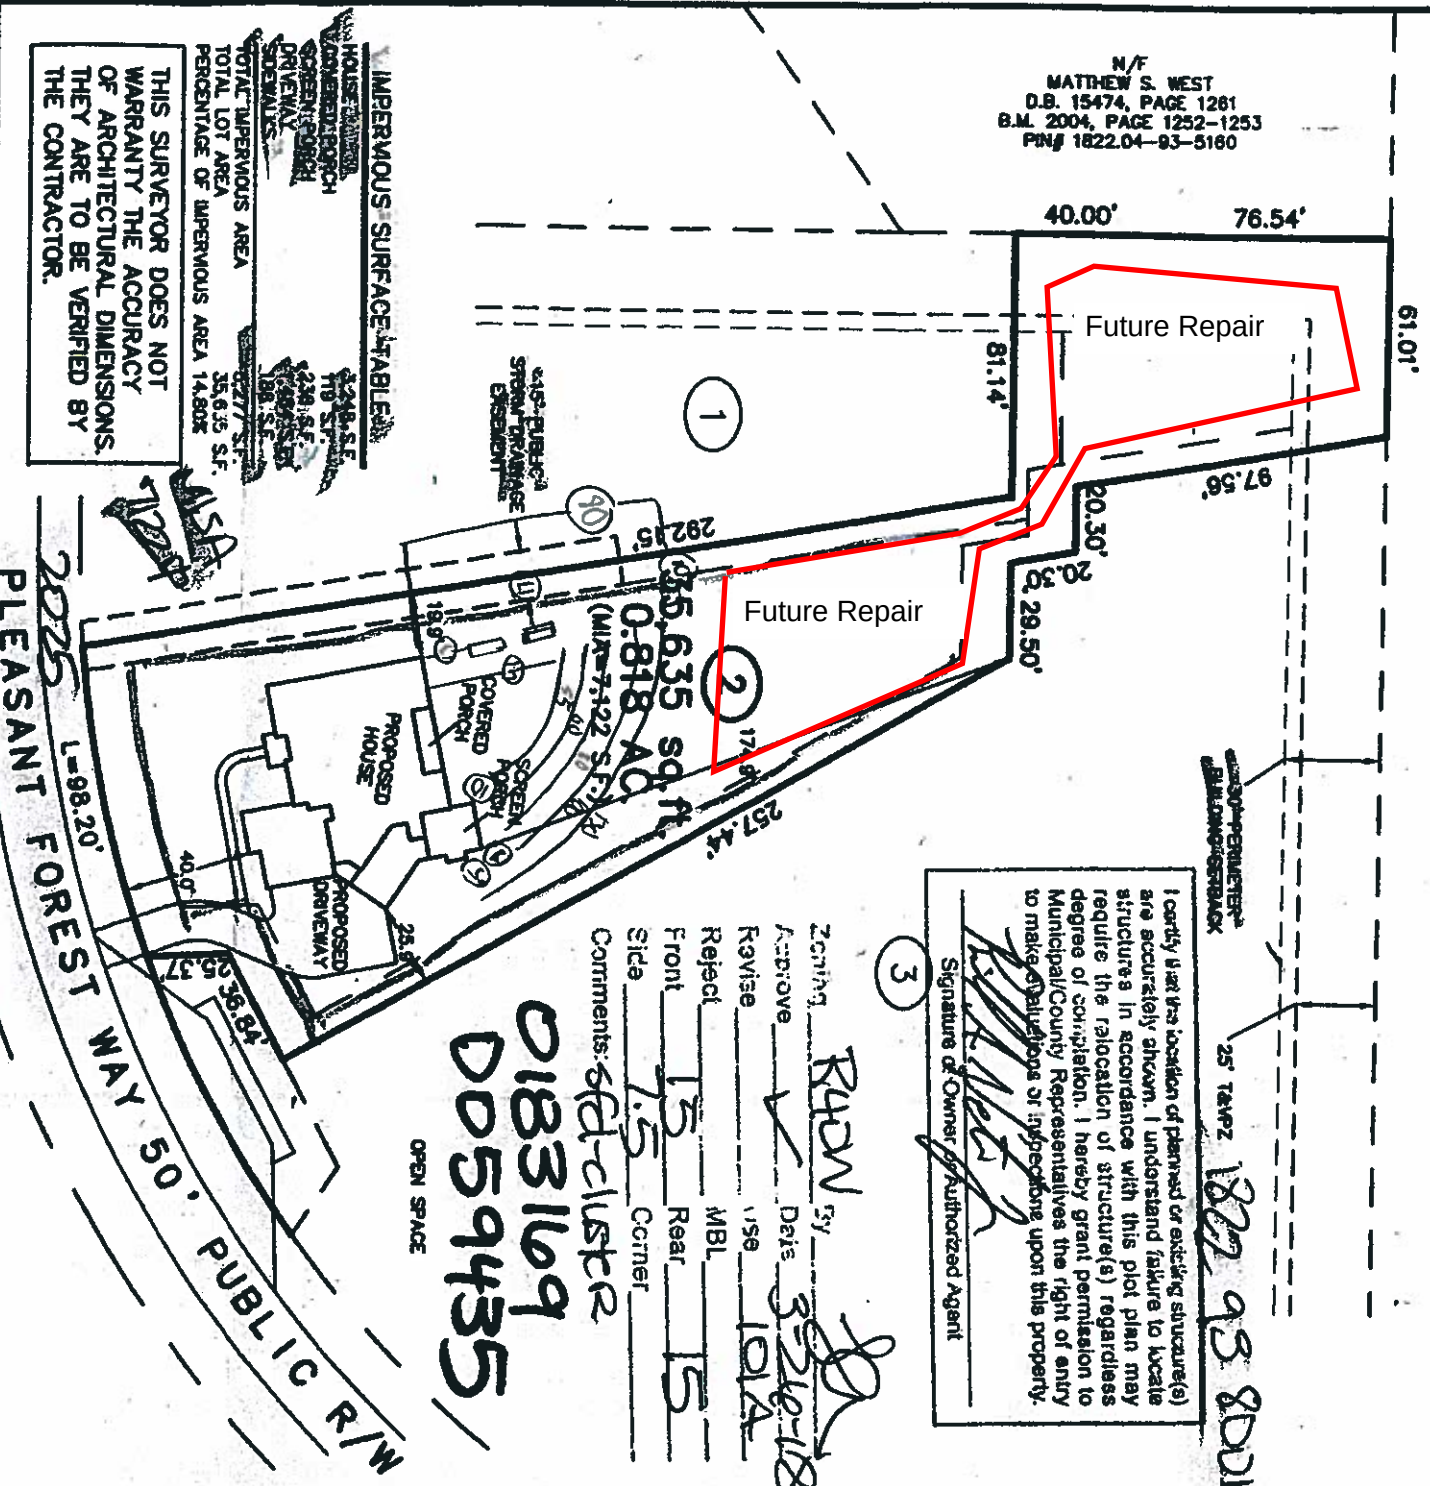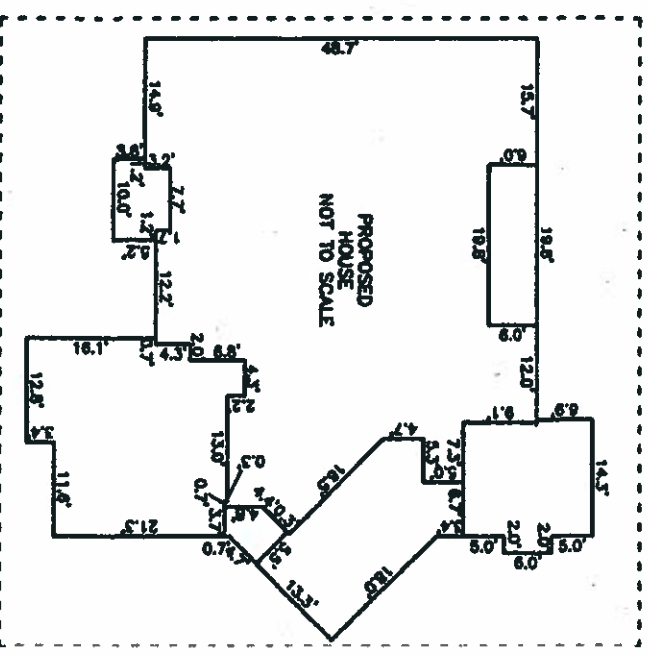

THIS SURVEYOR DOES NOT
WARRANTY THE ACCURACY
OF ARCHITECTURAL DIMENSIONS.
THEY ARE TO BE VERIFIED BY
THE CONTRACTOR.

2025 L=98.20'
PLEASANT F

CAWTHORNE, MOSS

& PANCIERA, P.C.

Professional Land Surveyors
C-1525

333 S. White Street
Post Office Box 1253
Wake Forest, N.C. 27588
(919)556-3148

NOTES

- THIS PLAN DOES NOT REFLECT AN ACTUAL SURVEY. IT IS A PRELIMINARY PLAN AND SHOULD BE USED FOR ITS INTENDED PURPOSE ONLY.

**-NOT FOR RECORDATION, CONVEYANCES,
OR SALES.**

