

Environmental Services - Water Quality
Onsite Wastewater Scan Data Entry Form

PERMIT #: 0009747

PIN #: 1617550183

OP DATE: 0610311998

SYSTEM USE:

- ☒ House
☐ Mobile Home
☐ Business
☐ Other

SEWAGE TYPE:

- ☒ Domestic
☐ Industrial

PUMP/SIPHON?:

- ☐ Yes
☒ No

PRESSURE MANIFOLD:

- ☐ Yes
☒ No

SYSTEM TYPE:

- ☐ I
☒ II
☐ III
☐ IV
☐ V
☐ VI
☐ Other

SUB TYPE:

- ☒ A
☐ B
☐ C
☐ D
☐ E
☐ F
☐ G

NBR BEDROOMS:

- ☐ 1
☐ 2
☒ 3
☐ 4
☐ 5
☐ 6
☐ Other

MAINT. SCHEDULE:

- ☐ Yes
☒ No

CERT. OPERATOR

- ☐ Yes
☒ No

GT ST PT SIZE

- | | | | |
|-------------------------------------|-------------------------------------|-------------------------------------|------------------|
| ☐ | ☐ | | 750 |
| ☐ | ☐ | ☐ | 900 |
| ☐ | ☒ | ☐ | 1,000 |
| ☐ | ☐ | ☐ | 1,200 |
| ☐ | ☐ | ☐ | 1,500 |
| ☐ | ☐ | ☐ | 1,800 |
| ☐ | ☐ | ☐ | 2,100 |
| ☐ | ☐ | ☐ | 2,500 |
| ☐ | ☐ | ☐ | 3,000 |
| ☐ | ☐ | ☐ | 4,000 |
| ☐ | ☐ | ☐ | 5,000 |
| ☐ | ☐ | ☐ | 8,000 |
| ☐ | ☐ | ☐ | 10,000 |
| ☐ | ☐ | ☐ | Other |
| ☒ | | ☒ | None/NA GT or PT |

DRAINFIELD SIZE(SQ. FT.)

01000

DRAIN TYPE:

- ☒ Stone
☐ EZ Flow
☐ Infiltrator
☐ Biodiffuser
☐ Cultec
☐ Drip
☐ Hancor
☐ Large Dia. Pipe
☐ Multi-Pipe
☐ Other

MAX DEPTH (IN.):

- ☐ 12 in. or less
☐ 18 in. or less
☒ 24 in. or less
☐ 26 in. or less
☐ 28 in. or less
☐ 30 in. or less
☐ 32 in. or less
☐ 36 in. or less
☐ Other

STONE DEPTH (IN.):

- ☐ 8 in. or less
☒ 12 in. or less
☐ 18 in. or less
☐ 24 in. or less
☐ Other

TRENCHES:

- ☒ Individual
☐ Bed

TRENCH WIDTH (IN.):

- ☐ 12 in. or less
☐ 18 in.
☐ 24 in.
☒ 36 in.
☐ 6 ft. or less
☐ 9 ft. or less
☐ Other

B.W 11/5/13

WAKE COUNTY DEPARTMENT OF ENVIRONMENTAL SERVICES WELL AND SEWAGE SITE LOCATION PERMIT

NO PERMIT(S) FOR CONSTRUCTION, LOCATION OR RELOCATION ACTIVITY SHALL BE ISSUED

UNTIL AN AUTHORIZATION FOR WASTEWATER SYSTEM CONSTRUCTION HAS BEEN ISSUED

PERMIT VOID IF NOT IN COMPLIANCE WITH ZONING REGULATIONS AND/OR IF SITE IS ALTERED OR INTENDED USE CHANGED

PERMIT#: D009747 STATUS: A APP DATE: 03/16/1998 BLDG PERMIT#: 0983126

APPLICANT: COMFORT HOMES DAY PHONE: (919) 553 - 3242

ADDRESS: P O BOX 369 FAX#: (000) 000 - 0000

CITY: CLAYTON STATE: NC ZIP: 27520

OWNER: JORDAN ASSOCIATES I LLC DAY PHONE: (919) 553 - 3242

ADDRESS: SAME FAX#: (000) 000 - 0000

CITY: CLAYTON STATE: NC ZIP: 27520

HD USE CD: 101 ONE-FAMILY HOUSE ORIG PERMIT#: REC?: Y

EXIST USE: TAX MAP#: 0846 0001

BEDROOMS: 3 BSMT: N #EMPLOYEES: 0 WATER: C WASTEWATER: I GARB DISPOS: N

TOWNSHIP: 15 PANTHER BRANCH JURIS: WC ZON: R30 PIN: 1617.03 44 7741 000

SUBD#: S 000 000 00 SUBD NAME: GLENN MEADOWS LOT-SEC: 12 ACRE:

IMPRV PRMT: ISSUED?: Y DATE: 04/29/1998 BY: GJ TYPE SYSTEM: II PUMP:

CNSTR AUTH: ISSUED?: Y DATE: 04/29/1998 BY: GJ DATE EXPIRED: 04/29/2003

RECEIPT#: 0026132 FEE: 145.00 OP DATE: BY:

WATR SAMPL: REQ?: N APPROVED?: DATE: PROPRIETARY SYS:

ST#: 6416 MI: DIR: NAME: BRACK PENNY DIR: TYP: RD

DIRECTIONS: 50 S TO R ON SR 2731 TO L ON SR 2732 SUB WILL B

E ON R

IMPROVEMENT PERMIT

SIZE OF TANK 1000 ST PT GALS. TOTAL SQ. FT. 1000 DEPTH OF STONE 12 IN. MAX. DEPTH LINE 24 IN.

WASTEWATER: DOMESTIC ☒ INDUSTRIAL ☐

I.P. ISSUED BY

Glenn John

AUTHORIZATION FOR WASTEWATER SYSTEM CONSTRUCTION

VOID SIXTY (60) MONTHS FROM DATE OF ISSUANCE

AUTHORIZATION CONDITIONS

Contractor To Follow Contours, See Attached Site Plan For Wastewater System Design And Well Location. The wastewater system shall not be covered or placed into use until inspected by the Wake County Department of Environmental Services and an Operation Permit issued.

OTHER CONDITIONS: SEPTIC FILTER REQUIRED, DUAL RISERS ON SEPTIC TANK REQUIRED

SIZE OF TANK 1000 ST PT GALS. TOTAL SQ. FT. 1000 DEPTH OF STONE 12 IN. MAX. DEPTH LINE 24 IN.

ST FILTER REQUIRED ☒ NUMBER OF TRENCHES 2 LENGTH OF TRENCHES 167 FT. WIDTH OF TRENCHES 3 FT.

C.A. ISSUED BY

Glenn John

INSTALLED BY

HRL Corp

CTR. I.D. #

SEPTIC TANK FILTER USED

INNOV. APPRL. #: IWWS-

DATE

6/3/98

INSTALLATION APPROVED BY

Glenn John

WELL SYSTEM = PRIVATE ☐ SEMI-PUBLIC ☒ NEW ☐ REPLACEMENT ☐ EXISTING ☐

WELL LOG INFORMATION = DEPTH CASING DEPTH YIELD STATIC LEVEL

WELL CONTRACTOR REG.# PUMP CONTRACTOR REG.#

CONSTRUCTION COMPLIANCE = GROUT APPROVED ☐ DATE EHS

WCHD ID # WELLHEAD APPROVED ☐ DATE EHS

NEGATIVE BACTERIOLOGICAL RESULTS ☐ DATE EHS

SYSTEM FINALIZED ☐ DATE EHS

COMMENTS:

This permit is based in part on information provided by the homeowner or his/her representative in the application submitted for this permit. The Environmental Health Specialist is not responsible for false or misleading information contained in the application. The Environmental Health Specialist is also not responsible for concealed conditions on the property or for statements in this report that may have resulted from false or misleading statements provided to him in the application. Neither Wake County nor the Environmental Health Specialist warrants that the septic tank system will continue to function satisfactorily in the future or that the water supply will remain potable.

AS BUILT

0903126

D. 9747

6416 BRACK
PENNY RD.

PRELIMINARY PLAN
NOT FOR RECORDATION
OR CONVEYANCE OR SALE

CG
3-16-98
101

R30

15
5

Comments: SETBACKS AS PER
RECORDED MAP- cluster sub-dir.

N 16°48'52"W

75.91'

MCP-1000

5788V

3-25-98

2x4x170


NOTE: BEING LOT 12 OF GLEN MEADOWS SUBD.
RECORDED IN BOM 1998 PG 419
NOTE: AREA COMPUTED BY COORDINATE METHOD.
NOTE: NO NCGS MONUMENT WITHIN 2000'

LOT 13

N 72°17'23"E

249.36'

side of

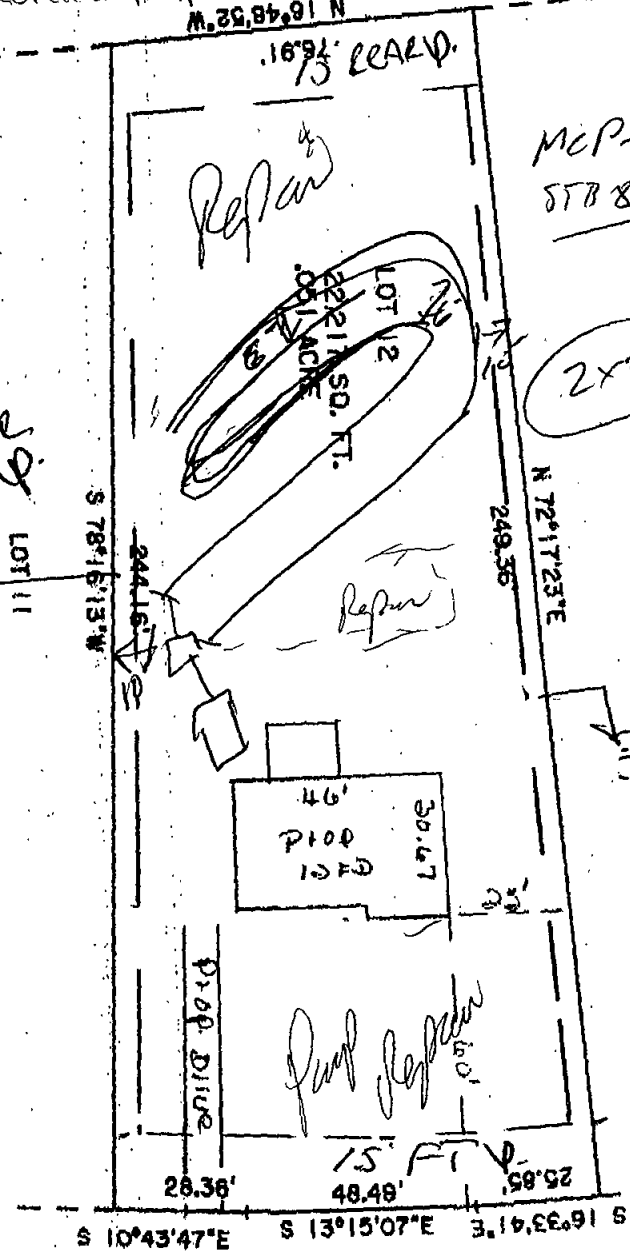


SR 2732 BRACK PENNY ROAD 60' PUBLIC R/W

I certify that the location of planned or existing structure(s) are accurately shown. I understand that failure to locate structures in accordance with this plot plan may require the relocation of structure(s) regardless degree of completion. I hereby grant permission to Municipal/County Representatives the right of entry to make evaluations or inspections upon this property.

Signature of Owner or Authorized Agent
Wayne Edwards 3-13-98

I, DANNY O. WILLIAMS, certify that under my direction and supervision this map was drawn from an actual field survey; that the error of closure of the survey as calculated by latitudes and departures is 1:10,000; and that this survey meets general standards of practice for land surveying in North Carolina.
Witness my hand and seal this 24 day of FEBRUARY, 1998

R.L.S. 1-2847

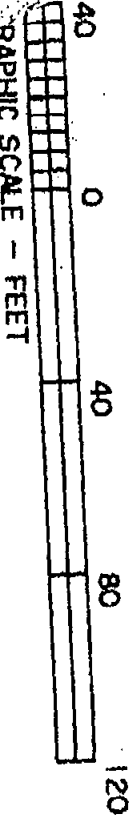

PLOT PLAN FOR
COMFORT HOMES
PANTHER BRANCH TOWNSHIP
WAKE COUNTY
NORTH CAROLINA

"ASHLEY" PLAN 1339

WILLIAMS, PEARCE & ASSOC., P.A.
REGISTERED LAND SURVEYORS
ZEBULON, NORTH CAROLINA
TELEPHONE: (919) 269-9609
DRAWN BY: CDR & K.L.H.
CHECKED BY: DOW
DATE: 02-24-98
SCALE: 1" = 40'
FILE: GLENN JOB: CDR44

0903126

D. 9747

6416 BRACK

Denny RD.

PRELIMINARY PLAN
NOT FOR RECORDATION
CONVEYANCE OR SALE

R30

CG
3-16098
101

15
5
15
15

Comments: SETBACKS AS PER
Recorded Map- Cluster Sub-Div.

N 16° 51' 18" W

16' 9" REAR D.

CONU.
REPAIR

LOT 12
22,217 SQ. FT.
0.51 ACRE

N 72° 17' 23" E

LOT 13

5' 10" SLOPE

S 78° 15' 13" W

LOT 11

46' 30.47
PROP
10' 5' 0"

PAV.
REPAIR

60' 0"

15' FT V

28.36'

48.49'

58' 52"

S 10° 43' 47" E

S 13° 15' 07" E

S 16° 33' 91" E

SR 2732 BRACK PENNY ROAD 60' PUBLIC R/W

2 LINES @ 3' X 167'

24" DEPTH

1000 ST

* SEPTIC FILTER
* DUAL RISERS ON SEPTIC TANK

I certify that the location of planned or existing structure(s) are accurately shown. I understand that failure to locate structures in accordance with this plot plan may require the relocation of structure(s) regardless of degree of completion. I hereby grant permission to Municipal/County Representatives the right of entry to make evaluations or inspections upon this property.


Wayne Edwards 3-13-98

Signature of Owner or Authorized Agent

I, DANNY O. WILLIAMS, certify that under my direction and supervision this map was drawn from an actual field survey; that the error of closure of the survey as calculated by latitudes and departures is 1:10,000; and that this survey meets general standards of practice for land surveying in North Carolina.

Witness my hand and seal this 24th day of FEBRUARY, 1998

R.L.S. L-2667

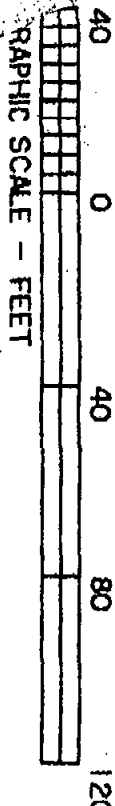

LOT 11
PLOT PLAN FOR
COMFORT HOMES
PANTHER BRANCH TOWNSHIP

WAKE COUNTY
NORTH CAROLINA

"ASHLEY" PLAN 1339

WILLIAMS, PEARCE & ASSOC., P.A.
REGISTERED LAND SURVEYORS
ZEBULON, NORTH CAROLINA
TELEPHONE: (919) 269-9605

DRAWN BY: CDR & K.H.

CHECKED BY: DOW

DATE: 02-24-98

SCALE: 1" = 40'

FILE:GLEMM JOB:CDR44