

Environmental Services - Water Quality
Onsite Wastewater Scan Data Entry Form

PERMIT #: 0030028

PIN #: 0689672091

OP DATE: 0811312004

SYSTEM USE:

- ☒ House
☐ Mobile Home
☐ Business
☐ Other

SEWAGE TYPE:

- ☒ Domestic
☐ Industrial

PUMP/SIPHON?:

- ☐ Yes
☒ No

PRESSURE MANIFOLD:

- ☐ Yes
☒ No

SYSTEM TYPE:

- ☐ I
☐ II
☒ III
☐ IV
☐ V
☐ VI
☐ Other

SUB TYPE:

- ☐ A
☐ B
☐ C
☐ D
☐ E
☐ F
☒ G

NBR BEDROOMS:

- ☐ 1
☐ 2
☐ 3
☒ 4
☐ 5
☐ 6
☐ Other

MAINT. SCHEDULE:

- ☐ Yes
☒ No

CERT. OPERATOR

- ☐ Yes
☒ No

GT	ST	PT	SIZE
☐	☐		750
☐	☐	☐	900
☐	☐	☐	1,000
☐	☒	☐	1,200
☐	☐	☐	1,500
☐	☐	☐	1,800
☐	☐	☐	2,100
☐	☐	☐	2,500
☐	☐	☐	3,000
☐	☐	☐	4,000
☐	☐	☐	5,000
☐	☐	☐	8,000
☐	☐	☐	10,000
☐	☐	☐	Other
☒		☒	None/NA GT or PT

DRAINFIELD SIZE(SQ. FT.)

01206

Include
w-2043

DRAIN TYPE:

- ☐ Stone
☒ EZ Flow
☐ Infiltrator
☐ Biodiffuser
☐ Cultec
☐ Drip
☐ Hancor
☐ Large Dia. Pipe
☐ Multi-Pipe
☐ Other

MAX DEPTH (IN.):

- ☐ 12 in. or less
☐ 18 in. or less
☒ 24 in. or less
☐ 26 in. or less
☐ 28 in. or less
☐ 30 in. or less
☐ 32 in. or less
☐ 36 in. or less
☐ Other

STONE DEPTH (IN.):

- ☐ 8 in. or less
☒ 12 in. or less
☐ 18 in. or less
☐ 24 in. or less
☐ Other

TRENCHES:

- ☒ Individual
☐ Bed

TRENCH WIDTH (IN.):

- ☐ 12 in. or less
☐ 18 in.
☐ 24 in.
☒ 36 in.
☐ 6 ft. or less
☐ 9 ft. or less
☐ Other

B.w 7/24/14

WAKE COUNTY DEPARTMENT OF ENVIRONMENTAL SERVICES WELL AND SEWAGE SITE LOCATION PERMIT
NO PERMIT(S) FOR CONSTRUCTION, LOCATION OR RELOCATION ACTIVITY SHALL BE ISSUED
UNTIL AN AUTHORIZATION FOR WASTEWATER SYSTEM CONSTRUCTION HAS BEEN ISSUED

PERMIT VOID IF NOT IN COMPLIANCE WITH ZONING REGULATIONS AND/ OR IF SITE IS ALTERED OR INTENDED USE CHANGED

PERMIT#: D030028 STATUS: A APP. DATE: 04/06/2004 BLDG. PERMIT#: 0042938
PIN: 0689.02 67 4562 000 TAX MAP: 0745 0085 RECORDED: Y ORIG. PERMIT#:
TOWNSHIP: 18 SWIFT CREEK JURISDICTION: WC ZONING: R30
APPLICANT: TRIPP LOYD BUILDERS
2506 RELIANCE AVE
APEX, NC 27539
(919) 387 - 1455
USE: HD USE: 101 ONE-FAMILY HOUSE
EXIST USE:
DISPOSAL: BEDROOMS: 4 BASEMENT: N #EMPLOYEES: 5
SITE: ADDRESS: 3740 WESTBURY LAKE DR
SUBDIVISION: WESTBURY MANOR LOT: 13 ACRES: 0.60
DIRECTION: LAKE WHEELER CROSS 1010 NEXT L IS WESTBURY LAKE

Well System: WATER: COMMUNITY - TYPE:

WELL LOG INFORMATION: DEPTH: _____ CASING DEPTH: _____ YIELD: _____ STATIC LEVEL: _____
WELLI CONTRACTOR: _____ REG.# _____ PUMP CONTRACTOR: _____ REG.# _____
Construction Compliance GROUT APPROVED ☐ DATE _____ EHS _____
WELLHEAD APPROVED ☐ DATE _____ EHS _____
SYSTEM FINALIZED ☐ DATE _____ EHS _____

COMMENTS:

Operation Permit

DESIGN FLOW: _____ gal./min. ACTUAL FLOW: _____ INNOVATIVE LETTER: R

INSTALLED BY: David Truelove INSTALLATION APPROVED BY: Jill McNally
PROPRIETARY SYSTEM: _____ FILTER NO: _____
COMMENTS:

OPERATIONS PERMIT ISSUED? Yes OP DATE: 8/13/04 BY: Jill McNally

This permit is based in part on information provided by the homeowner or his/her representative in the application submitted for this permit. The Environmental Health Specialist is not responsible for false or misleading information contained in the application. The Environmental Health Specialist is also not responsible for concealed conditions on the property or for statements in this report that may have resulted from false or misleading statements provided to him in the application. Neither Wake County nor the Environmental Health Specialist warrants that the septic tank system will continue to function satisfactorily in the future or that the water supply will remain potable.

As Built Information:

Date: 8/13 Benchmark: ST Rod reading: 1.10 Distance to Structure: _____
ST: 1200 gals ID#: 34 D.O.M.: 6/23/04 Elev.: 1.10 Distance to Well: _____
PT: _____ gals ID#: _____ D.O.M.: _____ Elev.: _____
D-box/FD/PM elev.: 3.7 Supply Line: _____ ft. Pump/Control Panel: _____
Line 1: 8.6 _____ Date: _____
Line 2: 7.8 _____ Date: _____
Line 3: 6.6 _____ Date: _____
Line 4: 5.11 _____ Date: _____
Line 5: _____ Date: _____
Distance to P/L: _____ Notes: _____

WAKE COUNTY DEPARTMENT OF ENVIRONMENTAL SERVICES WELL AND SEWAGE SITE LOCATION PERMIT

NO PERMIT(S) FOR CONSTRUCTION, LOCATION OR RELOCATION ACTIVITY SHALL BE ISSUED

UNTIL AN AUTHORIZATION FOR WASTEWATER SYSTEM CONSTRUCTION HAS BEEN ISSUED

PERMIT VOID IF NOT IN COMPLIANCE WITH ZONING REGULATIONS AND/ OR IF SITE IS ALTERED OR INTENDED USE CHANGED

PERMIT#: D030028 STATUS: A APP. DATE: 04/06/2004 BLDG. PERMIT#: 0042938
PIN: 0689.02 67 4562 000 TAX MAP: 0745 0085 RECORDED: Y ORIG. PERMIT#:
TOWNSHIP: 18 SWIFT CREEK JURISDICTION: WC ZONING: R30
APPLICANT: TRIPP LOYD BUILDERS
2506 RELIANCE AVE
APEX, NC 27539
(919) 387 - 1455
USE: HD USE: 101 ONE-FAMILY HOUSE
EXIST USE:
DISPOSAL: BEDROOMS: 4 BASEMENT: N #EMPLOYEES: 5 FOUND DRAIN:
SITE: ADDRESS: 3740 WESTBURY LAKE DR
SUBDIVISION: WESTBURY MANOR LOT: 13 ACRES: 0.60
DIRECTION: LAKE WHEELER CROSS 1010 NEXT L IS WESTBURY LAKE

IMPROVEMENT PERMIT

TANK SIZE: 1200 gal. PUMP Tank: ____ gal. SQ FT: 1206 INNOVATIVE MAX DEPTH LINE: 20 in.
WASTEWATER: INDIVIDUAL SEWAGE: DOMESTIC TYPE SYSTEM: III G PUMP: N P/M: Y
DAILY FLOW: 480 gal/day DESIGN FEE REQ?: PAID?: WATER: COMMUNITY

COMMENTS:

IP ISSUED? Y DATE: 04/15/2004 BY: (JEM) Jim McNeal PHONE#: _____

AUTHORIZATION FOR WASTEWATER/WATER SYSTEM CONSTRUCTION

VOID SIXTY (60) MONTHS FROM DATE OF ISSUANCE

AUTHORIZATION CONDITIONS:

Contractors shall install system on contours, see attached site plan for wastewater system design and well location. No underground utilities, water lines or sprinkler systems may be located in the original system or repair areas. A septic tank filter with a riser for access is required. The wastewater system shall not be covered or placed into use until inspected by the Wake County Department of Environmental Services and an Operation Permit issued. **OTHER CONDITIONS:**

INSTALL LINES ON CONTOUR. MAINTAIN ALL SETBACKS. IF SITE OR SITE PLAN CHANGES, PERMIT IS VOID. CALL PRIOR TO INSTALLATION WITH ANY QUESTIONS, COMMENTS OR CONCERNS. DO NOT GRADE OR REMOVE ANY SOIL FROM SEPTIC AREA OR REPAIR AREA. TAKE CARE NOT TO INSTALL UTILITIES OR IRRIGATION THROUGH SYSTEM OR REPAIR AREA.

TANK SIZE: 1200 gal. PUMP TANK: ____ gal. SQ FT: 1206 INNOVATIVE MAX DEPTH LINE: 20 in.
MAINT: N OPER: N L/O: N TRENCH#: 3 LENGTH: 105 ft. WIDTH: 36 in. DESIGNER: ____
SUBFIELDS: ____ DESIGN HEAD PRESSURE: ____ DESIGN FLOW: ____ gal/min DOSE VOLUME: ____ gal.

CA ISSUED? Y DATE: 04/15/2004 BY: (JEM) Jim McNeal PHONE#: _____

As Built

(Attention: Jill McWally
* Paradise Homes *)

Site Plan For Waste Water Layout

Lot: 13 Westbury Manor

Address: 3740 Westbury Lake


For: Tripp Loyd Builders
2506 Reliance Ave.
Apex, NC 27502

Phone: (919) 387-1455 or (919) 387-1456
Fax: (919) 387-1457

DIN: 068902674562

I certify that the location of planned or existing structures are accurately shown. I understand failure to locate structures in accordance with this plot plan may require the relocation of structure(s) regardless degree of completion. I hereby grant permission to Municipal/County Representatives the right of entry to make evaluations or inspections upon this property.

Signature of Owner or Authorized Agent

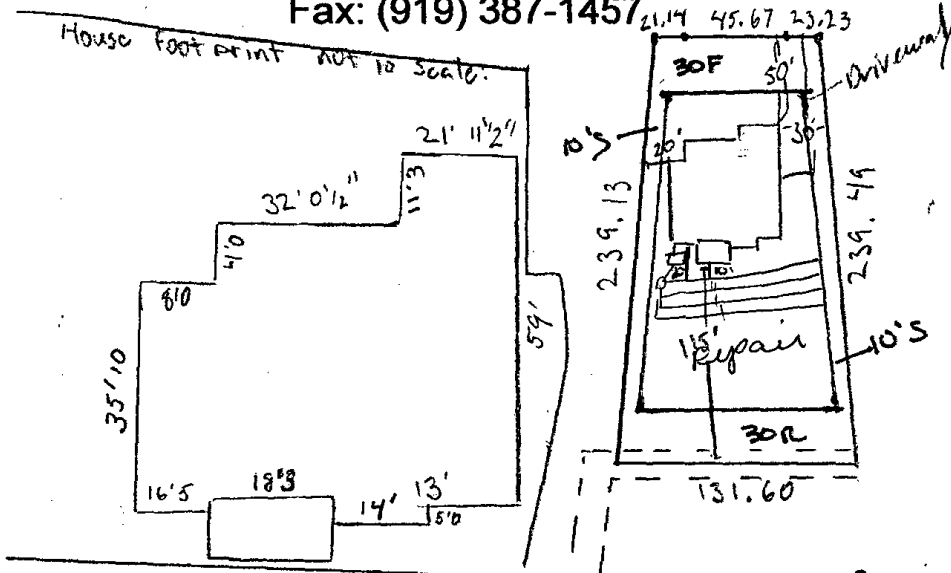

Scale: 1" = 100'

4 Bedrooms

Impervious:


House 3200

Driv/Walk 960
240
4400

$100 \times \frac{4400}{26342} = 16.7\%$

Zoning R30 By JLL
Approve ✓ Date 4.6.04
Revise Use 101
Reject MBL
Front 30 Rear 30
Side 10 Corner
Comments:

0042938
D30028

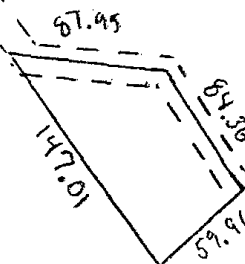

CA

(Attention: Jill McWally
* Parade Homes)

Site Plan For Waste Water Layout

Lot: 13 Westbury Manor

Address: 3740 Westbury Lake

For: Tripp Loyd Builders
2506 Reliance Ave.
Apex, NC 27502

Phone: (919) 387-1455 or (919) 387-1456

Fax: (919) 387-1457

DIN: 068902674562

I certify that the location of planned or existing structures are accurately shown. I understand failure to locate structures in accordance with this plot plan may require the relocation of structure(s) regardless degree of completion. I hereby grant permission to Municipal/County Representatives the right of entry to make evaluations or inspections upon this property.

Signature of Owner or Authorized Agent

Scale: 1" = 100'

4 Bedrooms


Impervious:

House 3200

Driv/Walk 960
240
4400

$100 \times \frac{4400}{26342} = 16.7\%$

Zoning R30 By JL
Approve ✓ Date 4.6.04
Revise Use 101
Reject MBL
Front 30 Rear 30
Side 100 Corner
Comments:

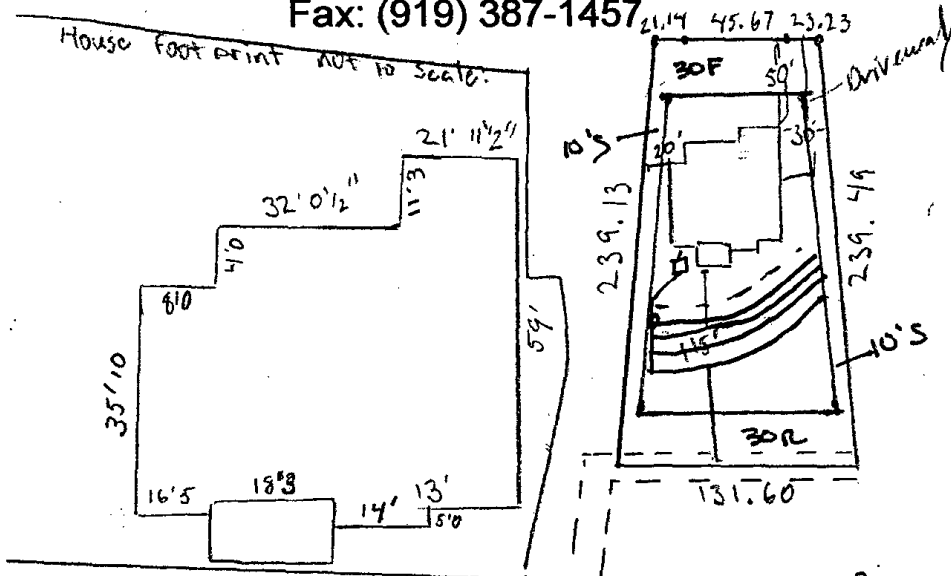


0042938
D30028

4x100'x3'
max depth 20"
1200 gallon ST

Ltar. 3

57.95

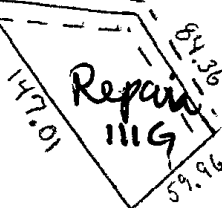

N52° 28' 30" W 131.60

15' PRIVATE SEPTIC EASEMENT

30' R

W02043

0070233

PLO# 068902672091

Signature of Owner or Authorized Agent


I certify that the location of planned or existing structure(s) are accurately shown. I understand failure to locate structures in accordance with this plot plan may require the relocation of structure(s) regardless degree of completion. I hereby grant permission to Municipal County Representatives the right of entry to make evaluations or inspections upon this property.

S32° 17' 55" W 239.49

10' SIDE

10' SIDE

E1662 E 41° 16' 24" N442.13

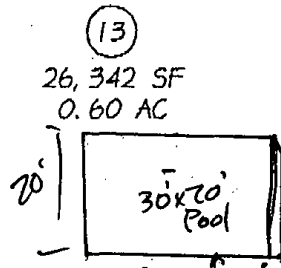

EXISTING FOUNDATION

Zoning R30 By OOL
Approve _____ Date 7-20-06
Revise _____ Use 3294
Reject _____ MBL
Front 30 Rear 30
Side 10 Corner _____
Comments:

Impervious:

House 3200
Driv/Walk 960
210
4400

100X 4400 = 16.7%

26342
Pool (NW) Walk
44400
800

5200

5200 < 5521 ✓

R=255.00 552° 28' 52" E 45.67 R=255.00
L=23.23 L=21.15

3740

WESTBURY LAKE DRIVE


50' R/W

REFERENCES

BOOK OF MAPS 2004 PAGES 557-559

THIS MAP IS NOT A CERTIFIED SURVEY AND HAS NOT BEEN REVIEWED BY A LOCAL GOVERNMENT AGENCY FOR COMPLIANCE WITH ANY APPLICABLE LAND DEVELOPMENT REGULATIONS

I, HEREBY CERTIFY, THAT THIS MAP IS CORRECT
AND THAT THE BUILDINGS LIE WHOLLY ON THE LOT

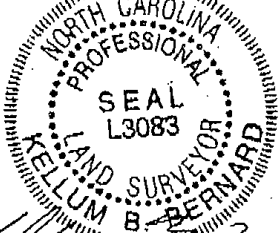

LANDS OF
LOYD BUILDERS, LLC

3740 WESTBURY LAKE DRIVE

WESTBURY PHASES 1, 2 & 3

WAKE COUNTY SWIFT CREEK TWP NORTH CAROLINA

DATE: 05-20-04 COMBINED SURVEYING RESOURCES

CIVIL ENGINEERS-PROFESSIONAL LAND SURVEYORS

SCALE: 1"=30'

3701 NATIONAL DRIVE SUITE 110