

Environmental Services - Water Quality
Onsite Wastewater Scan Data Entry Form

2-2

PERMIT #: 0003456

PIN #: 1720147882

OP DATE: 1012311987

Repair

SYSTEM USE:

- ☒ House
☐ Mobile Home
☐ Business
☐ Other

SEWAGE TYPE:

- ☒ Domestic
☐ Industrial

PUMP/SIPHON?:

- ☐ Yes
☒ No

PRESSURE MANIFOLD:

- ☐ Yes
☒ No

SYSTEM TYPE:

- ☐ I
☒ II
☐ III
☐ IV
☐ V
☐ VI
☐ Other

SUB TYPE:

- ☒ A
☐ B
☐ C
☐ D
☐ E
☐ F
☐ G

NBR BEDROOMS:

- ☐ 1
☐ 2
☐ 3
☒ 4
☐ 5
☐ 6
☐ Other

MAINT. SCHEDULE:

- ☐ Yes
☒ No

CERT. OPERATOR

- ☐ Yes
☒ No

GT ST PT

- ☐ ☐ ☐
☐ ☒ ☐
☐ ☐ ☐
☐ ☐ ☐
☒ ☐ ☒

SIZE

- 750
900 *Exst*
1,000
1,200
1,500
1,800
2,100
2,500
3,000
4,000
5,000
8,000
10,000
Other
None/NA GT or PT

DRAINFIELD SIZE(SQ. FT.)

00450

DRAIN TYPE:

- ☒ Stone
☐ EZ Flow
☐ Infiltrator
☐ Biodiffuser
☐ Cultec
☐ Drip
☐ Hancor
☐ Large Dia. Pipe
☐ Multi-Pipe
☐ Other

MAX DEPTH (IN.):

- ☐ 12 in. or less
☐ 18 in. or less
☐ 24 in. or less
☐ 26 in. or less
☐ 28 in. or less
☐ 30 in. or less
☐ 32 in. or less
☐ 36 in. or less
☒ Other

STONE DEPTH (IN.):

- ☐ 8 in. or less
☒ 12 in. or less
☐ 18 in. or less
☐ 24 in. or less
☐ Other

TRENCHES:

- ☒ Individual
☐ Bed

TRENCH WIDTH (IN.):

- ☐ 12 in. or less
☐ 18 in.
☐ 24 in.
☒ 36 in.
☐ 6 ft. or less
☐ 9 ft. or less
☐ Other

GA

1720 14 7882

10:30-11:00

WAKE COUNTY HEALTH DEPARTMENT WELL AND SEWAGE SITE, LOCATION PERMIT

Tax Map No. 728 Parcel No. 74No. **C** 03456

Contractor: _____

Operation Permit []

Owner: Worth DennisDate: September 30, 1987Location/Address: 702 Hillandale Ln

S.R. # _____

Subdivision Name: Hillandale Lot No. 19 Section or Block No. _____Zoning: Garner Township: St. Mary**Sewage System**

Repair [X] Original Permit No. _____

Garbage Disposal Unit Yes [] No []

House [X] Mobile Home [] Business []

No. Bedrooms Adding 2 (4) total Lot Area 30,550Size of Tank 1,000 gal.Nitrification Line 1 (3" x 150') 450 sq. ft.

Depth of Stone: 12" [X] Max. Depth of Trenches: _____ in.

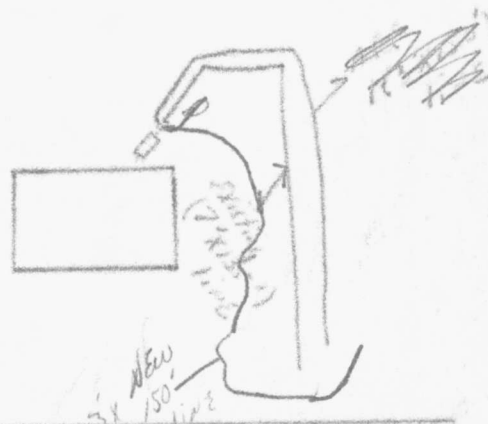
Riser and Baffle Required [] Pump Required []

Improvement Permit

*Permit Void 36 months from date of issuance

*Permit Void if not in compliance with zoning regulations

*Permit may be voided if site alterations made

Layout By: R.C. Sullivan R.S.Date 10/23/87Installed By Curtis JohnsonApproved By Robert E. Sullivan R.S.**Well System**

Individual [X] Semi-Public [] Public []

New [] Replacement [] Repair []

Fee Paid Yes [] No []

Construction Compliance Yes No

Site Approved [] []

Well Head Approved [] []

Grouting Approved [] []

Date Inspected _____

Sanitarian _____

Final Inspection Yes No

Required Slab [] []

Chlorinated [] []

Required Certificate [] []

Variance (Explain) [] []

WCHD I.D. Affixed [] []

Sample Collected [] []

**Well permit void 36 months from issuance date

Bacteriological Results

Initial Sample: _____ Date: _____

*Re-sample #1 _____ Date: _____

*Re-sample #2 _____ Date: _____

Re-chlorination as required Yes [] No []

Comments: _____

*\$10.00 fee for all re-samples

All checks payable to: **Wake County Health Department**

Well Installed By: _____

Date System Finalized _____

Sanitarian _____

This report is based in part on information provided by the homeowner or his/her representative in the application submitted for this permit. The sanitarian is not responsible for false or misleading information contained in the application. The sanitarian is also not responsible for concealed conditions on the property or for statements in this report that may have resulted from false or misleading statements provided to him in the application. Neither Wake County nor the sanitarian warrants that the septic tank system will continue to function satisfactorily in the future or that the water supply will remain potable.