

Environmental Services - Water Quality
Onsite Wastewater Scan Data Entry Form

PERMIT #: **B 0 0 5 4 7 1**

PIN #: **1 7 9 5 3 6 6 4 5 4**

OP DATE: **1 2 / 0 5 / 1 9 7 4**

SYSTEM USE:

- ☒ House
☐ Mobile Home
☐ Business
☐ Other

SEWAGE TYPE:

- ☒ Domestic
☐ Industrial

PUMP/SIPHON?:

- ☐ Yes
☒ No

PRESSURE MANIFOLD:

- ☐ Yes
☒ No

SYSTEM TYPE:

- ☐ I
☒ II
☐ III
☐ IV
☐ V
☐ VI
☐ Other

SUB TYPE:

- ☒ A
☐ B
☐ C
☐ D
☐ E
☐ F
☐ G

NBR BEDROOMS:

- ☐ 1
☐ 2
☒ 3
☐ 4
☐ 5
☐ 6
☐ Other

MAINT. SCHEDULE:

- ☐ Yes
☒ No

CERT. OPERATOR

- ☐ Yes
☒ No

GT ST PT

- | | | | |
|-------------------------------------|-------------------------------------|-------------------------------------|------------------|
| ☐ | ☐ | ☐ | 750 |
| ☐ | ☒ | ☐ | 900 |
| ☐ | ☐ | ☐ | 1,000 |
| ☐ | ☐ | ☐ | 1,200 |
| ☐ | ☐ | ☐ | 1,500 |
| ☐ | ☐ | ☐ | 1,800 |
| ☐ | ☐ | ☐ | 2,100 |
| ☐ | ☐ | ☐ | 2,500 |
| ☐ | ☐ | ☐ | 3,000 |
| ☐ | ☐ | ☐ | 4,000 |
| ☐ | ☐ | ☐ | 5,000 |
| ☐ | ☐ | ☐ | 8,000 |
| ☐ | ☐ | ☐ | 10,000 |
| ☒ | ☐ | ☒ | Other |
| | | | None/NA GT or PT |

DRAINFIELD SIZE(SQ. FT.)

0 0 9 0 0

DRAIN TYPE:

- ☒ Stone
☐ EZ Flow
☐ Infiltrator
☐ Biodiffuser
☐ Cultec
☐ Drip
☐ Hancor
☐ Large Dia. Pipe
☐ Multi-Pipe
☐ Other

MAX DEPTH (IN.):

- ☐ 12 in. or less
☐ 18 in. or less
☐ 24 in. or less
☐ 26 in. or less
☐ 28 in. or less
☐ 30 in. or less
☐ 32 in. or less
☐ 36 in. or less
☒ Other

STONE DEPTH (IN.):

- ☐ 8 in. or less
☐ 12 in. or less
☒ 18 in. or less
☐ 24 in. or less
☐ Other

TRENCHES:

- ☐ Individual
☒ Bed

TRENCH WIDTH (IN.):

- ☐ 12 in. or less
☐ 18 in.
☐ 24 in.
☐ 36 in.
☒ 6 ft. or less
☐ 9 ft. or less
☐ Other

WAKE COUNTY HEALTH DEPARTMENT
SEPTIC TANK LAYOUT AND PERMIT

PERMIT NO. **B 5471**

Zebulon Zoning
Existing house

OWNER OR CONTRACTOR Billy Hinton

DATE 11-13-74

LOCATION Turn off 1st By-pass (Zebulon beside water works 1/2 mile on left.

S. R. NO. 2370

SUBDIVISION NAME 1032 Water Plant Rd

LOT NO. _____

SECTION OR BLOCK NO. _____

GARBAGE DISPOSAL UNIT YES ☐ NO ☒

HOUSE ☒ MOBILE HOME ☐ BUSINESS ☐ Existing

NO. BEDROOMS 2 LOT AREA 40,000 sq. ft.


SIZE OF TANK 900 gal.

NITRIFICATION LINE (150' x 6") 900 sq. ft.

DEPTH OF STONE IN LINES: 12" ☐ 18" ☒

WATER SUPPLY: INDIVIDUAL ☒ PUBLIC ☐

* PERMIT VOID 12 MONTHS FROM DATE OF ISSUANCE.

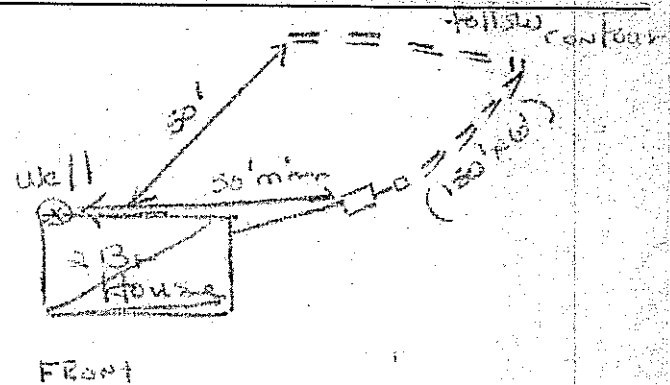

Front

LAYOUT BY James R. Braum

12-5-74

DATE

Bobby McGee

INSTALLED BY

James R. Braum

APPROVED BY

2) IF NOT IN COMPLIANCE WITH ZONING REGULATIONS

CERTIFICATE OF COMPLETION

WAKE COUNTY HEALTH DEPARTMENT SEPTIC TANK LAYOUT AND PERMIT

PERMIT NO.

NTRACTOR

DATE

S. R. NO

NAME:

LOT NO.

SECTION OR BLOCK NO

POSAL UNIT YES ☐ NO ☒

MOBILE HOME ☐ BUSINESS ☐

IS 10-1-1 LOT AREA 3.33 gal.


N LINE 101.51 sq. ft.

ONE IN LINES: 12"  18" 

INDIVIDUAL ☒ PUBLIC ☐

12 MONTHS FROM DATE OF ISSUANCE.

1-5-80
Q# 1531
(1350⁰⁰)

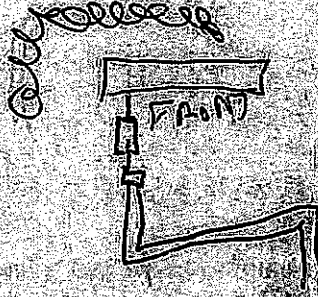

18 / 79



 INSTALLED BY

APPROVED BY Robert D. Glaze