


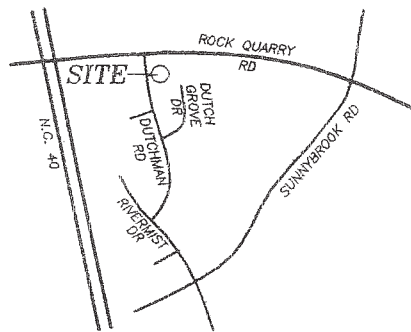

VICINITY MAP
(N.T.S.)

FLOOD CERTIFICATION

THIS WILL CERTIFY THAT THE SUBJECT
PROPERTY () IS or (X) IS NOT

located in a SPECIAL FLOOD HAZARD AREA as
determined by the Department of Housing and
Urban Development, or as shown on the
FLOOD INSURANCE RATE MAP.

370243 1722 J
COMMUNITY # PANEL SUFFIX

Jeffrey H. Davis, PLS
PROFESSIONAL LAND SURVEYOR

NOTE:
THIS PROPERTY DOES NOT LIE WITHIN
2000' OF A N.C.G.S. MONUMENT.

THIS SURVEY IS OF AN EXISTING PARCEL
OR PARCELS OF LAND.

UTILITIES SHOWN ARE FOR REPRESENTATION
ONLY AND NOT TO BE USED FOR
PROPERTY LINE LOCATION

ALL CREEKS, EASEMENTS, BUFFERS,
FLOOD LIMITS & SETBACKS TAKEN
FROM TAX MAP 1722.09, BLOCK 16.

I, Jeffrey H. Davis, PLS, certify this map was drawn under
my supervision from an actual survey made under my supervision;
and that the error of closure as calculated by latitudes and
departures is 1/10,000+; that the boundaries not surveyed
are shown as broken lines plotted from information found in
Book —; Page —; that this map was prepared in
accordance with G.S. 47-30 amended.

Witness my original signature, registration number and seal this
2ND day of APRIL, 2016.

Signed

Seal

LEGEND

- EXISTING IRON PIPE
- NEW IRON PIPE
- NAIL FOUND
- COMPUTED CORNER
- POWER BOX
- TELE
- CATV
- LIGHT POLE
- UTILITY POLE
- FIRE HYDRANT

TIE POINT PKNAIL FOUND AT
THE CENTERLINE INTERSECTION
OF DUTCHMAN ROAD & ROCK
QUARRY ROAD

ROCK QUARRY ROAD
S.R. 2542 (90' R/W)

LINE TABLE		
LINE	LENGTH	BEARING
L1	19.82'	N88°33'55"W
L2	12.35'	N10°38'55"E
L3	210.00'	S81°01'22"E
L4	66.72'	S10°19'17"W
L5	8.06'	N69°50'22"W
L6	5.00'	S05°22'59"W

LOT 20
H.M. & D.S.
WALL PROPERTY
DB 15633, PG 0214
BOM 2000, PG 2079

DUTCHMAN ROAD
(60' R/W)
BOM 1967, PG 224

LOT 1 REVISED
H.M. & D.S. WALL PROPERTY
DB 15810, PG 2500
BOM 2000, PG 2079

N/F GLENN
E. GOODWIN
PEGGY W. GOODWIN
DB 7903, PG 0840
BOM 1998, PG 0332

OPEN SPACE
DUTCHMAN CREEK
PHASE 4
BOM 2006, PG 0690

DUTCHMAN CREEK
PHASE 4
BOM 2006, PG 0690

N/F CAROLYN E. RATLIFF
DB 1522, PG 0248

INGRESS/EGRESS
EASEMENT
D.B. 1522, PG 0248

PARCEL 4977
TAX MAP 1722.09
BLOCK 16
GROSS AREA 2.11 ACRES
R/W AREA 0.11 ACRES
NET AREA 2.00 ACRES

PART OF LOT A
D.B. 14398, PG 1373

N/F BOYD WATSON HOLDER
DB 14398, PG 1370 BOM 1952, PG 062

PHANHOA
TRAN

PARCEL 4977
TAX MAP 1722.09, BLOCK 16
3412 ROCK QUARRY ROAD
RALEIGH
NORTH CAROLINA

DATE: 05-02-2016

JOB NO. B-2484

SCALE: 1" = 60'

C.N. = 23888

B.O.M. D.B. 4177

PAGE 0025


WAKE CO. REG.

DWG. NO.

B-2484

TURNING POINT
SURVEYING PLLC

4113 JOHN S. RABOTEAU WYND
RALEIGH, NORTH CAROLINA 27612
FAX (800)948-0213 PH (919)781-0234
License No: P-0121

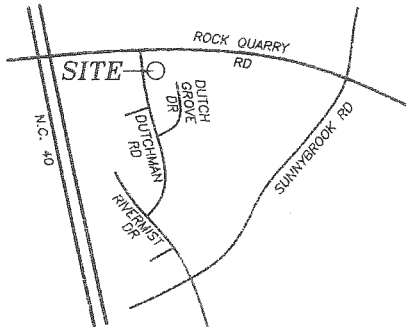

VICINITY MAP
(N.T.S.)

FLOOD CERTIFICATION

THIS WILL CERTIFY THAT THE SUBJECT PROPERTY () IS or (X) IS NOT located in a SPECIAL FLOOD HAZARD AREA as determined by the Department of Housing and Urban Development, or as shown on the FLOOD INSURANCE RATE MAP.

370243 1722 J
COMMUNITY # PANEL SUFFIX

Jeffrey H. Davis, PLS
PROFESSIONAL LAND SURVEYOR

NOTE:
THIS PROPERTY DOES NOT LIE WITHIN 2000' OF A N.C.G.S. MONUMENT.

THIS SURVEY IS OF AN EXISTING PARCEL OR PARCELS OF LAND.

UTILITIES SHOWN ARE FOR REPRESENTATION ONLY AND NOT TO BE USED FOR PROPERTY LINE LOCATION


ALL CREEKS, EASEMENTS, BUFFERS, FLOOD LIMITS & SETBACKS TAKEN FROM BOM 2011, PG 496

I, Jeffrey H. Davis, PLS, certify this map was drawn under my supervision from an actual survey made under my supervision; and that the error of closure as calculated by latitudes and departures is 1/10,000+; that the boundaries not surveyed are shown as broken lines plotted from information found in Book —; Page —; that this map was prepared in accordance with G.S. 47-30 amended.

Witness my original signature, registration number and seal this 3RD day of JUNE 2016.



Signed *Jeffrey H. Davis*
Seal

- LEGEND**
- EXISTING IRON PIPE
 - NEW IRON PIPE
 - NAIL FOUND
 - COMPUTED CORNER
 - POWER BOX
 - TELE
 - CATV
 - LIGHT POLE
 - UTILITY POLE
 - FIRE HYDRANT

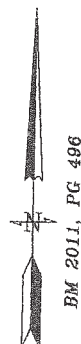


LOT 20
H.M. & D.S.
WALL PROPERTY
DB 15633, PG 0214
BOM 2000, PG 2079

LOT 1 REVISED
H.M. & D.S. WALL PROPERTY
DB 15810, PG 2500
BOM 2000, PG 2079

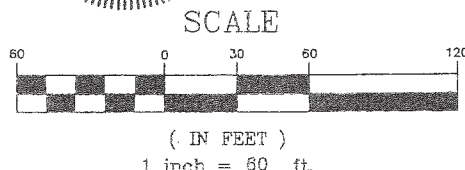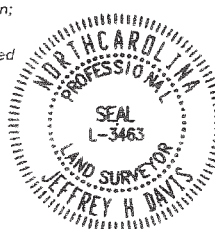


TIE POINT PKNAIL FOUND AT THE CENTERLINE INTERSECTION OF DUTCHMAN ROAD & ROCK QUARRY ROAD
ROCK QUARRY ROAD
S.R. 2542 (90' R/W)

LINE TABLE		
LINE	LENGTH	BEARING
L1	12.34'	N03°53'21"E
L2	209.94'	S87°46'49"E
L3	66.72'	S03°35'03"W
L4	7.82'	N76°39'04"W
L5	5.00'	S01°25'43"E

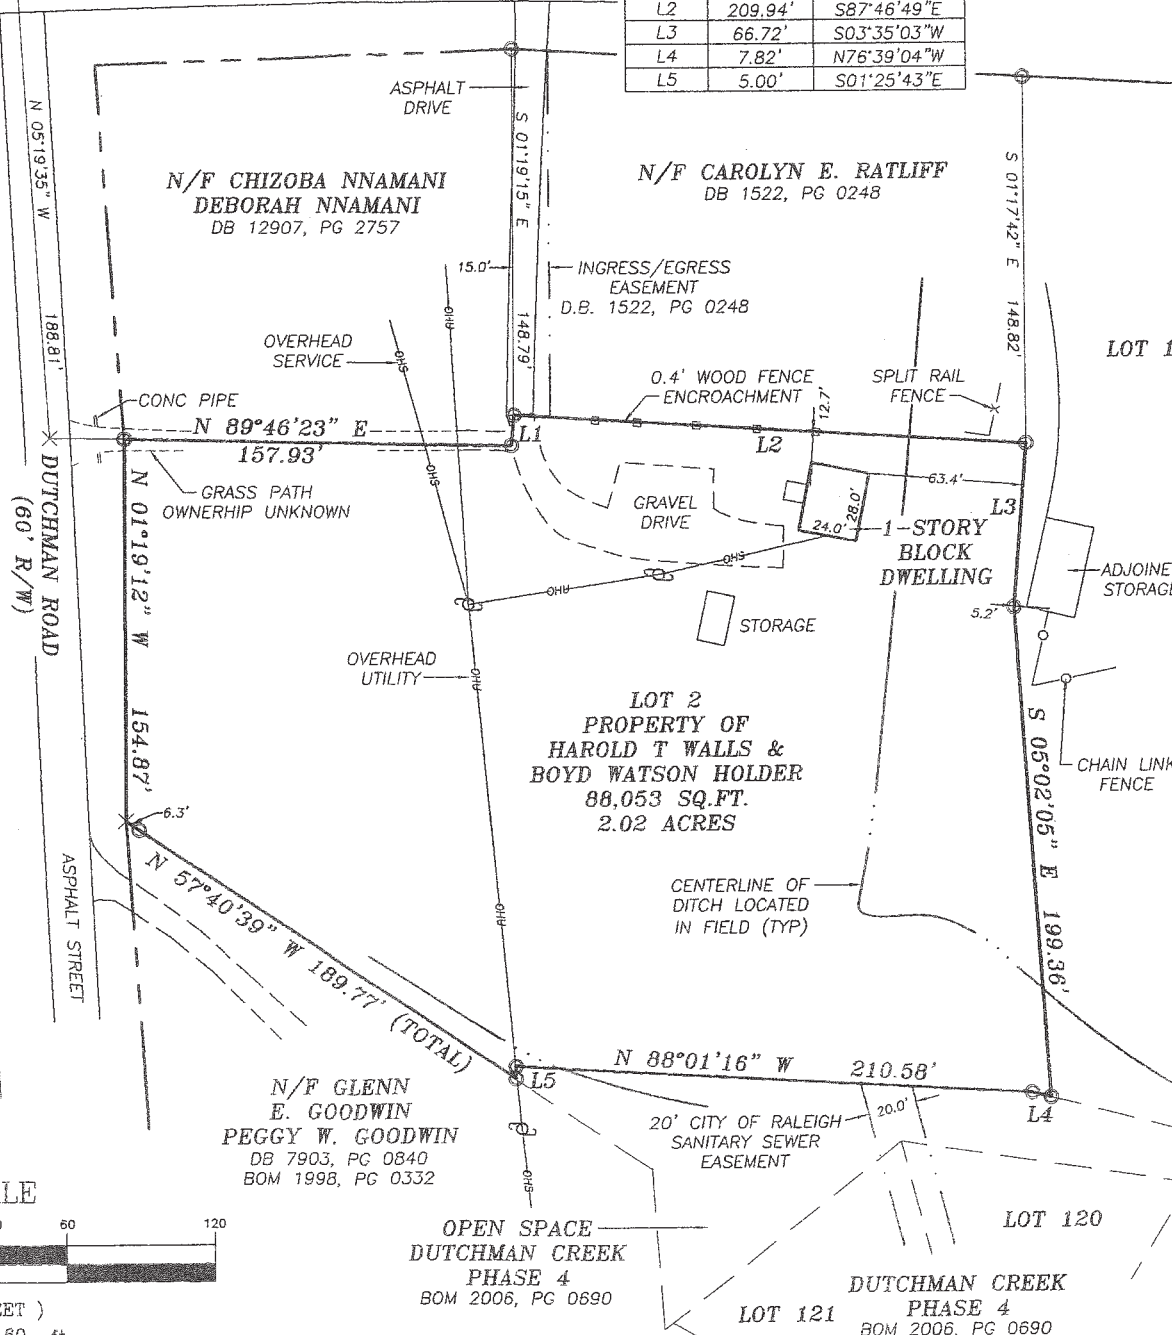

TURNING POINT
SURVEYING PLLC

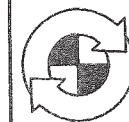

4113 JOHN S. RABOTEAU WYND
RALEIGH, NORTH CAROLINA 27612
FAX (800)948-0213 PH (919)781-0234
License No: P-0121

PROPERTY OF
PHANHOA
TRAN

LOT 2
HAROLD T WALLS & BOYD WATSON HOLDER
3412 ROCK QUARRY ROAD
NORTH CAROLINA
RALEIGH

DATE: 06-03-2016

JOB NO. B-2484

SCALE: 1" = 60'

C.N. = 23888

B.O.M. 2011

PAGE 496

WAKE CO. REG.

DWG. NO.
B-2484