

Environmental Services - Water Quality
Onsite Wastewater Scan Data Entry Form

PERMIT #: D050176

PIN #: 2717006093

OP DATE: 0512112015

SYSTEM USE:

- ☒ House
☐ Mobile Home
☐ Business
☐ Other

SEWAGE TYPE:

- ☒ Domestic
☐ Industrial

PUMP/SIPHON?:

- ☒ Yes
☐ No

PRESSURE MANIFOLD:

- ☐ Yes
☒ No

SYSTEM TYPE:

- ☐ I
☐ II
☒ III
☐ IV
☐ V
☐ VI
☐ Other

SUB TYPE:

- ☐ A
☒ B
☐ C
☐ D
☐ E
☐ F
☐ G

NBR BEDROOMS:

- ☐ 1
☐ 2
☐ 3
☒ 4
☐ 5
☐ 6
☐ Other

MAINT. SCHEDULE:

- ☐ Yes
☒ No

CERT. OPERATOR

- ☐ Yes
☒ No

GT	ST	PT	SIZE
☐	☐		750
☐	☐	☐	900
☐	☐	☐	1,000
☐	☒	☒	1,200
☐	☐	☐	1,500
☐	☐	☐	1,800
☐	☐	☐	2,100
☐	☐	☐	2,500
☐	☐	☐	3,000
☐	☐	☐	4,000
☐	☐	☐	5,000
☐	☐	☐	8,000
☐	☐	☐	10,000
☐	☐	☐	Other
☒		☐	None/NA GT or PT

DRAINFIELD SIZE(SQ. FT.)

01200

DRAIN TYPE:

- ☒ Stone
☐ EZ Flow
☐ Infiltrator
☐ Biodiffuser
☐ Cultec
☐ Drip
☐ Hancor
☐ Large Dia. Pipe
☐ Multi-Pipe
☐ Other

MAX DEPTH (IN.):

- ☐ 12 in. or less
☐ 18 in. or less
☐ 24 in. or less
☐ 26 in. or less
☐ 28 in. or less
☒ 30 in. or less
☐ 32 in. or less
☐ 36 in. or less
☐ Other

STONE DEPTH (IN.):

- ☐ 8 in. or less
☒ 12 in. or less
☐ 18 in. or less
☐ 24 in. or less
☐ Other

TRENCHES:

- ☒ Individual
☐ Bed

TRENCH WIDTH (IN.):

- ☐ 12 in. or less
☐ 18 in.
☐ 24 in.
☒ 36 in.
☐ 6 ft. or less
☐ 9 ft. or less
☐ Other

WAKE COUNTY DEPARTMENT OF ENVIRONMENTAL SERVICES WELL AND SEWAGE SITE LOCATION PERMIT

NO PERMIT(S) FOR CONSTRUCTION, LOCATION OR RELOCATION ACTIVITY SHALL BE ISSUED
UNTIL AN AUTHORIZATION FOR WASTEWATER SYSTEM CONSTRUCTION HAS BEEN ISSUED

PERMIT VOID IF NOT IN COMPLIANCE WITH ZONING REGULATIONS AND/ OR IF SITE IS ALTERED OR INTENDED USE CHANGED

PERMIT#: **D050176** STATUS: **A** APP. DATE: **11/07/2013** BLDG. PERMIT#: **0141332**
PIN: **2717 00 6093 000** TAX MAP: **0** RECORDED: **Y** ORIG. PERMIT#: _____
TOWNSHIP: **09 LITTLE RIVER** JURISDICTION: **WC** ZONING: **R30** SW DEVICE: **N S#:** _____
APPLICANT: **ALEX GIANNAKOPOULOS** (919) 217-6152
1245 DAMASCUS DR WENDELL, NC 27591
USE: HD USE: **101A CONVENTIONAL ONE-FAMILY HOUSE** EXIST USE: _____
LTAR: **0.30 0.35** BEDROOMS: **4** BASEMENT: **Y** #EMPLOYEES: **0**
SITE: ADDRESS: **11545 JEN JEN WAY**
SUBDIVISION: **JOEY MCLEOD** LOT: **11** ACRES: **3.00** EASEMENT: **N** LOC: **SYS:** _____
DIRECTION: **264 BYPASS L GANNON R PEARCES R PROCTOR L SHEPHARD SCHOOLR BLACK STALLION**

Well System: WATER: INDIVIDUAL - TYPE: NEW

WELL LOG INFORMATION: DEPTH: **243** CASING DEPTH: **105** YIELD: **75.0** STATIC LEVEL: **25**
WELL CONTRACTOR: **NW POOLE** REG.# _____ PUMP CONTRACTOR: **NW POOLE** REG.# _____
Construction Compliance GROUT APPROVED ☒ DATE **4-2-14** EHS **GWS**
WELLHEAD APPROVED ☒ DATE **5-6-15** EHS **GWS**
SYSTEM FINALIZED ☒ DATE **5-11-15** EHS **GWS**

COMMENTS: WELL AREA IS 116' FROM THE FRONT OF THE HOUSE, 40' FROM THE LEFT P/L, 40' FROM THE RT P/L, 20' FROM THE FRONT P/L AND AT LEAST 100' FROM ALL PARTS OF THE SEPTIC SYSTEM. CALL WITH QUESTIONS.

Operation Permit

DESIGN FLOW: **28.44** gal./min. ACTUAL FLOW: **28.63** DOSE VOLUME: **214** gal. INNOVATIVE LETTER: _____

INSTALLED BY: **David Truekive**
PROPRIETARY SYSTEM: _____

INSTALLATION APPROVED BY: **Coluene Hallaway** RENS
TYPE SYSTEM: **III B**

COMMENTS: _____

OPERATIONS PERMIT ISSUED? _____ OP DATE: **5/21/15** BY: **AMH**

Systems defined as either a Type IIIb, IIIg with a pump, IV, V or VI, in accordance with the North Carolina Administrative Code 15A NCAC 18A .1961, Table V as adopted by reference in the "Regulations Governing Wastewater Treatment and Dispersal Systems in Wake County", require Wake County Environmental Services to conduct periodic inspections on this type system, pursuant to 15A NCAC 18A .1961 (j). Fees for these inspections will be charged as per the approved Fee Schedule. In addition, all systems are to be operated and maintained as specified in 15A NCAC 18A .1961. This permit is based in part on information provided by the homeowner or his/her representative in the application submitted for this permit. The Environmental Health Specialist is not responsible for false or misleading information contained in the application. The Environmental Health Specialist is also not responsible for concealed conditions on the property or for statements in this report that may have resulted from false or misleading statements provided to him in the application. Neither Wake County nor the Environmental Health Specialist warrants that the septic tank system will continue to function satisfactorily in the future or that the water supply will remain potable.

As Built Information:

Date: **4/1/15** Benchmark: **Tank** Rod reading: **11'8"** Distance to Structure: **30ft.**
ST: **1200** gals ID#: **DB 398** D.O.M.: **1-23-15** Elev.: **100.0'** Distance to Well: **50ft.**
PT: **1200** gals ID#: **DB 463** D.O.M.: **12-22-14** Elev.: **120.0'** Distance to P/L: **410ft.**
GT: _____ gals ID#: _____ D.O.M.: _____ Elev.: _____ Pretreatment: **N/A**
D-box/FD/PM elev.: **3'7 1/4"** Supply Line: **100** ft. Pump/Ctrl Pane: **Zoeller N152** Filter: **Polylok Red**
Line 1: **65 1/4"** Date: **4/1/15** Line 6: _____ Date: _____
Line 2: **73 1/4"** Date: _____ Line 7: _____ Date: _____
Line 3: **710 1/4"** Date: _____ Line 8: _____ Date: _____
Line 4: **816 3/4"** Date: _____ Line 9: _____ Date: _____
Line 5: _____ Date: _____ Line 10: _____ Date: _____
ETM1: **0.24** CC1: **99916** ETM2: _____ CC2: _____ OR: _____ AC: _____ WM: _____
Notes: _____

WAKE COUNTY DEPARTMENT OF ENVIRONMENTAL SERVICES WELL AND SEWAGE SITE LOCATION PERMIT

NO PERMIT(S) FOR CONSTRUCTION, LOCATION OR RELOCATION ACTIVITY SHALL BE ISSUED
UNTIL AN AUTHORIZATION FOR WASTEWATER SYSTEM CONSTRUCTION HAS BEEN ISSUED

PERMIT VOID IF NOT IN COMPLIANCE WITH ZONING REGULATIONS AND/ OR IF SITE IS ALTERED OR INTENDED USE CHANGED

PERMIT#: **D050176** STATUS: **A** APP. DATE: **11/07/2013** BLDG. PERMIT#: **0141332**
PIN: **2717 00 6093 000** TAX MAP: **0** RECORDED: **Y** ORIG. PERMIT#:
TOWNSHIP: **09 LITTLE RIVER** JURISDICTION: **WC** ZONING: **R30** SW DEVICE: **N S#:**
APPLICANT: **ALEX GIANNAKOPOULOS** (919) 217 - 6152
1245 DAMASCUS DR WENDELL, NC 27591
HD USE: **101A CONVENTIONAL ONE-FAMILY HOUSE** EXIST USE: DESIGN FEE REQ?: **PAID?:**
LTAR: **0.30 0.35** BEDROOMS: **4** BASEMENT: **Y** #EMPLOYEES: **0** FOUNDATION DRAIN: **Y**
SITE: **ADDRESS: 11545 JEN JEN WAY**
SUBDIVISION: **JOEY MCLEOD** LOT: **11** ACRES: **3.00** EASEMENT: **N** LOC: **SYS:**
DIRECTION: **264 BYPASS L GANNON R PEARCES R PROCTOR L SHEPHARD SCHOOLR BLACK STALLION**

IMPROVEMENT PERMIT

As per GS 130A-335 (f), Improvement Permit is based on a Site Plan and is void Sixty (60) months from date of issuance: ☐

As per GS 130A-335 (f), Improvement Permit is based on a Plat and is valid without expiration: ☐

Permit is subject to revocation if the site plan or plat, whichever is applicable, or the intended use changes.

TANK SIZE: **1200** gal. PUMP Tank: **1200** gal. GREASE TRAP: gal. SQ FT: **1200** **ACCEPTED STATUS** MAX DEPTH LINE: **30** in.
WASTEWATER: **INDIVIDUAL** SEWAGE: **DOMESTIC** TYPE SYSTEM: **III B** PUMP: **Y** P/M: **N** LP: **TD:**
DAILY FLOW: **480** gal/day WATER: **INDIVIDUAL** PRETREATMENT: **NA** FILL: **DAF:** **DEEP:** **REDUCE35%:**

COMMENTS:

IP ISSUED? **Y** DATE: **01/09/2014** BY: **(CHH)** *Christie H. Hays R.G.H.P.* PHONE#: **(919)-868-2564**

AUTHORIZATION FOR WASTEWATER/WATER SYSTEM CONSTRUCTION

VOID SIXTY (60) MONTHS FROM DATE OF ISSUANCE

AUTHORIZATION CONDITIONS:


Contractors shall install system on contours, see attached site plan for wastewater system design and well location. No underground utilities, water lines or sprinkler systems may be located in the original system or repair areas. A septic tank filter with a riser for access is required. The wastewater system shall not be covered or placed into use until inspected by the Wake County Department of Environmental Services and an Operation Permit issued. An Accepted Status System may be used in place of conventional system, if it can be placed in the permitted/authorized trench footprint (except reduction in line length and/or number as allowed for in approval) and the installation is in accordance with the accepted system approval, without unauthorized product alteration. If permit required use of an Accepted Status System, substitution with another accepted status system may be made, as long as no changes are necessary in the location of each nitrification line (including any increase in line length), trench depth or effluent distribution method. If changes are necessary, prior approval by this office is required before system installation.

OTHER CONDITIONS: INSTALL LINES ON CONTOUR. MAINTAIN ALL SETBACKS. 1200GAL SEPTIC TANK. 1200GAL PUMP TANK. 4(100'X3') ACCEPTED STATUS. 30" TRENCH DEPTH. PUMP TO MANITEE. CALL WITH QUESTIONS, CHANGES OR CONCERNS.

TANK SIZE: **1200** gal. PUMP TANK: **1200** gal. GREASE TRAP: gal. SQ FT: **1200** **ACCEPTED STATUS** MAX DEPTH LINE: **30** in.
MAINT: **N** OPER: **N** L/O: **P** TRENCH#: **4** LENGTH: **100** ft. WIDTH: **36** in. DESIGNER: **CCSC**
SUBFIELDS: **1** DESIGN HEAD PRESSURE: **2** DESIGN FLOW: **28.44** gal/min DOSE VOLUME: **214** gal. PRETREATMENT: **NA**

CA ISSUED? **Y** DATE: **03/24/2015** BY: **(CHH)** *Christie H. Hays R.G.H.P.* PHONE#: **(919)-868-2564**



AS BUILT

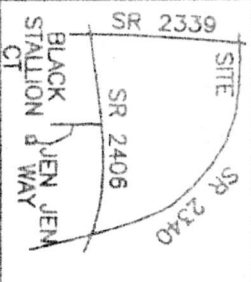


NOTES
AREA PER B.M. 2005 PG. 433
THIS LOT IS NOT LOCATED IN A FEMA MAPPED
FLOOD HAZARD AREA. FEMA MAP # 3720271700K;
ZONE X; EFF. DATE 5/2/2006.
SUBJECT TO ABOVE AND OR UNDERGROUND
UTILITIES AND OR EASEMENTS.

VICINITY MAP (no scale)

LEGEND
B.M. - BOOK OF MAPS
D.B. DEED BOOK
R/W - RIGHT OF WAY
S.F. - SQUARE FEET

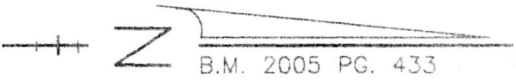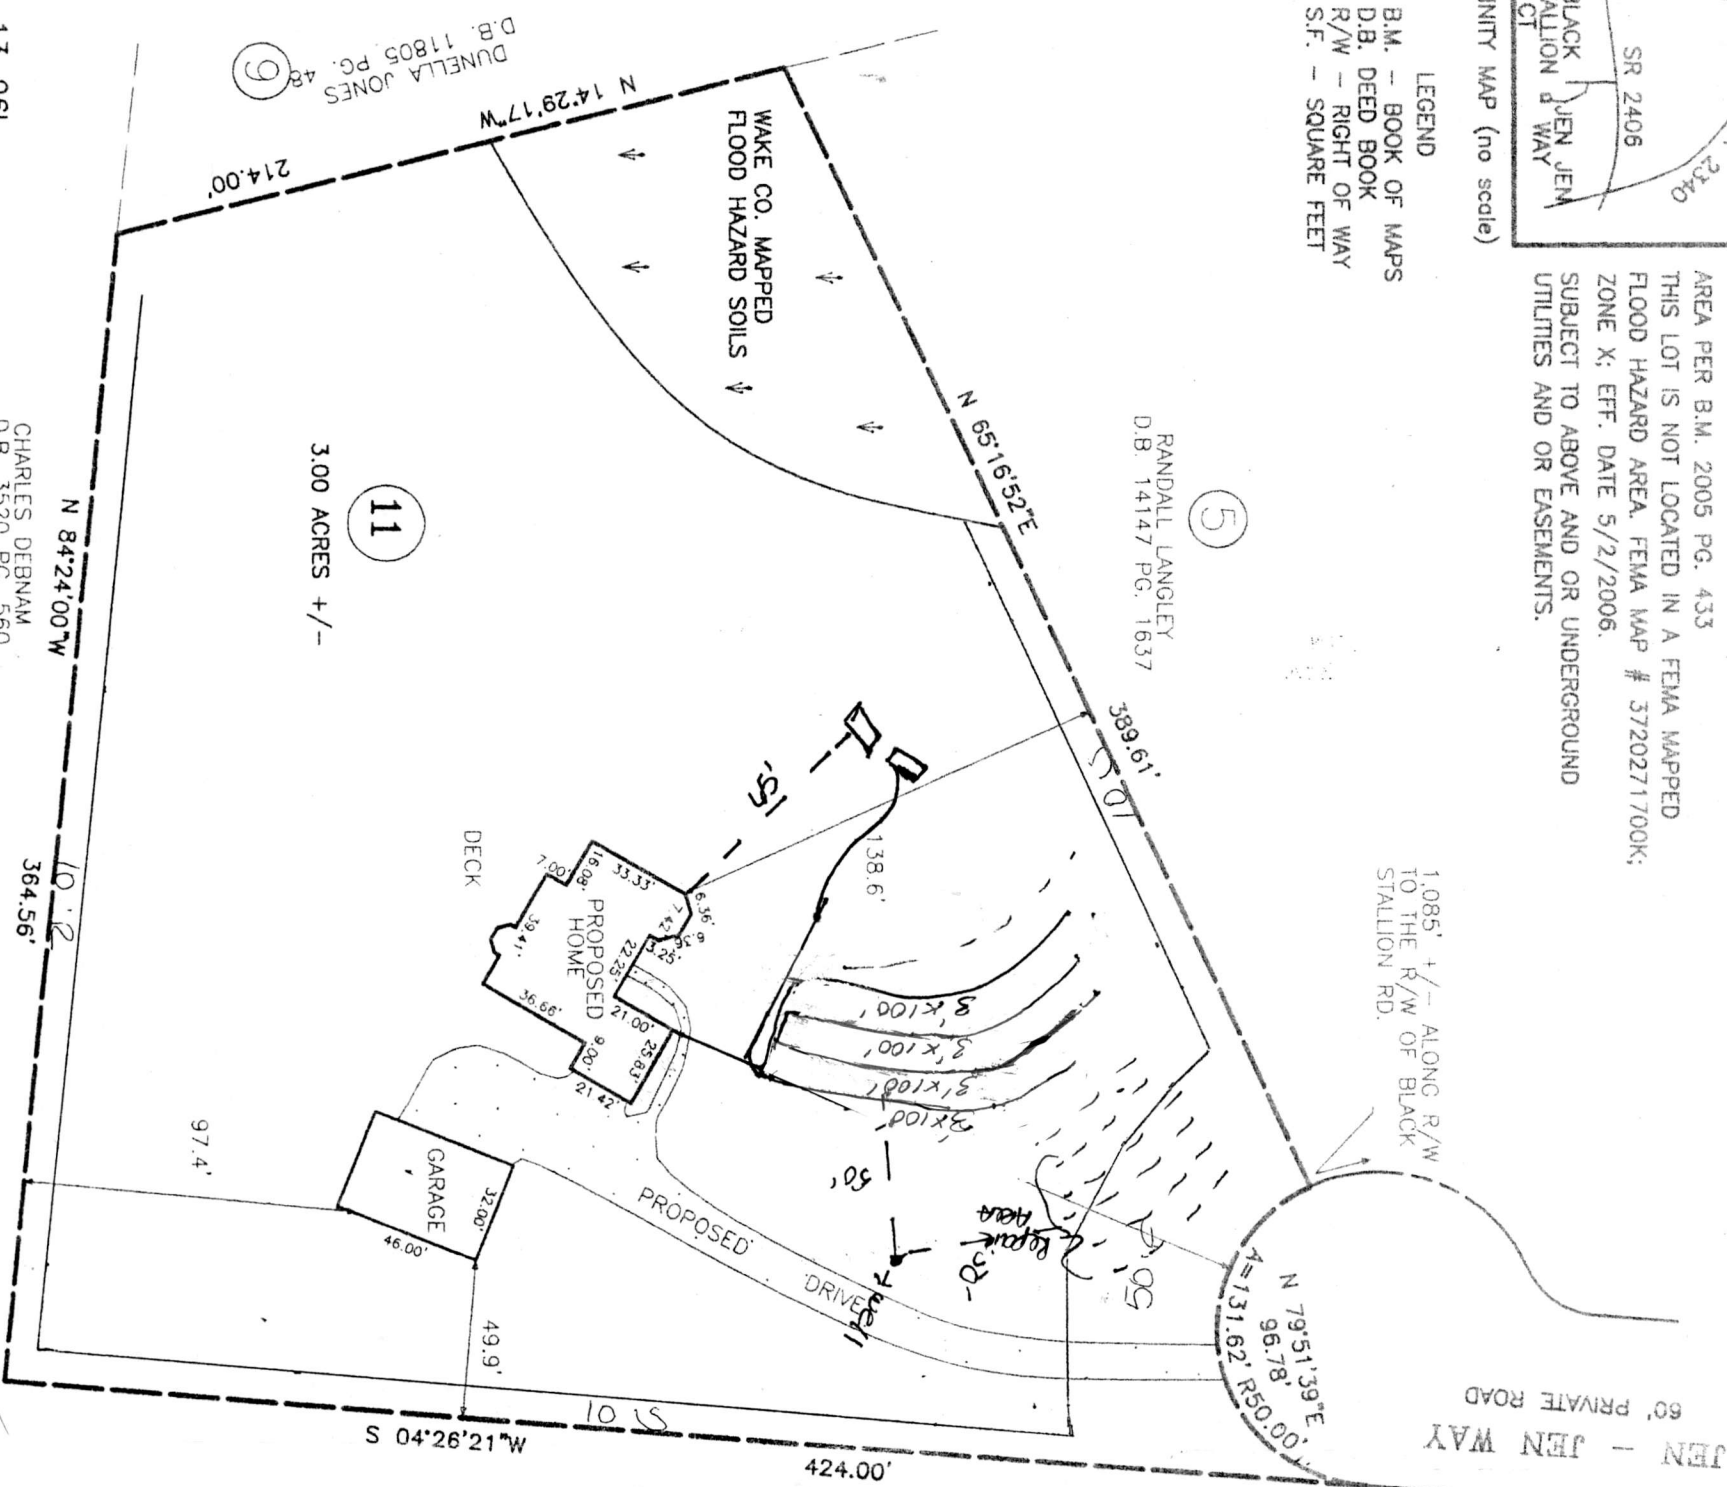

Zoning	R30	By	DUB
Approve	-	Date	2-11-14
Revise	-	Use	436D
Reject	-	MBL	101A
Front	50	Rear	10
Side	10	Corner	
Comments:			

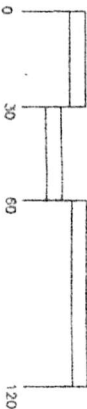

PROPOSED PLAN FOR
ALEX & SUSAN GIANNAKOPOULOS
11545 JEN JEN WAY
LOT 11 JOEY McLEOD SUBD.
BOOK OF MAPS 2005 PAGE 433
PIN # 2717006093.000
LITTLE RIVER TOWNSHIP
WAKE COUNTY - NORTH CAROLINA
SCALE: 1" = 60' - OCTOBER 16, 2013

BENTON DEWAR & ASSOCIATES
PROFESSIONAL LAND SURVEYOR
5920 HONEYCUTT ROAD
HOLLY SPRINGS, NC 27540
(919)-552-9813

DANNY RAY
D.B. 6978 PG. 926
PIN#
2717006093
Permit# 0141334

IMPERVIOUS AREA CALCULATION

PROPOSED HOME - 2,380 S.F.
DRIVE/WALK - 5,046 S.F.
GARAGE - 1,280 S.F.
TOTAL PROPOSED - 8,706 S.F.
AREA ALLOWED - 15,682 S.F.
AREA UNDER ALLOWABLE - 6,976 S.F.

There shall be no filling or the erection of permanent structures in the areas of Wake County Flood Hazard Soils or Federal Emergency Management Agency (FEMA) 100 year Flood Zones until a flood study is approved by Wake County and/or FEMA [14-14-1, 2(A-H)]

Before acquiring a building permit for the lots marked by an * (astrix) the builder may need to obtain a Flood Hazard Area Use Permit from Wake County Environmental Services. The builder's engineer, architect and/or surveyor (as appropriate) must certify on any permit that all flood hazard requirements are met. [14-14-1, 2(A-H)]



I certify that this is a true and correct copy of the original survey as shown to me by the owner or his agent. I understand that the survey is subject to the provisions of the North Carolina Surveying Act, Chapter 170, of the North Carolina General Statutes, and I agree to be bound by the provisions of said Act.

Signature of Owner or Authorized Agent


13-96L
11GIANNA\13\600

CHARLES DEBNAM
D.B. 3520 PG. 560

1. BENTON W. DEWAR CERTIFY THAT THIS PLAN WAS DRAWN UNDER MY SUPERVISION FROM AN ACTUAL SURVEY MADE UNDER MY SUPERVISION, THAT THE RATIO OF PRECISION IS 1:1, N/A, THAT THE BOUNDARIES NOT SURVEYED ARE SHOWN AS BROKEN LINES PLOTTED FROM INFORMATION FOUND IN BOOK MAP 2005 PAGE 433. THAT THIS PLAN DOES NOT MEET SIZE REQUIREMENTS FOR RECORDING IN THE REGISTER OF DEEDS PER G.S. 47-20 AS AMENDED. LICENSE NUMBER AND SEAL THIS DAY OF FEB 2014

PROFESSIONAL LAND SURVEYOR L-30040

THIS PLAN IS OF A BOUNDARY SURVEY OF AN EXISTING PARCEL OF LAND THAT IS REGULATED BY A COUNTY OR MUNICIPALITY ORDINANCE THAT REGULATES PARCELS OF LAND.

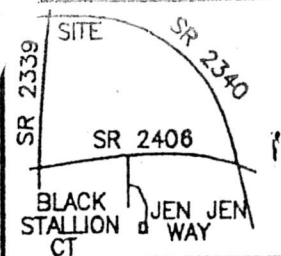

VICINITY MAP (no scale)

LEGEND
 B.M. - BOOK OF MAPS
 D.B. DEED BOOK
 R/W - RIGHT OF WAY
 S.F. - SQUARE FEET

NOTES

AREA PER B.M. 2005 PG. 433
 THIS LOT IS NOT LOCATED IN A FEMA MAPPED
 FLOOD HAZARD AREA, FEMA MAP # 3720271700K;
 ZONE X; EFF. DATE 5/2/2006.
 SUBJECT TO ABOVE AND OR UNDERGROUND
 UTILITIES AND OR EASEMENTS.


CALL BY ENDING OUT
 919. 422. 4194

1,085' +/- ALONG R/W
 TO THE R/W OF BLACK
 STALLION RD.

JEN JEN WAY
 60' PRIVATE ROAD

B.M. 2005 PG. 433

PROPOSED PLAN FOR
 ALEX & SUSAN GIANNAKOPOULOS
 11545 JEN JEN WAY
 LOT 11 JOEY McLEOD SUBD.
 BOOK OF MAPS 2005 PAGE 433
 PIN # 2717006093.000
 LITTLE RIVER TOWNSHIP
 WAKE COUNTY - NORTH CAROLINA
 SCALE : 1" = 60' - OCTOBER 16, 2013

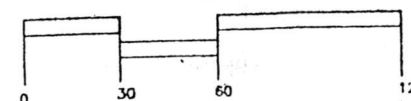

BENTON DEWAR & ASSOCIATES
 PROFESSIONAL LAND SURVEYOR
 5920 HONEYCUTT ROAD
 HOLLY SPRINGS, NC 27540
 (919)-552-9813

PIN: 2717006093

I certify that the location of planned or existing structure(s)
 are accurately shown. I understand failure to locate
 structures in accordance with this plot plan may
 require the relocation of structure(s) regardless
 degree of completion. I hereby grant permission to
 Municipal/County Engineers the right of entry
 to make evaluations or inspections upon this property.

Signature of Owner or Authorized Agent



I, BENTON W. DEWAR CERTIFY THAT THIS PLAT WAS DRAWN UNDER
 MY SUPERVISION FROM AN ACTUAL SURVEY MADE UNDER MY
 SUPERVISION; THAT THE RATIO OF PRECISION IS 1:1; THAT
 THAT THE BOUNDARIES NOT SURVEYED ARE SHOWN AS BROKEN LINES
 PLOTTED FROM INFORMATION FOUND IN BOOK MAP 2005
 PAGE 433; THAT THIS PLAT DOES NOT MEET SIZE REQUIREMENTS
 FOR RECORDING IN THE REGISTER OF DEEDS, PER G.S. 47-30 (S. AMENDED);
 LICENSE NUMBER AND SEAL THIS 5TH DAY OF NOV. 2013

PROFESSIONAL LAND SURVEYOR 1-2240

THIS PLAT IS OF A BOUNDARY SURVEY OF AN EXISTING
 PARCEL OF LAND THAT IS REGISTARIED BY A COUNTY OR
 MUNICIPALITY IN ACCORDANCE WITH RECORDS BOOKS OF 1-1-1.

Zoning B30 By SJL
 Approve ☒ Date 3-9-15
 Revise ☒ Use IOIA
 Reject ☐ MBL
 Front 30 Rear 30
 Side 10 Corner
 DANNY RAY
 City Engineer PG. 926

0141332
 D50174

IMPERVIOUS AREA CALCULATION

PROPOSED HOME - 2,380 S.F.
 DRIVE/WALK - 5,046 S.F.
 GARAGE - 1,280 S.F.
 TOTAL PROPOSED - 8,706 S.F. = 6.6%
 AREA ALLOWED - 15,682 S.F. - FUSIA
 AREA UNDER ALLOWABLE - 6,976 S.F.

There shall be no filling or the erection of permanent
 structures in the areas of Wake County Flood Hazard
 Maps or Federal Emergency Management Agency (FEMA)
 100 year Flood Zones until a flood study is approved
 by Wake County and/or FEMA [14-14-1.2(A-H)]


Before acquiring a building permit for the lots
 marked by an * (astrick) the builder may need
 to obtain a Flood Hazard Area Use Permit from Wake
 County Environmental Services. The builders engineer,
 architect and/or surveyor (as appropriate) must certify
 on any permit that all flood hazard requirements
 are met. [14-14-1.2(A-H)]

CA PART A
 SEE PART B
 (5)
 RANDALL LANGLEY
 D.B. 14147 PG. 1637

WAKE CO. MAPPED
 FLOOD HAZARD SOILS


DUNELLA JONES
 D.B. 11805 PG. 48

11
 3.00 ACRES +/-

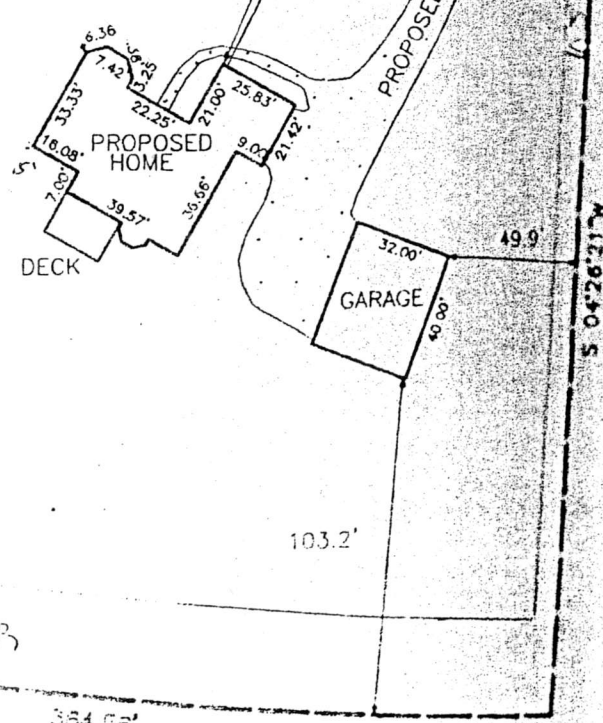

CHARLES DEBNAM
 D.B. 3520 PG. 560


13-96L
 11545 JEN JEN WAY

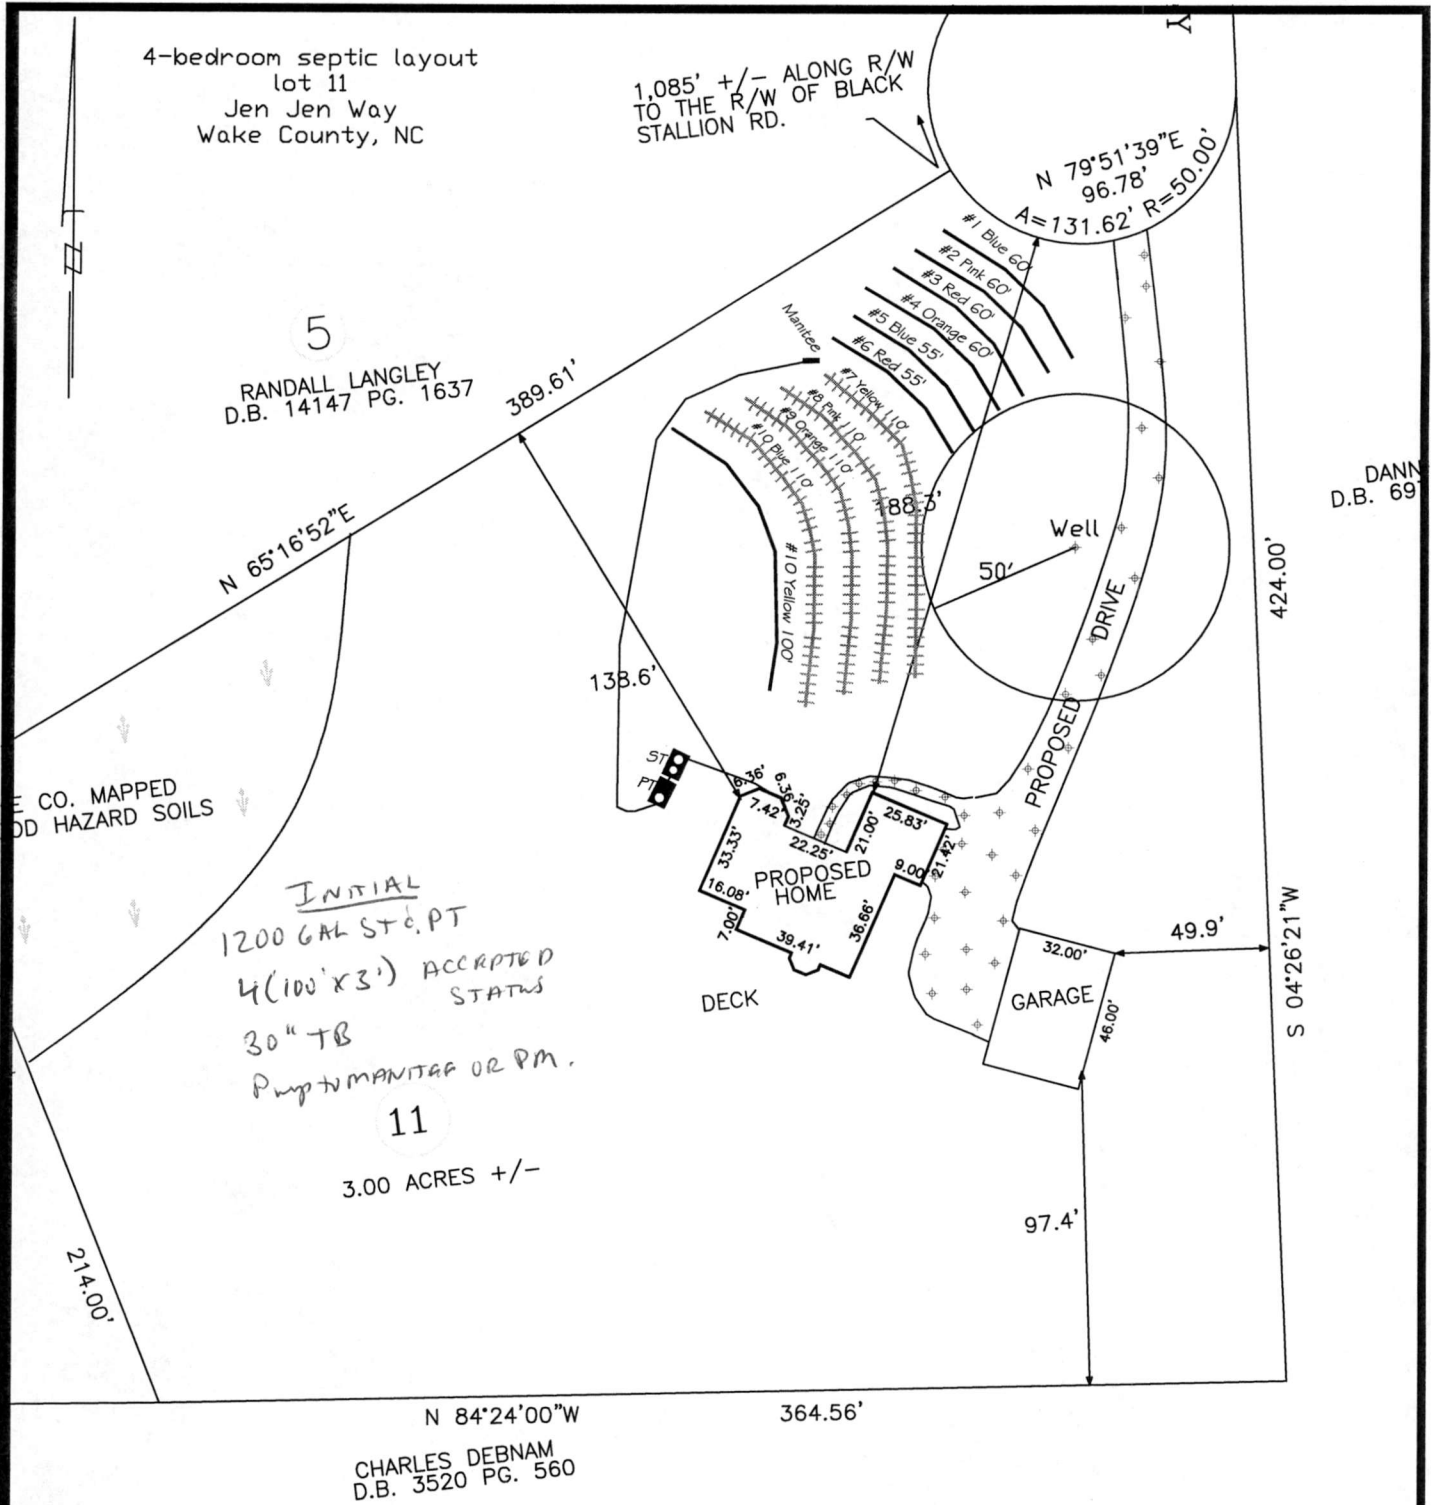

System: Pressure Manitee
Lines: 7-10, (440')
Accepted Status System
0.3 Soil LTAR
24' Trench Bottom

Repair: Pressure Manifold
Lines: 1-6, 11 (450')
Accepted Status System
24' Trench Bottom
0.35 Soil LTAR

GRAPHIC SCALE
1" = 60'

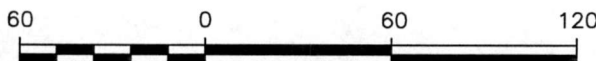

Central Carolina
Soil Consulting
919-569-6704
Project # 1562

Sheet1

**11545 Jen-Jen Way Lot
Tap Chart**

Bench Mark	0.00	is = 100.00		Location of BM		Elevation Head			14.40
Pump tank elev.	15	85.00	Pump elev.	80.00	Manifold elev.			94.40	
line	color	rod read	Elevation	length	hole size	flow/tap	gal/day	trench area	LINE LTAR
7	Yellow	6.60	93.40	110	1/2in SCH 40	7.11	120.00	330	0.3636
8	Pink	7.60	92.40	110	1/2in SCH 40	7.11	120.00	330	0.3636
9	Orange	8.30	91.70	110	1/2in SCH 40	7.11	120.00	330	0.3636
10	Blue	9.20	90.80	110	1/2in SCH 40	7.11	120.00	330	0.3636

	total	feet =	440	gal/min =	28.44	LTAR=	0.3000
						LTAR + %5	0.3150
% of Dose Vol.	75		Des. Flow	480		(ltar W/ INOV)	0.4000
Dose Volume	214.50		Pump Run=	16.88		(ltar W/ INOV + 5%)	0.4200
Dose Pump Time	7.54		Tank Gal/IN	21			
Drawdown in Inches	10.21						

11545 Jen-Jen Way Lot Repair Tap Chart

Bench Mark	0.00	is = 100.00 Location of BM						Elevation Head	19.80
Pump tank elev.	15	85.00	Pump elev.	80.00			Manifold elev.		99.80
line	color	rod read	Elevation	length	hole size	flow/tap	gal/day	trench area	LINE LTAR
1	Blue	1.20	98.80	60	1/2in SCH 80	5.48	61.20	180	0.3400
2	Pink	2.10	97.90	60	1/2in SCH 80	5.48	61.20	180	0.3400
3	Red	2.80	97.20	60	1/2in SCH 80	5.48	61.20	180	0.3400
4	Orange	4.00	96.00	60	1/2in SCH 80	5.48	61.20	180	0.3400
5	Blue	5.00	95.00	55	1/2in SCH 80	5.48	61.20	165	0.3709
6	Red	5.80	94.20	55	1/2in SCH 80	5.48	61.20	165	0.3709
11	Yellow	10.00	90.00	100	3/4in SCH 80	10.1	112.80	300	0.3760

	total	feet =	450	gal/min =	42.98	LTAR =	0.3500
						LTAR + %5	0.3675
% of Dose Vol.	75		Des. Flow	480		(ltar W/ INOV)	0.4667
Dose Volume	219.38		Pump Run=	11.17		(ltar W/ INOV + 5%)	0.4900
Dose Pump Time	5.10		Tank Gal/IN	21			
Drawdown in Inches	10.45						



Environmental
Services

RE 218 030 7000

Water Quality Division

530 Fayetteville St., P.O. Box 650 • Raleigh, NC 27602

Purpose: This forms is to be completed when making changes to a pending or active Well, Septic, or Building Permit.

DW# 50174 BUILDING PERMIT # 0141332 PIN# 2717 00 6095

Change of Bedrooms from ... 3 to 4
*Site Plan May Be Required

Change Applicant Name to _____
*Attach Owner Authorization

Change of Applicant Address to _____

Change of Applicant Phone Number to _____

Change of Building Footprint _____
* Site Plan Will Be Required

Foundation Drain ☐ Yes ☐ No
* No Site Plan Required

Change # of Employees _____
* Business, Schools, Daycares, etc.

Change of Basement: Add Basement _____ or Remove Basement _____

Comments _____

Project (Site) Address 11545 JEN JEN WAY, ZEBULON N.C. 27597

Applicant Signature [Signature] Date 3-19-15

Wake County Permit Processor SL Date 3-19-15

☐ Sent to Plan Review Staff

Note: Any change made where a Wake County Building Permit is involved requires that this document be forwarded through the Wake County Building Permits Department. All other revision forms can be forwarded to Environmental Services representatives on the 1st floor. Be aware revision fee may be required before processing can begin.