

WAKE COUNTY DEPARTMENT OF ENVIRONMENTAL SERVICES WELL AND SEWAGE SITE LOCATION PERMIT

NO PERMIT(S) FOR CONSTRUCTION, LOCATION OR RELOCATION ACTIVITY SHALL BE ISSUED

UNTIL AN AUTHORIZATION FOR WASTEWATER SYSTEM CONSTRUCTION HAS BEEN ISSUED

PERMIT VOID IF NOT IN COMPLIANCE WITH ZONING REGULATIONS AND/ OR IF SITE IS ALTERED OR INTENDED USE CHANGED

PERMIT#: D020750 STATUS: A APP. DATE: 02/12/2001 BLDG. PERMIT#: 0012610
PIN: 1617.01 18 9368 000 TAX MAP: 0827 0000 RECORDED: Y ORIG. PERMIT#:
TOWNSHIP: 15 PANTHER BRANCH JURISDICTION: WC ZONING: R30
APPLICANT: SUPERIOR HOMES
112 S. LAKEVIEW DR
SMITHFIELD, NC 27577
(919) 938 - 0980
USE: HD USE: 101 ONE-FAMILY HOUSE
EXIST USE:
DISPOSAL: N BEDROOMS: 3 BASEMENT: N #EMPLOYEES: 0
SITE: ADDRESS: 1229 JOGGING CT
SUBDIVISION: JACOB'S RIDGE LOT: 34 ACRES: 1.20
DIRECTION: 50S, TR SR 1010, TL SR 2731, SUB ON RT

IMPROVEMENT PERMIT

TANK SIZE: 1000 gal. PUMP Tank: 1000 gal. SQ FT: 1200 STONE DEPTH: 12 in. MAX DEPTH LINE: 30 in.
WASTEWATER: INDIVIDUAL SEWAGE: DOMESTIC TYPE SYSTEM: III B PUMP: Y P/M: N
DAILY FLOW: 360 gal/day WATER: INDIVIDUAL

COMMENTS:

IP ISSUED? Y DATE: 03/14/2001 BY: (SCR)  PHONE#:

AUTHORIZATION FOR WASTEWATER/WATER SYSTEM CONSTRUCTION


VOID SIXTY (60) MONTHS FROM DATE OF ISSUANCE

AUTHORIZATION CONDITIONS:

Contractors shall install system on contours, see attached site plan for wastewater system design and well location. No underground utilities, water lines or sprinkler systems may be located in the original system or repair areas. A septic tank filter with a riser for access is required. The wastewater system shall not be covered or placed into use until inspected by the Wake County Department of Environmental Services and an Operation Permit issued. **OTHER CONDITIONS:**

INITIAL SYSTEM 4 100 FT CONVENTIONAL LINES, FLAGGED OUT IN FIELD. IF HOUSE ELEVATION CAN BE KEPT HIGH ENOUGH TO MAINTAIN GRAVITY FLOW A PUMP SYSTEM MAY NOT BE REQUIRED.

TANK SIZE: 1000 gal. PUMP TANK: 1000 gal. SQ FT: 1200 STONE DEPTH: 12 in. MAX DEPTH LINE: 30 in..
MAINT: N OPER: N L/O: Y TRENCH#: 4 LENGTH: 100 ft. WIDTH: 36 in.
SUBFIELDS: _ DESIGN HEAD PRESSURE: _ DESIGN FLOW: _ gal/min DOSE VOLUME: _ gal.

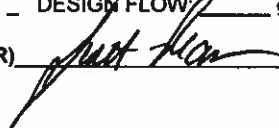CA ISSUED? Y DATE: 06/20/2001 BY: (SCR)  PHONE#: 857-9355

WAKE COUNTY DEPARTMENT OF ENVIRONMENTAL SERVICES WELL AND SEWAGE SITE LOCATION PERMIT
NO PERMIT(S) FOR CONSTRUCTION, LOCATION OR RELOCATION ACTIVITY SHALL BE ISSUED
UNTIL AN AUTHORIZATION FOR WASTEWATER SYSTEM CONSTRUCTION HAS BEEN ISSUED

PERMIT VOID IF NOT IN COMPLIANCE WITH ZONING REGULATIONS AND/ OR IF SITE IS ALTERED OR INTENDED USE CHANGED

PERMIT#: D020750 STATUS: A APP. DATE: 02/12/2001 BLDG. PERMIT#: 0012610
PIN: 1617.01 18 9368 000 TAX MAP: 0827 RECORDED: Y ORIG. PERMIT#:
TOWNSHIP: 15 PANTHER BRANCH JURISDICTION: WC ZONING: R30
APPLICANT: SUPERIOR HOMES
112 S. LAKEVIEW DR
SMITHFIELD, NC 27577
(919) 938 - 0980
USE: HD USE: 101 ONE-FAMILY HOUSE
EXIST USE:
DISPOSAL: N BEDROOMS: 3 BASEMENT: N #EMPLOYEES: 0
SITE: ADDRESS: 1229 JOGGING CT
SUBDIVISION: JACOB'S RIDGE LOT: 34 ACRES: 1.20
DIRECTION: 50S, TR SR 1010, TL SR 2731, SUB ON RT

Well System: WATER: INDIVIDUAL - TYPE: NEW

WELL LOG INFORMATION: DEPTH: 290 CASING DEPTH: 77 YIELD: 5 STATIC LEVEL: 140
WELL CONTRACTOR: NWY 006 REG.# 4 PUMP CONTRACTOR: NWY 119 REG.# 846
Construction Compliance GROUT APPROVED ☒ DATE 6/11/01 EHS [Signature]
107.9 WELLHEAD APPROVED ☒ DATE 6/28/01 EHS [Signature]
SYSTEM FINALIZED ☐ DATE _____ EHS [Signature]

COMMENTS:

DESIGN FLOW: _____ gal./min. ACTUAL FLOW: _____ INNOVATIVE LETTER: _____

INSTALLED BY: Tony Carroll
PROPRIETARY SYSTEM:
COMMENTS:

INSTALLATION APPROVED BY: [Signature]
FILTER NO: _____

OPERATIONS PERMIT ISSUED? ☒

OP DATE: 6/20/01


BY: [Signature]

This permit is based in part on information provided by the homeowner or his/her representative in the application submitted for this permit. The Environmental Health Specialist is not responsible for false or misleading information contained in the application. The Environmental Health Specialist is also not responsible for concealed conditions on the property or for statements in this report that may have resulted from false or misleading statements provided to him in the application. Neither Wake County nor the Environmental Health Specialist warrants that the septic tank system will continue to function satisfactorily in the future or that the water supply will remain potable.

Zoning R30 By CHL
 Approve ✓ Date _____
 Revise _____ Use _____
 Reject _____ MBL _____
 Front 30 Rear 30
 Side 10 Corner 30
 Comments _____

As Bldg H
 S.I.
 MCA-100 MCL-1000
 PT-53 STB-84
 4/26/01 5/4/01

33270

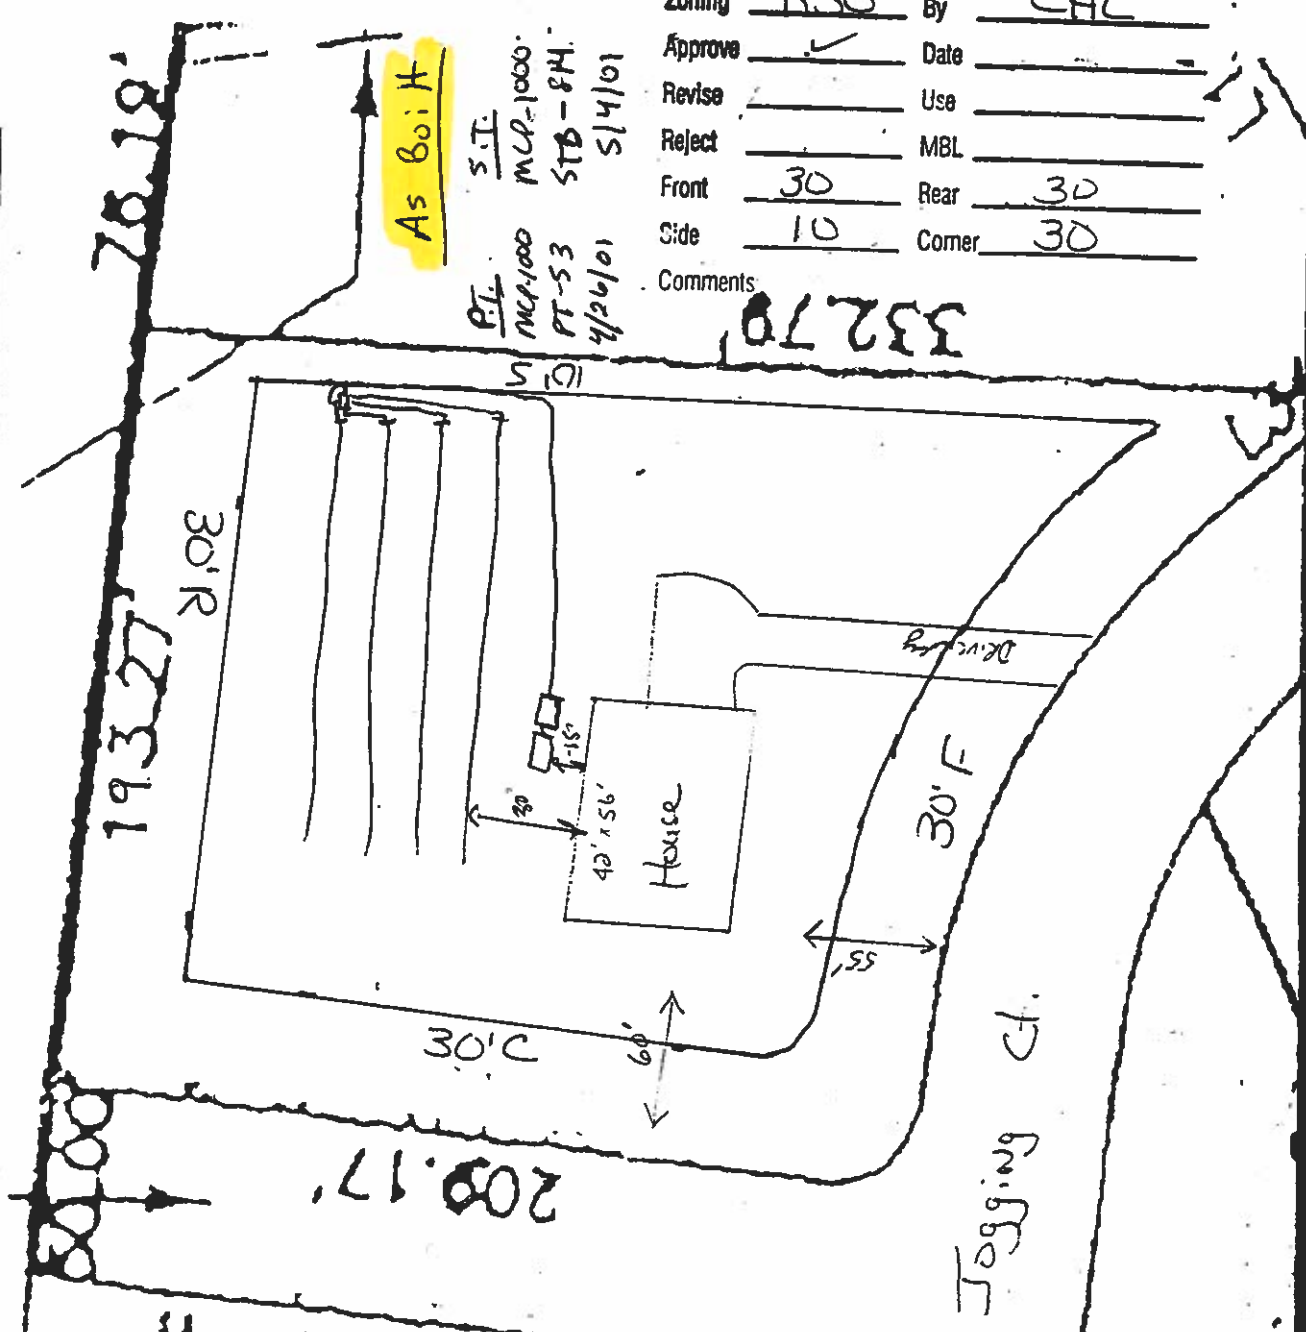

0518'10" W

271.08' 1220

I certify that the location of planned or existing structure(s) are accurately shown. I understand failure to locate structures in accordance with this plot plan may require the relocation of structure(s) regardless degree of completion. I hereby grant permission to Municipal/County Representatives the right of entry to make evaluations or inspections upon this property.

Signature of Owner or Authorized Agent

Lot 34 Jacob's Ridge
 Scale = 1" = 50'
 4.47

78.12'

193.27'

C.A.S. to Plan

3 (4x100) Conventional

1000 gal P.T. + S.T.

30" trenches

In the system flagged in field

Zoning R30 By CHL

Approve ✓ Date


Revise Use

Reject MBL

Front 30 Rear 30

Side 10 Corner 30

Comments 33270

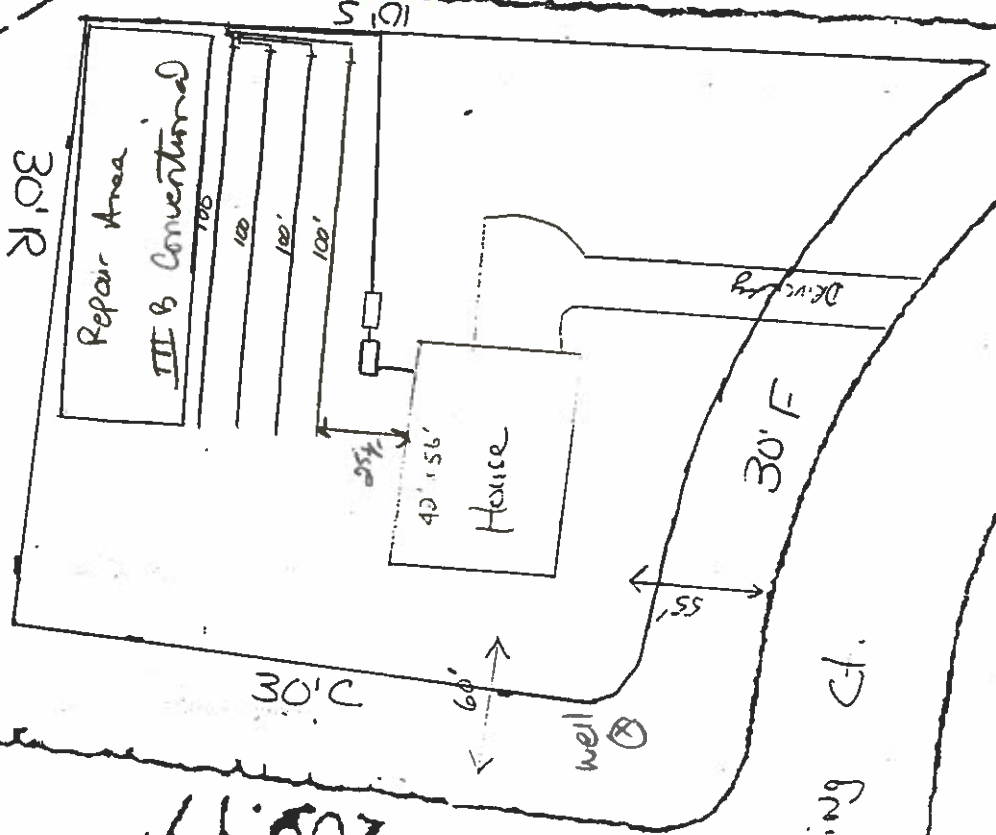

209.17'

0518'19" W

I certify that the location of planned or existing structure(s) are accurately shown. I understand failure to locate structures in accordance with this plot plan may require the relocation of structure(s) regardless degree of completion. I hereby grant permission to Municipal/County Representatives the right of entry to make verifications or inspections upon this property.

[Signature]

Signature of Owner or Authorized Agent

Lot 34 Jacob's Ridge

Scale = 1" = 50'

4.47

271.08'

1220