

Environmental Services - Water Quality
Onsite Wastewater Scan Data Entry Form

PERMIT #: 8036319

PIN #: 2716450940

OP DATE: 2610211986

SYSTEM USE:

- ☒ House
☐ Mobile Home
☐ Business
☐ Other

SEWAGE TYPE:

- ☒ Domestic
☐ Industrial

PUMP/SIPHON?:

- ☐ Yes
☒ No

PRESSURE MANIFOLD:

- ☐ Yes
☒ No

SYSTEM TYPE:

- ☐ I
☒ II
☐ III
☐ IV
☐ V
☐ VI
☐ Other

SUB TYPE:

- ☒ A
☐ B
☐ C
☐ D
☐ E
☐ F
☐ G

NBR BEDROOMS:

- ☐ 1
☐ 2
☒ 3
☐ 4
☐ 5
☐ 6
☐ Other

MAINT. SCHEDULE:

- ☐ Yes
☒ No

CERT. OPERATOR

- ☐ Yes
☒ No

GT	ST	PT	SIZE
☐	☐		750
☐	☐	☐	900
☐	☒	☐	1,000
☐	☐	☐	1,200
☐	☐	☐	1,500
☐	☐	☐	1,800
☐	☐	☐	2,100
☐	☐	☐	2,500
☐	☐	☐	3,000
☐	☐	☐	4,000
☐	☐	☐	5,000
☐	☐	☐	8,000
☐	☐	☐	10,000
☐	☐	☐	Other
☒		☒	None/NA GT or PT

DRAINFIELD SIZE(SQ. FT.)

01200

DRAIN TYPE:

- ☒ Stone
☐ EZ Flow
☐ Infiltrator
☐ Biodiffuser
☐ Cultec
☐ Drip
☐ Hancor
☐ Large Dia. Pipe
☐ Multi-Pipe
☐ Other

MAX DEPTH (IN.):

- ☐ 12 in. or less
☐ 18 in. or less
☐ 24 in. or less
☐ 26 in. or less
☐ 28 in. or less
☐ 30 in. or less
☐ 32 in. or less
☐ 36 in. or less
☒ Other

STONE DEPTH (IN.):

- ☐ 8 in. or less
☒ 12 in. or less
☐ 18 in. or less
☐ 24 in. or less
☐ Other

TRENCHES:

- ☒ Individual
☐ Bed

TRENCH WIDTH (IN.):

- ☐ 12 in. or less
☐ 18 in.
☐ 24 in.
☒ 36 in.
☐ 6 ft. or less
☐ 9 ft. or less
☐ Other

wake

WAKE COUNTY HEALTH DEPARTMENT SEPTIC TANK LAYOUT AND PERMIT

36319

TAX MAP NO. 395 PARCEL NO. 87PERMIT NO. B
OPERATION PERMIT ☐

Little River

CONTRACTOR _____

OWNER Dale MillerDATE 24 Jan 86LOCATION 2716 45 0940S. R. NO. Any 39SUBDIVISION NAME Burn Lake Est LOT NO. A-8

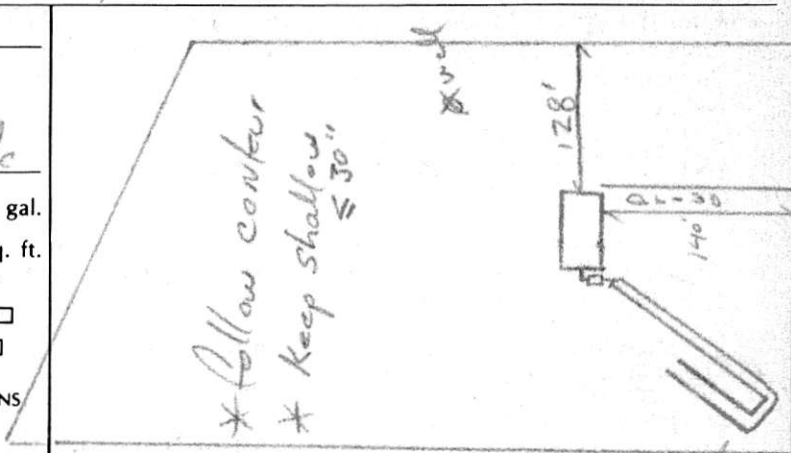
SECTION OR BLOCK NO. _____

REPAIR ☐ ORIGINAL PERMIT NO. _____GARBAGE DISPOSAL UNIT YES ☐ NO ☒HOUSE ☒ MOBILE HOME ☐ BUSINESS ☐NO. BEDROOMS 3 LOT AREA 4.83 AcSIZE OF TANK 1000 gal.NITRIFICATION LINE 1200 2x(3' x 200) sq. ft.DEPTH OF STONE IN LINES: 12" ☒RISER AND BAFFLE REQUIRED ☐ PUMP REQUIRED ☐WATER SUPPLY: INDIVIDUAL ☒ PUBLIC ☐ OTHER ☐

• PERMIT VOID 36 MONTHS FROM DATE OF ISSUANCE.

• PERMIT VOID IF NOT IN COMPLIANCE WITH ZONING REGULATIONS

• PERMIT MAY BE VOIDED IF SITE ALTERATIONS MADE

LAYOUT BY GE Dietrich

26 Feb 86

DATE

Tony Creech

INSTALLED BY

GE Dietrich

APPROVED BY