

Environmental Services - Water Quality
Onsite Wastewater Scan Data Entry Form

PERMIT #: D 0 3 7 2 0 0

PIN #: 0 6 9 5 7 6 6 4 5 4

OP DATE: 0 1 1 0 3 1 2 0 0 7

SYSTEM USE:

- ☒ House
☐ Mobile Home
☐ Business
☐ Other

SEWAGE TYPE:

- ☒ Domestic
☐ Industrial

PUMP/SIPHON?:

- ☒ Yes
☐ No

PRESSURE MANIFOLD:

- ☐ Yes
☒ No

SYSTEM TYPE:

- ☐ I
☐ II
☒ III
☐ IV
☐ V
☐ VI
☐ Other

SUB TYPE:

- ☐ A
☒ B
☐ C
☐ D
☐ E
☐ F
☐ G

NBR BEDROOMS:

- ☐ 1
☐ 2
☒ 3
☐ 4
☐ 5
☐ 6
☐ Other

MAINT. SCHEDULE:

- ☐ Yes
☒ No

CERT. OPERATOR

- ☐ Yes
☒ No

GT	ST	PT	SIZE
☐	☐		750
☐	☐	☐	900
☐	☒	☒	1,000
☐	☐	☐	1,200
☐	☐	☐	1,500
☐	☐	☐	1,800
☐	☐	☐	2,100
☐	☐	☐	2,500
☐	☐	☐	3,000
☐	☐	☐	4,000
☐	☐	☐	5,000
☐	☐	☐	8,000
☐	☐	☐	10,000
☐	☐	☐	Other
☒		☐	None/NA GT or PT

DRAINFIELD SIZE(SQ. FT.)

0 0 9 0 0

DRAIN TYPE:

- ☐ Stone
☒ EZ Flow
☐ Infiltrator
☐ Biodiffuser
☐ Cultec
☐ Drip
☐ Hancor
☐ Large Dia. Pipe
☐ Multi-Pipe
☐ Other

MAX DEPTH (IN.):

- ☐ 12 in. or less
☐ 18 in. or less
☒ 24 in. or less
☐ 26 in. or less
☐ 28 in. or less
☐ 30 in. or less
☐ 32 in. or less
☐ 36 in. or less
☐ Other

STONE DEPTH (IN.):

- ☐ 8 in. or less
☒ 12 in. or less
☐ 18 in. or less
☐ 24 in. or less
☐ Other

TRENCHES:

- ☒ Individual
☐ Bed

TRENCH WIDTH (IN.):

- ☐ 12 in. or less
☐ 18 in.
☐ 24 in.
☒ 36 in.
☐ 6 ft. or less
☐ 9 ft. or less
☐ Other

WAKE COUNTY DEPARTMENT OF ENVIRONMENTAL SERVICES WELL AND SEWAGE SITE LOCATION PERMIT

NO PERMIT(S) FOR CONSTRUCTION, LOCATION OR RELOCATION ACTIVITY SHALL BE ISSUED
UNTIL AN AUTHORIZATION FOR WASTEWATER SYSTEM CONSTRUCTION HAS BEEN ISSUED

PERMIT VOID IF NOT IN COMPLIANCE WITH ZONING REGULATIONS AND/OR IF SITE IS ALTERED OR INTENDED USE CHANGED

PERMIT#: D037200 STATUS: A APP. DATE: 06/01/2006 BLDG. PERMIT#: 0063999
PIN: 0695.02 76 6454 000 TAX MAP: 0881 0054 RECORDED: Y ORIG. PERMIT#:
TOWNSHIP: 15 PANTHER BRANCH JURISDICTION: WC ZONING: R30
APPLICANT: DTF CONSTRUCTION
8113 WHITE STAR DR.
FUQUAY VARINA, NC 27526
(919) 868-5810
USE: HD USE: 101 ONE-FAMILY HOUSE
EXIST USE:
DISPOSAL: BEDROOMS: 3 BASEMENT: N #EMPLOYEES: 0
SITE: ADDRESS: 7308 CHIMARA CT
SUBDIVISION: REBARAH MOOR LOT: 09 ACRES: 0.74
DIRECTION: 401S TO OLD STAGE RD TO CARLIE ADAM AND GO TL
TURNER FISH RD GO R SUB ON L

Well System: WATER: PUBLIC - TYPE:

WELL LOG INFORMATION: DEPTH: _____ CASING DEPTH: _____ YIELD: _____ STATIC LEVEL: _____
WELL CONTRACTOR: _____ REG.# _____ PUMP CONTRACTOR: _____ REG.# _____
Construction Compliance GROUT APPROVED ☐ DATE _____ EHS _____
WELLHEAD APPROVED ☐ DATE _____ EHS _____
SYSTEM FINALIZED ☐ DATE _____ EHS _____

COMMENTS:

Operation Permit

DESIGN FLOW: _____ gal./min. ACTUAL FLOW: _____ INNOVATIVE LETTER: _____
INSTALLED BY: Glenn Carroll INSTALLATION APPROVED BY: Arnon L. Hults
PROPRIETARY SYSTEM: _____ FILTER NO: _____
COMMENTS:

OPERATIONS PERMIT ISSUED? Y OP DATE: 1-3-07 BY: Arnon L. Hults 1/3/07

This permit is based in part on information provided by the homeowner or his/her representative in the application submitted for this permit. The Environmental Health Specialist is not responsible for false or misleading information contained in the application. The Environmental Health Specialist is also not responsible for concealed conditions on the property or for statements in this report that may have resulted from false or misleading statements provided to him in the application. Neither Wake County nor the Environmental Health Specialist warrants that the septic tank system will continue to function satisfactorily in the future or that the water supply will remain potable.

As Built Information:

Date: 11-6-06 Benchmark: Tank Rod reading: 8'3 3/4" 100' Distance to Structure: 10'
ST: 1000 gals ID#: STB-814 D.O.M.: 9-16-06 Elev.: 8'8 3/4" Distance to Well: NA
PT: 1000 gals ID#: PT-53 D.O.M.: 9-16-06 Elev.: 8'8 3/4" (rod)
D-box/FD/PM elev.: 5'5 3/4" (rod) Supply Line: 55' ft. Pump/Control Panel: _____
Line 1: 7'1/2" _____ Date: _____ Line 6: _____ Date: _____
Line 2: 7'6" _____ Date: _____ Line 7: _____ Date: _____
Line 3: 8'3 1/2" _____ Date: _____ Line 8: _____ Date: _____
Line 4: _____ Date: _____ Line 9: _____ Date: _____
Line 5: _____ Date: _____ Line 10: _____ Date: _____
Distance to P/L: _____ Notes: Needs interceptor drain checked as well as
filter & Pump final 11-6-06

WAKE COUNTY DEPARTMENT OF ENVIRONMENTAL SERVICES WELL AND SEWAGE SITE LOCATION PERMIT
NO PERMIT(S) FOR CONSTRUCTION, LOCATION OR RELOCATION ACTIVITY SHALL BE ISSUED
UNTIL AN AUTHORIZATION FOR WASTEWATER SYSTEM CONSTRUCTION HAS BEEN ISSUED

PERMIT VOID IF NOT IN COMPLIANCE WITH ZONING REGULATIONS AND/ OR IF SITE IS ALTERED OR INTENDED USE CHANGED

PERMIT#: D037200 STATUS: A APP. DATE: 06/01/2006 BLDG. PERMIT#: 0063999
PIN: 0695.02 76 6454 000 TAX MAP: 0881 0064 RECORDED: Y ORIG. PERMIT#:
TOWNSHIP: 15 PANTHER BRANCH JURISDICTION: WC ZONING: R30
APPLICANT: DTF CONSTRUCTION
8113 WHITE STAR DR.
FUQUAY VARINA, NC 27526
(919) 868 - 5810
USE: HD USE: 101 ONE-FAMILY HOUSE
EXIST USE:
DISPOSAL: BEDROOMS: 3 BASEMENT: N #EMPLOYEES: 0 FOUND DRAIN: Y
SITE: ADDRESS: 7308 CHIMARA CT
SUBDIVISION: REBARAH MOOR LOT: 09 ACRES: 0.74
DIRECTION: 401S TO OLD STAGE RD TO CARLIE ADAM AND GO TL
TURNER FISH RD GO R SUB ON L

IMPROVEMENT PERMIT

TANK SIZE: 1000 gal. PUMP Tank: 1000 gal. SQ FT: 1200 STONE DEPTH: 12 in. MAX DEPTH LINE: 24 in.
WASTEWATER: INDIVIDUAL SEWAGE: DOMESTIC TYPE SYSTEM: III B PUMP: Y P/M: N
DAILY FLOW: 360 gal/day DESIGN FEE REQ?: PAID?: WATER: PUBLIC

COMMENTS:

IP ISSUED? Y DATE: 06/27/2006 BY: (ELC) *Ernest L. Lester* PHONE#: 856-5380

AUTHORIZATION FOR WASTEWATER/WATER SYSTEM CONSTRUCTION

VOID SIXTY (60) MONTHS FROM DATE OF ISSUANCE

AUTHORIZATION CONDITIONS:

Contractors shall install system on contours, see attached site plan for wastewater system design and well location. No underground utilities, water lines or sprinkler systems may be located in the original system or repair areas. A septic tank filter with a riser for access is required. The wastewater system shall not be covered or placed into use until inspected by the Wake County Department of Environmental Services and an Operation Permit issued. An Accepted Status System may be used in place of conventional system, if it can be placed in the permitted/authorized trench footprint (except reduction in line length and/or number as allowed for in approval) and the installation is in accordance with the accepted system approval, without unauthorized product alteration. If permit required use of an Accepted Status System, substitution with another accepted status system may be made, as long as no changes are necessary in the location of each nitrification line (including any increase in line length), trench depth or effluent distribution method. If changes are necessary, prior approval by this office is required before system installation. **OTHER CONDITIONS:**

INSTALL INTERCEPTOR DRAIN 10 FEET ABOVE TOP SEPTIC DRAIN LINE. SEE ATTACHED DIAGRAM AND C.A. SITE PLAN.

TANK SIZE: 1000 gal. PUMP TANK: 1000 gal. SQ FT: ⁹⁰⁰~~1200~~ STONE DEPTH: 12 in. MAX DEPTH LINE: 24 in.
MAINT: N OPER: N L/O: Y TRENCH#: 34 LENGTH: 100 ft. WIDTH: 36 in. DESIGNER:
SUBFIELDS: _ DESIGN HEAD PRESSURE: _ DESIGN FLOW: _ gal/min DOSE VOLUME: 180 gal.

CA ISSUED? Y DATE: 06/27/2006 BY: (ELC) *Ernest L. Lester* PHONE#: 856-5380

Plot Plan Only, NOT a Survey

Curve	Ra
C-1	50
C-2	25

Permanent Open Space

AS Built

I certify that the location of planned or existing structures are accurately shown. I understand failure to locate structures in accordance with this plot plan may require the relocation of structure(s) regardless of degree of completion. I hereby grant permission to Municipal/County Representatives the right of entry to make evaluations or inspections upon this property.

[Signature]
Signature of Owner or Authorized Agent


Chord Bear.
S 09°48'19" E
S 10°50'20" E

0063999
D37200



MAP BOOK 2005 PAGE 373

Pin# 069502766454

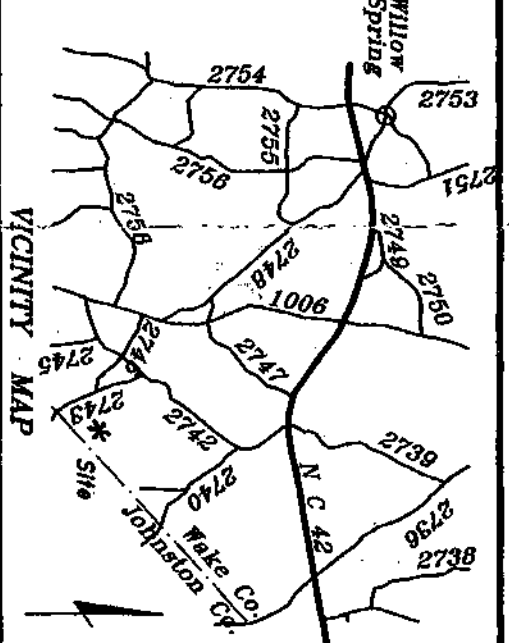

Lot #8 Rebarah Moor Subdivision
7308 Chimara Court
Map Book 2006 Page 373


Property of

DTF Construction

Panther Branch Twp. Wake County

Scale: 1" = 40' Date: 03-13-06

Surveyed & Mapped By
STANCIL & ASSOCIATES
Professional Land Surveyor, P.A.
P.O. Box 730, Angier, N.C. 27501
919-639-2133 919-639-2602 (FAX)

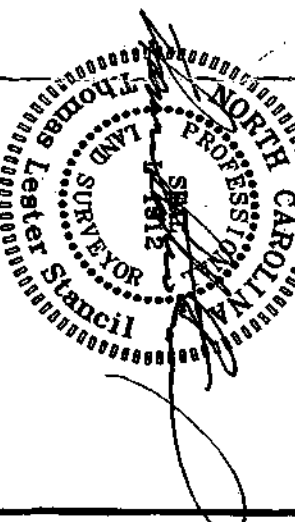

NOT FOR RECORDATION

Proposed Impervious Area
House = 1456.25 Sq. Ft.
Drive = 1441.14 Sq. Ft.
Total = 2897.39 Sq. Ft.



Zoning (8) R30 By CHL
Approve ☒ Date 6.1.06
Revise ☐ Use 101
Reject ☐ MBL
Front 15 Rear 15
Side 5 Corner
Comments: Close

117.52' to the PC of
Rebarah Moor Dr.

7308
Chimara Court
50' Public R/W

SWPB-2132

GWP

Plot Plan Only, NOT a Survey

Curve	Re
C-1	56
C-2	25

Permanent Open Space



Proposed Impervious Area
House = 1465.25 Sq. Ft.
Driv = 1441.14 Sq. Ft.
Total = 2896.39 Sq. Ft.

Conventional Repair

(Maximum Allowable Impervious Area 4419 Sq. Ft.)

Small gully

Int. Drain

0.742 AC.

Press. Man. Conv. Repair

I certify that the location of planned or existing structures are accurately shown. I understand failure to locate structures in accordance with the plot plan may require the relocation of structures) regardless degree of completion. I hereby grant permission to Municipal/County Representatives the right of entry to make evaluations or inspections upon this property.

[Signature]
Signature of Owner or Authorized Agent

Chord Bear.
S 08°48'19" E
S 18°50'20" E

C.A.
Site Plan
Part A
0063999
D371200




MAP BOOK 2005 PAGE 373

Pin# 069502766454

117.52' to the PC of Rebarah Moor Dr.

7308 Chimara Court
50' Public R/W

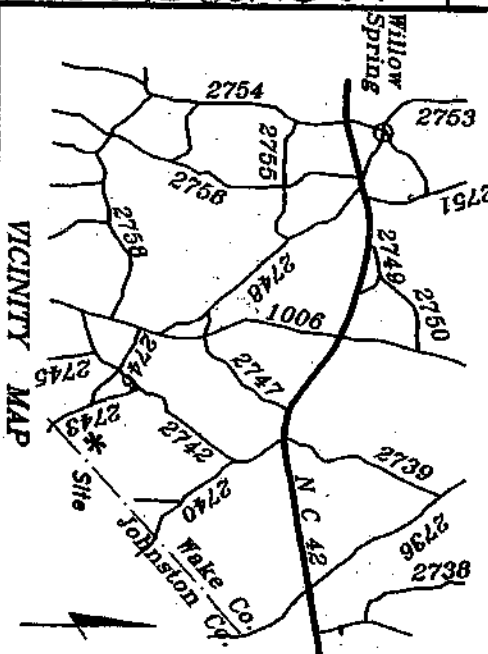

DTF Construction

Property Of

Panther Branch Twp. Wake County


Scale: 1" = 40' Date: 03-13-06

Surveyed & Mapped By
STANCI & ASSOCIATES
Professional Land Surveyor, P.A.
P.O. Box 730, Angier, N.C. 27501
919-639-2133 919-639-2602 (FAX)




NOT FOR RECORDATION

INTERCEPTOR DRAIN DETAILS

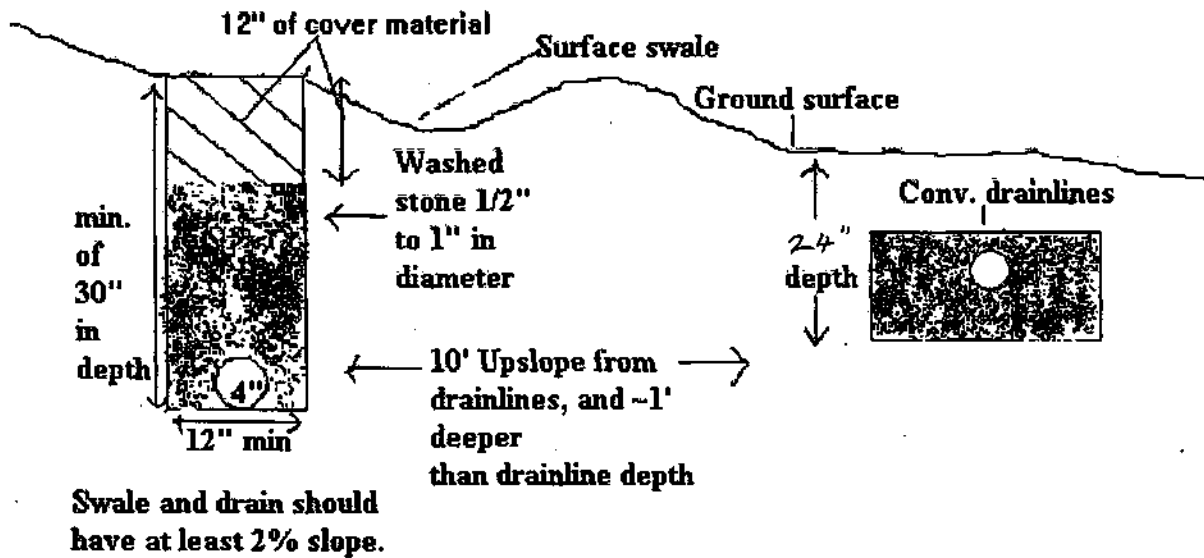

C.A. Site Plan
Part B

Wake County Department Of Environmental Services

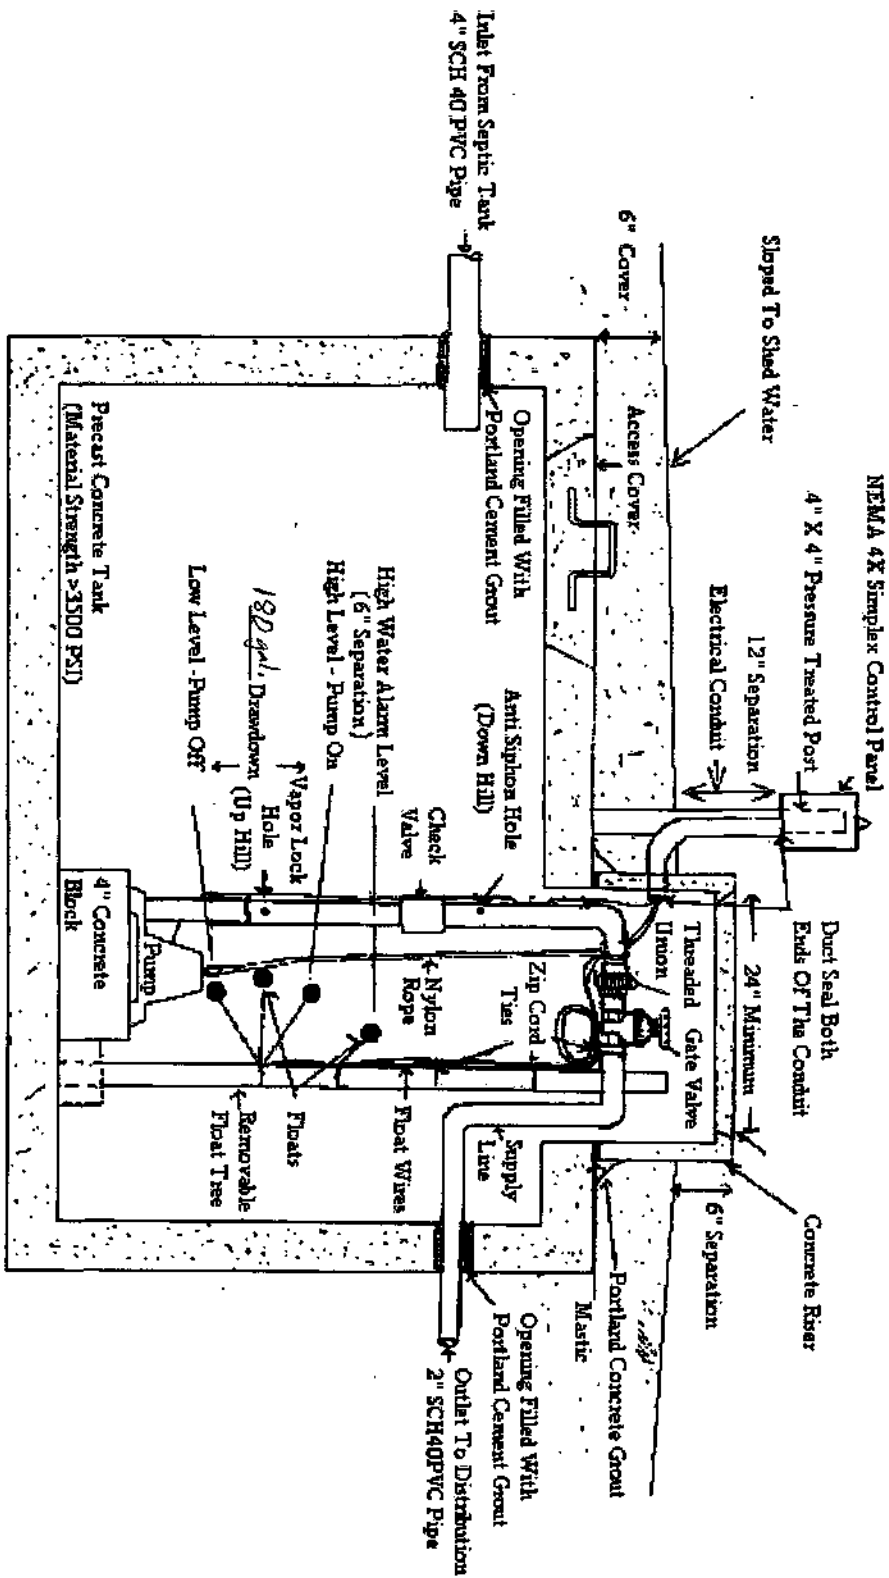

GALLON PUMP TANK

C. A. Part C