

WAKE COUNTY DEPARTMENT OF ENVIRONMENTAL SERVICES WASTEWATER PERMIT

NO PERMIT(S) FOR CONSTRUCTION, LOCATION OR RELOCATION ACTIVITY SHALL BE ISSUED UNTIL AN AUTHORIZATION FOR WASTEWATER SYSTEM CONSTRUCTION AUTHORIZATION HAS BEEN ISSUED

PERMIT VOID IF NOT IN COMPLIANCE WITH ZONING REGULATIONS AND/OR IF SITE IS ALTERED OR INTENDED USE CHANGED

OPERATIONS PERMIT

PERMIT # WREP-092035-2022

APPLICATION DATE: 11/04/2022

BLDG. PERMIT#:

PIN: 0798562273

RECORDED: Yes

TOWNSHIP: 02 - Bartons Creek

JURISDICTION: Wake County

ZONING: R-40W

APPLICANT: Robert Distefano
2404 BEECHVIEW CT

BUSINESS PHONE:

HOME PHONE:

MOBILE PHONE: (919) 847-5105

HD USE: 0001 REPAIR/EXISTING SYSTEM

EXISTING USE: 101A CONVENTIONAL ONE-FAMILY HOUSE

SITE ADDRESS: 2404 BEECHVIEW CT

SUBDIVISION: HERITAGE POINT SUB

LOT: 65

ACRES: 1.26

DIRECTIONS: Take Capital Blvd to US 70/Glenwood Ave, Merge onto NC 50/Creedmore Rd, Right on Southampton Dr., Left on Stage Ford, Right on Beechview.

Systems defined as either type III-b, III-g with a pump, IV, V or VI, in accordance with the North Carolina administrative code 15A NCAC 18a .1961, table V as adopted by reference in the "Regulations Governing Wastewater Treatment Dispersal Systems in Wake County", requires Wake County Environmental Services to conduct periodic inspections of the system type pursuant to 15A NCAC 18a. 1961 (j). Fees for these inspections will be charged as per the approved Fee Schedule. In addition, all systems are to be operated and maintained as specified in 15A NCAC 18A .1961. This permit is based in part on information provided by the homeowner and/or his/her representative in the application submitted for this permit. The Environmental Health Specialist is not responsible for false or misleading information contained in the application. The environmental health specialist is also not responsible for concealed conditions on the property or for statements in this report that may have resulted from false or misleading statements provided to him/her in the application. Neither Wake County nor the Environmental Health Specialist warrants that the septic tank system will continue to function satisfactorily in the future or that the water supply will remain potable.

OPERATION PERMIT VALID FOR: No Expiration

INSTALLED BY: DURHAM JR, JACK B - 2462 - IV

PROPRIETARY SYSTEM: TANK - Septic/Pump Tank
Replacement

PRETREATMENT SYSTEM:

SYSTEM TYPE INSTALLED: II B

OPERATION PERMIT: STATUS: Issued

ISSUED BY: Amanda Cabiness

ISSUED DATE: 06/14/2023

SEPTIC TANK: David Brantley & Sons - STB-323 - 1250 gallons

DATE OF MANUFACTURE: 03/09/2023

FILTER: Polylok - PL-68

GREASE TRAP:

DATE OF MANUFACTURE:

FILTER:

DOSING PUMP TANK:

DATE OF MANUFACTURE:

FILTER:

CC1: ETM1:

CC2:

ETM2:

RECIRCULATION TANK:

DATE OF MANUFACTURE:

CC1: ETM1:

CC2:

ETM2:

SEPTIC TANK ELEVATION: 4.00

GREASE TRAP ELEVATION:

DOSING PUMP TANK ELEVATION:

RECIRCULATION TANK ELEVATION:

DISTRIBUTION DEVICE ELEVATION: 6

INSTALLED TRENCH DEPTH	INSTALLED AGGREGATE DEPTH	INSTALLED TRENCH LENGTH	INSTALLED TRENCH BOTTOM ELEVATION

ACTUAL PRESSURE HEAD:

ACTUAL FLOW RATE:

ACTUAL DOSE VOLUME: 0


SPECIFIC OPERATION REQUIREMENTS:

THIS SYSTEM IS DESIGNED FOR A 4 BEDROOM SINGLE FAMILY DWELLING WITH A DAILY DESIGN FLOW OF 480 GALLONS PER DAY.

ISSUED BY:



DATE: 06/14/2023

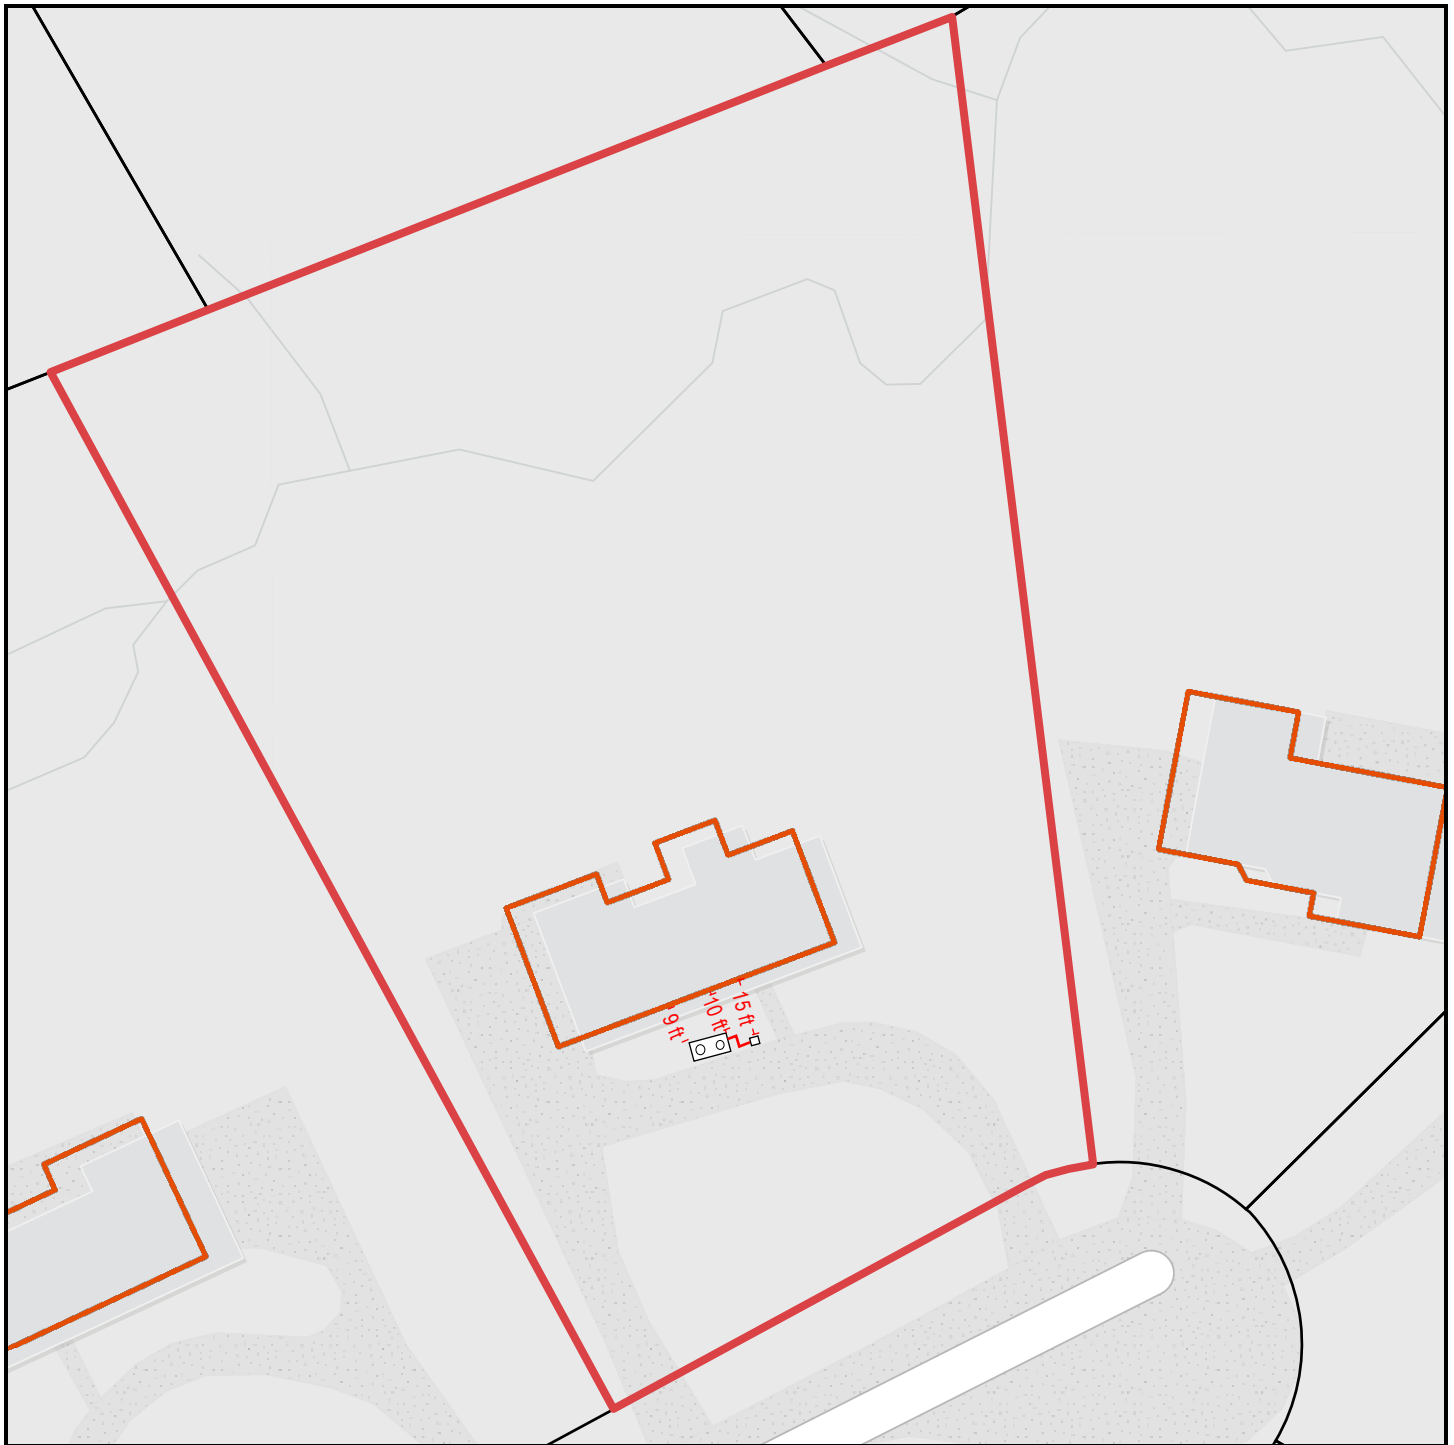


2404 Beechview Ct

WREP-092035-2023

OPERATION PERMIT

AHC - 6/14/2023

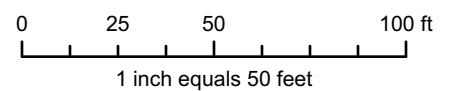

Disclaimer

*iMaps makes every effort to produce and publish the most current and accurate information possible. However, the maps are produced for information purposes, and are **NOT** surveys. No warranties, expressed or implied, are provided for the data therein, its use, or its interpretation.*