

Environmental Services - Water Quality
Onsite Wastewater Scan Data Entry Form

PERMIT #: 0018542

PIN #: 1608159979

OP DATE: 10/10/2000

SYSTEM USE:

- ☒ House
☐ Mobile Home
☐ Business
☐ Other

SEWAGE TYPE:

- ☒ Domestic
☐ Industrial

PUMP/SIPHON?:

- ☒ Yes
☐ No

PRESSURE MANIFOLD:

- ☐ Yes
☒ No

SYSTEM TYPE:

- ☐ I
☐ II
☒ III
☐ IV
☐ V
☐ VI
☐ Other

SUB TYPE:

- ☐ A
☒ B
☐ C
☐ D
☐ E
☐ F
☐ G

NBR BEDROOMS:

- ☐ 1
☐ 2
☒ 3
☐ 4
☐ 5
☐ 6
☐ Other

MAINT. SCHEDULE:

- ☐ Yes
☒ No

CERT. OPERATOR

- ☐ Yes
☒ No

GT ST PT SIZE

- | | | | |
|-------------------------------------|-------------------------------------|-------------------------------------|------------------|
| ☐ | ☐ | ☐ | 750 |
| ☐ | ☐ | ☐ | 900 |
| ☐ | ☒ | ☒ | 1,000 |
| ☐ | ☐ | ☐ | 1,200 |
| ☐ | ☐ | ☐ | 1,500 |
| ☐ | ☐ | ☐ | 1,800 |
| ☐ | ☐ | ☐ | 2,100 |
| ☐ | ☐ | ☐ | 2,500 |
| ☐ | ☐ | ☐ | 3,000 |
| ☐ | ☐ | ☐ | 4,000 |
| ☐ | ☐ | ☐ | 5,000 |
| ☐ | ☐ | ☐ | 8,000 |
| ☐ | ☐ | ☐ | 10,000 |
| ☒ | ☐ | ☐ | Other |
| ☐ | ☐ | ☐ | None/NA GT or PT |

DRAINFIELD SIZE(SQ. FT.)

00900

DRAIN TYPE:

- ☐ Stone
☒ EZ Flow
☐ Infiltrator
☐ Biodiffuser
☐ Cultec
☐ Drip
☐ Hancor
☐ Large Dia. Pipe
☐ Multi-Pipe
☐ Other

MAX DEPTH (IN.):

- ☐ 12 in. or less
☐ 18 in. or less
☒ 24 in. or less
☐ 26 in. or less
☐ 28 in. or less
☐ 30 in. or less
☐ 32 in. or less
☐ 36 in. or less
☐ Other

STONE DEPTH (IN.):

- ☐ 8 in. or less
☒ 12 in. or less
☐ 18 in. or less
☐ 24 in. or less
☐ Other

TRENCHES:

- ☒ Individual
☐ Bed

TRENCH WIDTH (IN.):

- ☐ 12 in. or less
☐ 18 in.
☐ 24 in.
☒ 36 in.
☐ 6 ft. or less
☐ 9 ft. or less
☐ Other

nrh

WAKE COUNTY DEPARTMENT OF ENVIRONMENTAL SERVICES WELL AND SEWAGE SITE LOCATION PERMIT

NO PERMIT(S) FOR CONSTRUCTION, LOCATION OR RELOCATION ACTIVITY SHALL BE ISSUED

UNTIL AN AUTHORIZATION FOR WASTEWATER SYSTEM CONSTRUCTION HAS BEEN ISSUED

PERMIT VOID IF NOT IN COMPLIANCE WITH ZONING REGULATIONS AND/OR IF SITE IS ALTERED OR INTENDED USE CHANGED

PERMIT#: D018542 STATUS: A APP DATE: 06/02/2000 BLDG PERMIT#: 0004242
 APPLICANT: COMFORT HOMES DAY PHONE: (919) 553 - 3242
 ADDRESS: P O BOX 369 FAX#: (919) 550 - 9017
 CITY: CLAYTON STATE: NC ZIP: 27520
 OWNER: A & D PROPERTIES DAY PHONE: (919) 999 - 9999
 ADDRESS: 5430 ROCKSIDE SRV STAT RD FAX#: (919) 999 - 9999
 CITY: RALEIGH STATE: NC ZIP: 27603
 HD USE CD: 101 ONE-FAMILY HOUSE ORIG PERMIT#: REC?: Y
 EXIST USE: TAX MAP#: 0007 0000
 BEDROOMS: 3 BSMT: N #EMPLOYEES: 0 WATER: C WASTEWATER: I GARB DISPOSAL: N
 TOWNSHIP: 15 PANTHER BRANCH JURIS: WC ZON: R40 PIN: 1608.01 06 4079 000
 SUBD#: S 000 000 00 SUBD NAME: SANDY RIDGE LOT-SEC: 2 ACRE: 1.04
 IMPRV PRMT: ISSUED?: Y DATE: 07/14/2000 BY: RD* TYPE SYSTEM: III G PUMP: Y
 CNSTR AUTH: ISSUED?: Y DATE: 07/13/2000 BY: RJD MAINT: N OPER: N
 RECEIPT#: 0056269 FEE: 290.00 OP DATE: BY: 1608 15 9979
 WATR SAMPL: REQ?: N APPROVED?: DATE: PROPRIETARY SYS:
 ST#: 1025 MI: DIR: NAME: ASHTON HOLLOW DIR: TYP: DR
 DIRECTIONS: GO 401 S-LEFT SR1010-RIGHT HOLLAND CHURCH RD-
 SUB DIV ON RIGHT--LOT #
 S.T.-P.T. Drumlins checked. 9-13-00 ** NEED pump final / Alarm checked

IMPROVEMENT PERMIT

SIZE OF TANK 1000 ST 1000 PT GALS. TOTAL SQ. FT. 900 DEPTH OF STONE PSA IN. MAX. DEPTH LINE 24 IN.

WASTEWATER: DOMESTIC ☒ INDUSTRIAL ☐

I.P. ISSUED BY

Ron Duddy R.S.

AUTHORIZATION FOR WASTEWATER SYSTEM CONSTRUCTION

VOID SIXTY (60) MONTHS FROM DATE OF ISSUANCE

AUTHORIZATION CONDITIONS

Contractor To Follow Contours, See Attached Site Plan For Wastewater System Design And Well Location. The wastewater system shall not be covered or placed into use until inspected by the Wake County Department of Environmental Services and an Operation Permit issued.

OTHER CONDITIONS: BT5 6/27/00 EEEEZZLAY SYSTEM REDUCTION TAKEN

SIZE OF TANK 72400 BT5 1000 ST 1000 PT GALS. TOTAL SQ. FT. 900 DEPTH OF STONE PSA IN. MAX. DEPTH LINE 24 IN.
 ST FILTER REQUIRED ☒ NUMBER OF TRENCHES 3 LENGTH OF TRENCHES 100 FT. WIDTH OF TRENCHES 3 FT.

C.A. ISSUED BY Ron Duddy R.S. INSTALLED BY Rickey Holland CTR. I.D. #

SEPTIC TANK FILTER USED

INNOV. APPRL. #: IWWS- 9/13/00 DATE INSTALLATION APPROVED BY Ron Duddy R.S.

WELL SYSTEM = PRIVATE ☐ SEMI-PUBLIC ☒ NEW ☐ REPLACEMENT ☐ EXISTING ☐

WELL LOG INFORMATION = DEPTH _____ CASING DEPTH _____ YIELD _____ STATIC LEVEL _____

WELL CONTRACTOR _____ REG.# _____ PUMP CONTRACTOR _____ REG.# _____

CONSTRUCTION COMPLIANCE = GROUT APPROVED ☐ DATE _____ EHS
 WCHD ID # _____ WELLHEAD APPROVED ☐ DATE _____ EHS
 NEGATIVE BACTERIOLOGICAL RESULTS ☐ DATE _____ EHS
 SYSTEM FINALIZED ☐ DATE _____ EHS

COMMENTS:

 This permit is based in part on information provided by the homeowner or his/her representative in the application submitted for this permit. The Environmental Health Specialist is not responsible for false or misleading information contained in the application. The Environmental Health Specialist is also not responsible for concealed conditions on the property or for statements in this report that may have resulted from false or misleading statements provided to him in the application. Neither Wake County nor the Environmental Health Specialist warrants that the septic tank system will continue to function satisfactorily in the future or that the water supply will remain potable.


As Built

I certify that the location of this structure is accurately shown. Failure to locate this structure in accordance with this plot plan could require relocation of the structure regardless of its degree of completion.
Signature _____
Check one () Owner () Builder/Contractor () Other
Date _____
1608.0115 545
LOT 3
BOM 1889 PG 2076

Comments: *See attached floor plan*

Zoning	R-2U	Use	MBL
Approve	Date 6-1-91	Revise	
Reject		Front	15
		Rear	30
		Side	5
		Corner	



1000 S.F.
1000 P.F.
3(160' x 3')
ECC 222109
24 DEPT
"PRELIMINARY PLAT"
NOT FOR RECORDATION,
CONVEYANCE OF SALES
* LINES FLAGGED

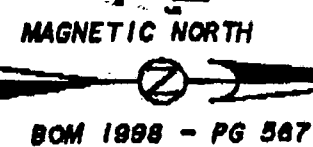

BOM 1888 - PG 587

AN FOR
HOMES
TOWNSHIP
COUNTY
CAROLINA

WITHIN 2000'.
COORDINATE METHOD.
ANDY RIDGE SUBD., CLUSTER
1889 PG 2076
& ASSOC., P.A.

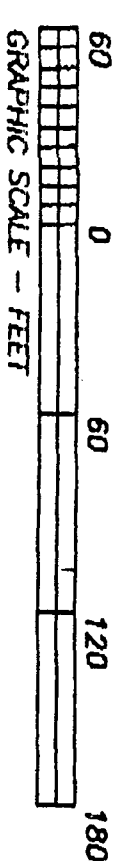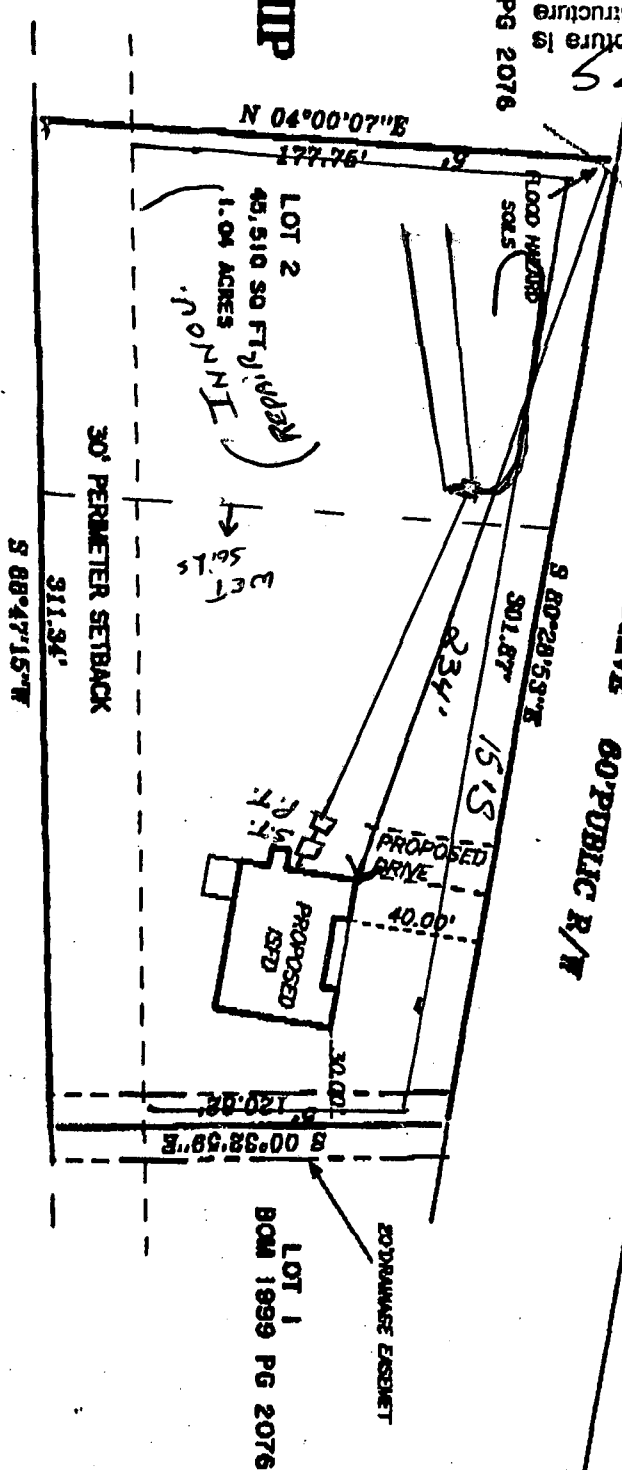

GRAPHIC SCALE - FEET

PLAN 1565-71 "WAYNE" (REVERSED)

DRAWN BY: CDR
CHECKED BY:
DATE:
SCALE: 1" = 60'
JOB: 2185 CDR653
FB:

#0004242
#18542

MAGNETIC NORTH

"PRELIMINARY PLAT"
NOT FOR RECORDATION,
CONVEYANCE OF SALE.

#000 42 42
D#18542

AS BUILT

DRAWN BY: CDR



CHECKED BY:

DATE:

SCALE: 1" = 60'

JOB: 2185 CDR653

FB:

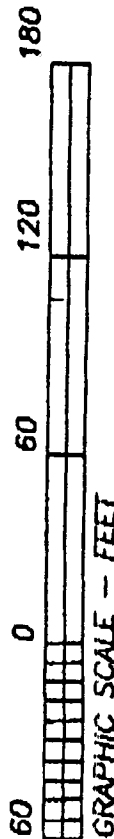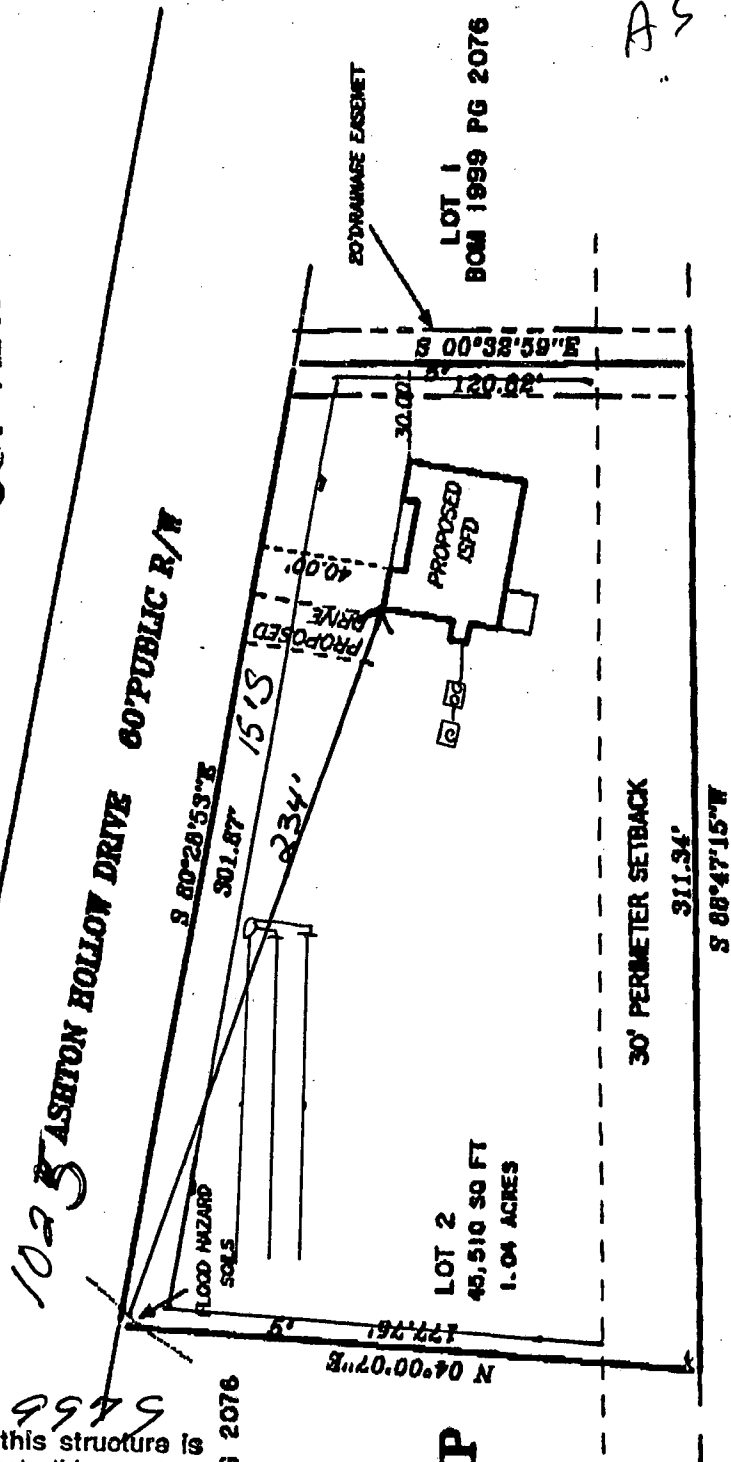

PLAN 1565-11 "WAYNE" (REVERSED)

Comments: *As shown from plot*

Side 5 Corner 5

Front 15 Rear 30

Reject MBL

Revise 101

Approve 6-30 Date 6-1-00

Zoning R-30

1608.0115 9949

I certify that the location of this structure is accurately shown. Failure to locate this structure in accordance with this plot plan could require relocation of the structure regardless of its degree of completion.

Signature Wayne Date 5-30-00

Check one () Owner () Builder/Contractor: () Other

AN FOR
HOMES
NCH TOWNSHIP
OUNTY
CAROLINA

WITHIN 2000'.
COORDINATE METHOD.
ANDY RIDGE SUBD., CLUSTER
1989 PG 2076
& ASSOC., P.A.

