

Environmental Services - Water Quality
Onsite Wastewater Scan Data Entry Form

1-2

PERMIT #: B034884

PIN #: 1784394380

OP DATE: 0713011986

SYSTEM USE:

- ☒ House
☐ Mobile Home
☐ Business
☐ Other

SEWAGE TYPE:

- ☒ Domestic
☐ Industrial

PUMP/SIPHON?:

- ☐ Yes
☒ No

PRESSURE MANIFOLD:

- ☐ Yes
☒ No

SYSTEM TYPE:

- ☐ I
☒ II
☐ III
☐ IV
☐ V
☐ VI
☐ Other

SUB TYPE:

- ☒ A
☐ B
☐ C
☐ D
☐ E
☐ F
☐ G

NBR BEDROOMS:

- ☐ 1
☐ 2
☒ 3
☐ 4
☐ 5
☐ 6
☐ Other

MAINT. SCHEDULE:

- ☐ Yes
☒ No

CERT. OPERATOR

- ☐ Yes
☒ No

GT ST PT SIZE

- | | | | |
|-------------------------------------|-------------------------------------|-------------------------------------|------------------|
| ☐ | ☐ | ☐ | 750 |
| ☐ | ☐ | ☐ | 900 |
| ☐ | ☒ | ☐ | 1,000 |
| ☐ | ☐ | ☐ | 1,200 |
| ☐ | ☐ | ☐ | 1,500 |
| ☐ | ☐ | ☐ | 1,800 |
| ☐ | ☐ | ☐ | 2,100 |
| ☐ | ☐ | ☐ | 2,500 |
| ☐ | ☐ | ☐ | 3,000 |
| ☐ | ☐ | ☐ | 4,000 |
| ☐ | ☐ | ☐ | 5,000 |
| ☐ | ☐ | ☐ | 8,000 |
| ☐ | ☐ | ☐ | 10,000 |
| ☐ | ☐ | ☐ | Other |
| ☒ | | ☒ | None/NA GT or PT |

DRAINFIELD SIZE(SQ. FT.)

01100

DRAIN TYPE:

- ☒ Stone
☐ EZ Flow
☐ Infiltrator
☐ Biodiffuser
☐ Cultec
☐ Drip
☐ Hancor
☐ Large Dia. Pipe
☐ Multi-Pipe
☐ Other

MAX DEPTH (IN.):

- ☐ 12 in. or less
☐ 18 in. or less
☐ 24 in. or less
☐ 26 in. or less
☒ 28 in. or less
☐ 30 in. or less
☐ 32 in. or less
☐ 36 in. or less
☐ Other

STONE DEPTH (IN.):

- ☐ 8 in. or less
☒ 12 in. or less
☐ 18 in. or less
☐ 24 in. or less
☐ Other

TRENCHES:

- ☒ Individual
☐ Bed

TRENCH WIDTH (IN.):

- ☐ 12 in. or less
☐ 18 in.
☐ 24 in.
☒ 36 in.
☐ 6 ft. or less
☐ 9 ft. or less
☐ Other

≈ 28"

5/7/15 MJ

WAKE COUNTY HEALTH DEPARTMENT SEPTIC TANK LAYOUT AND PERMIT

34884

TAX MAP NO. 475 PARCEL NO. 11/51

PERMIT NO. B
OPERATION PERMIT ☐

CONTRACTOR Allen Sprivy

OWNER _____ DATE 1 July 86

LOCATION 1784 39 4380

S. R. NO. 97

SUBDIVISION NAME Fall Creek LOT NO. 24 SECTION OR BLOCK NO. _____

REPAIR ☐ ORIGINAL PERMIT NO. _____

GARBAGE DISPOSAL UNIT YES ☐ NO ☒

HOUSE ☒ MOBILE HOME ☐ BUSINESS ☐

NO. BEDROOMS 3 LOT AREA 20,000

SIZE OF TANK 1000 gal.

NITRIFICATION LINE 1100 2x13'x185' sq. ft.


DEPTH OF STONE IN LINES: 12" ☒

RISER AND BAFFLE REQUIRED ☒ PUMP REQUIRED ☐

WATER SUPPLY: INDIVIDUAL ☐ PUBLIC ☒ OTHER ☐

- * PERMIT VOID 36 MONTHS FROM DATE OF ISSUANCE.
- * PERMIT VOID IF NOT IN COMPLIANCE WITH ZONING REGULATIONS
- * PERMIT MAY BE VOIDED IF SITE ALTERATIONS MADE

LAYOUT BY GE Dietrich

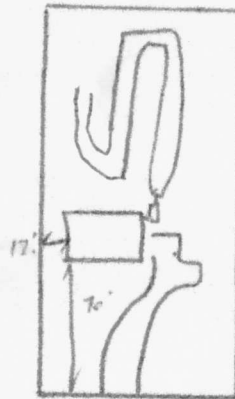

* Follow contour
* keep shallow
≤ 28"

DATE 30 July 86

INSTALLED BY V Pearce

APPROVED BY George Dietrich