

919-497-0277

PAGE 1 OF 2
252-478-3599

Franklin County Health Department
Division of Environmental Health
107 Industrial Drive-Suite C
Louisburg, North Carolina 27549

Phone: 919-496-8100

SEPTIC PERMIT

Fax: 919-496-8136

Permit Number: 8207 Type: I PIN: 2831-41-1617 Date: 7/1/2015

Applicant: PINERIDGE CONSTRUCTION Owner: TIMOTHY & SALLY PRINCE
362 E JEWITT AVE 217 LAKE ROYALE
BUNN, NC 27508 LOUISBURG, NC 27549

Telephone: (252) 469-9873 Telephone:

Subdivision: LAKE ROYALE Lot Number: 1040/1041 Size: 0.680

Physical Address/ Location /Directions 115 RUNNING BEAR DR

Description: LifeTime _____ 5 Year X

TYPE FACIL SFD # EMPLOY 1 # BEDRMS 3 GPD 360 LTAR .35⁹/d

TYPE WAT Com TYPE SYS A TYPE REP N/A BSMT N BST FX N/A

SIZE TANK 900 SIZE CHB 1 SIZE NITR 3'x270' MTD 30"

COMMENTS: 270' Accepted drainline

Septic Contractors are responsible for notifying the health department for final inspections, between 8:00-9:00 AM on the day of completion, Monday - Friday. Any request for final inspections received afterwards will be scheduled the same day, if possible, or the next workday. Have permit number and owner/applicant's name ready when making the call.

Actions of representatives of state or local agencies engaged in the evaluation and determination of measures required to effect the compliance with the provisions of this permit shall in no way be taken as a guarantee that wastewater disposal systems permitted and approved will function in a satisfactory manner for any given period of time, or that such employees assume any liability for damages, consequential or direct which are caused, or may be caused, by a malfunction of this wastewater treatment and disposal system.

Proper precautions must be taken to assure the proper functioning of the system after it has been covered. Do not run any heavy equipment over the system, as soft earth will allow damage to the tank and lines. Pipe all roof drains away from the septic system site to prevent flooding of the lines from surface water. Terrace the ground to prevent excessive drainage from higher areas adjacent to the system. Do not construct driveways over any part of the septic system unless proper provisions were made when the septic system was constructed. Only grass, not trees or shrubbery, should be cultivated over the lines. All plumbing fixtures should be carefully inspected periodically and any problems repaired immediately. All septic tanks should be pumped off by a permitted pump operator on a regular schedule, not to exceed every five years.

The improvement permit and construction authorization is a site approval, for the future installation of a wastewater treatment and disposal system. Changes in ownership of the site do not affect the validity of this permit. However, any alteration of the site or soil conditions, changes in the location of the proposed facility, changes to the wastewater flow and/or characteristics, or submittal of false information with the application or misrepresentation of the property lines may subject this permit to suspension or revocation.

FOR THIS TO BE A VALID CONSTRUCTION AUTHORIZATION, A LAYOUT SHEET MUST BE ATTACHED

IMPROVEMENT PERMIT DATE 7/23/15 EHS [Signature]

CONSTRUCTION AUTHORIZATION DATE 7/23/15 EHS [Signature]

Visit www.franklincountyenvironmentalhealth.com for permit information and tracking.

Franklin County Health Department

Name: PINERIDGE CONST

Permit Number

8207

Permit # 3234

CONTRACTOR Joe Davis


TANK MANU

Mills 1000MANU DATE 6-15-15WELL INSTALLED YES ☐NO ☒

SYSTEM CODE

104-W-6

SEPTIC SYSTEM LAYOUT (SKETCH SYSTEM LAYOUT HERE)

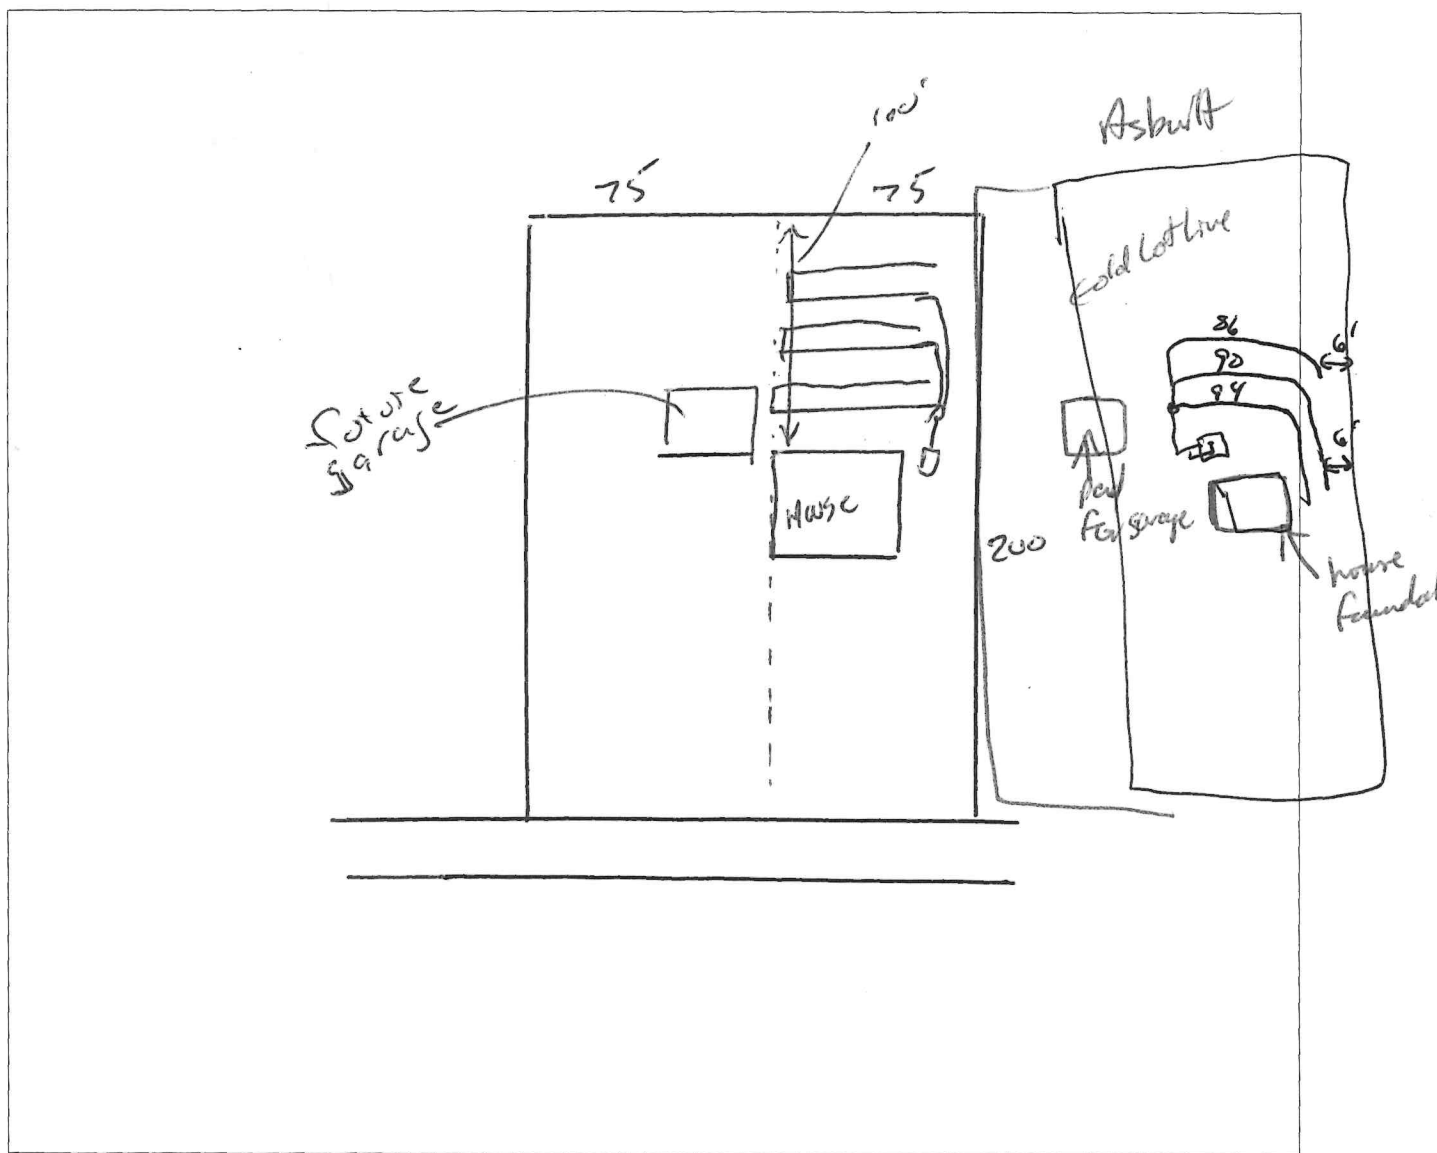

SEPTIC SYSTEM AS-BUILT

(IF DIFFERENT FROM INITIAL LAYOUT)

ON REVERSE

OPERATIONS PERMIT

DATE

8/19/15

EHS

COUNTY OF FRANKLIN

ENVIRONMENT HEALTH APPLICATION (496-8100)

Permit #: 39283

Permit Type: SEPTIC PERMIT

Date Issued: 07/01/2015

Project Address: 115 RUNNING BEAR DR, LOUISBURG NC 27549

Location: 115 RUNNING BEAR DR

Size #: 0.680

Subdivision: LAKE ROYALE

Lot #: 1040/1041

Applicant: PINERIDGE CONSTRUCTION INC

Phone: 252.469.9873

362 E JEWETT AVE

BUNN NC 27508

Owner Name: PRINCE TIMOTHY & SALLY

Phone:

Owners Address: 217 LAKE ROYALE

LOUISBURG NC 27549

Tax record: 19531

Pin #: 2831-41-1617

Parcel #: LR0403 1040

Zoned: R-1

Setbacks Front: 30

Rear: 25

Side: 10

Proposed Use: SFD

of bedrooms: 3

of people: 2

Township: CYPRESS

Public Water/Sewer: TESI (LK ROY)

ST Road #:

Desc:

Fees Due: \$400.00

Date Paid: 07/01/2015

* Please complete all sections below*

☐ Yes ☐ No Does this site contain any previously identified jurisdictional wetlands?☐ Yes ☐ No Is any wastewater, other than domestic, going to be generated?☐ Yes ☐ No Is the site subject to approval by any other public agency?

*If the answer to any of the above is "yes", applicant must submit supporting documentation.

Please indicate desired system type(s). Systems can be ranked in order of preference.

☐ Conventional ☐ Accepted ☐ Modified Conventional ☐ Alternative☐ Other ☐ No Preference

Call Environmental Health (919.496.8100) between 8:00 - 9:00 am Monday - Friday in order to schedule an appointment with an environmental health specialist for your lot evaluation. This application for an improvement permit/construction authorization and well permit does not constitute approval for zoning, septic or building permits. It will be necessary to meet all guidelines for zoning, septic and building permits prior to construction. The permit is valid for either 60 months or without expiration, depending upon documentation submitted. (complete site plan= 60 months—complete surveyed plat—without expiration.)

Please contact the Environmental Health Department at 919.496.8100 or visit their website at www.franklincountyenvironmentalhealth.com to determine the status of your application prior to visiting the Planning & Inspections Department to obtain a building permit.


I hereby certify that I am the owner, or authorized by the owner to act as his/her legal representation. Furthermore, as legal representative (if applicable) I have advised the owner of my intention to apply for this wastewater treatment and disposal system and drinking water and well system permit.

I also certify that all of the statements made in this application and any attached documents are true, complete, and correct, to the best of my knowledge and belief, and are made in good faith. If information in this application for these improvements is falsified, changed or site is altered, then improvement permits and authorization to construct these improvements shall become invalid. Authorized county representatives are granted right of entry to make these evaluations or inspections, and to release information upon public request.

X Ryan D Walker
Print & Signature of Owner or Owner's Legal Representative

07/01/2015

7/10
Sate
Post-drunk
on R
7th lot
on R

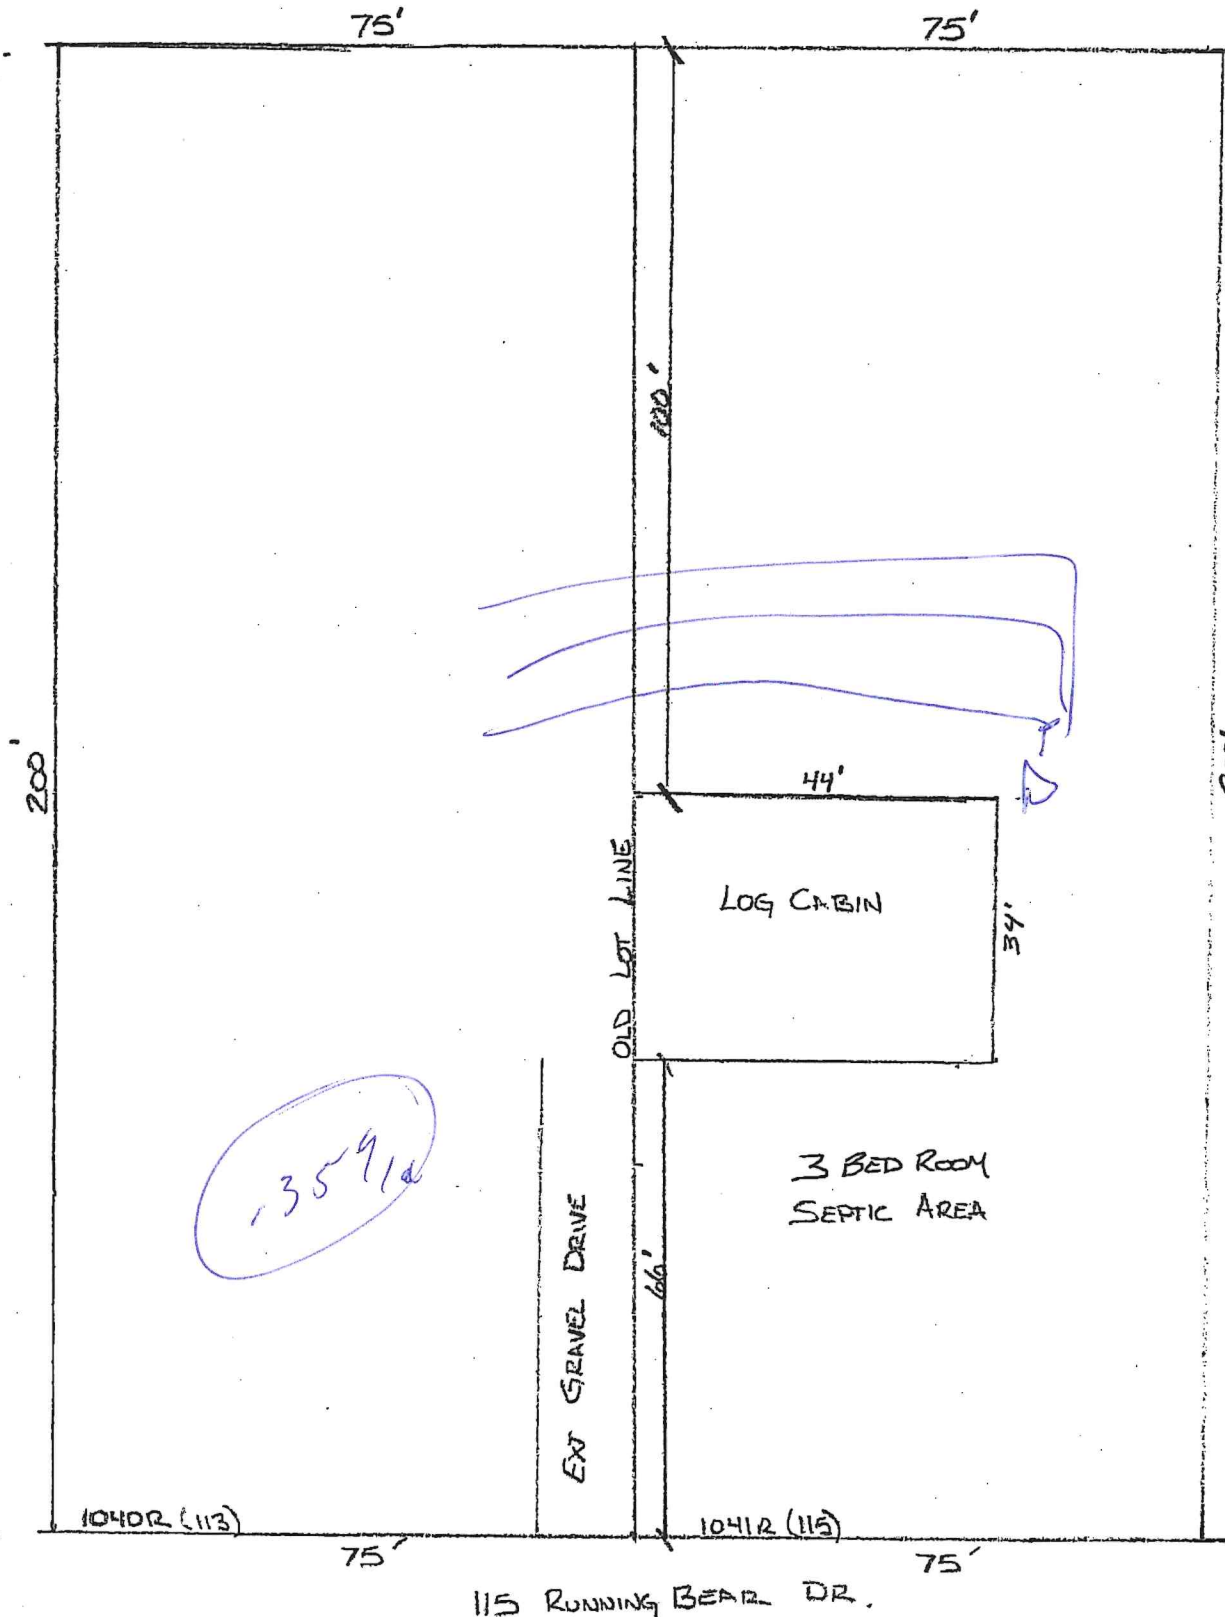

0-4
912
4-44
C
F, 9, 1
931C
94P

APPROVED

JTR 7/11/15

PINERIDGE CONST.
2196 SLEDGE RD.
LOUISBURG NC 27549
252-469-9873

LOT 30,000 sq ft
HOUSE 1,496 sq ft
DRIVE 1,200 sq ft
2696 sq ft 11.12%