

Environmental Services - Water Quality
Onsite Wastewater Scan Data Entry Form

PERMIT #: 0018303

PIN #: 1608435942

OP DATE: 0311011994

SYSTEM USE:

- ☒ House
☐ Mobile Home
☐ Business
☐ Other

SEWAGE TYPE:

- ☒ Domestic
☐ Industrial

PUMP/SIPHON?:

- ☐ Yes
☒ No

PRESSURE MANIFOLD:

- ☐ Yes
☒ No

SYSTEM TYPE:

- ☐ I
☒ II
☐ III
☐ IV
☐ V
☐ VI
☐ Other

SUB TYPE:

- ☒ A
☐ B
☐ C
☐ D
☐ E
☐ F
☐ G

NBR BEDROOMS:

- ☐ 1
☐ 2
☒ 3
☐ 4
☐ 5
☐ 6
☐ Other

MAINT. SCHEDULE:

- ☐ Yes
☒ No

CERT. OPERATOR

- ☐ Yes
☒ No

GT ST PT

- | | | | |
|-------------------------------------|-------------------------------------|-------------------------------------|------------------|
| ☐ | ☐ | ☐ | 750 |
| ☐ | ☐ | ☐ | 900 |
| ☐ | ☒ | ☐ | 1,000 |
| ☐ | ☐ | ☐ | 1,200 |
| ☐ | ☐ | ☐ | 1,500 |
| ☐ | ☐ | ☐ | 1,800 |
| ☐ | ☐ | ☐ | 2,100 |
| ☐ | ☐ | ☐ | 2,500 |
| ☐ | ☐ | ☐ | 3,000 |
| ☐ | ☐ | ☐ | 4,000 |
| ☐ | ☐ | ☐ | 5,000 |
| ☐ | ☐ | ☐ | 8,000 |
| ☐ | ☐ | ☐ | 10,000 |
| ☐ | ☐ | ☐ | Other |
| ☒ | | ☒ | None/NA GT or PT |

DRAINFIELD SIZE(SQ. FT.)

01000

DRAIN TYPE:

- ☒ Stone
☐ EZ Flow
☐ Infiltrator
☐ Biodiffuser
☐ Cultec
☐ Drip
☐ Hancor
☐ Large Dia. Pipe
☐ Multi-Pipe
☐ Other

MAX DEPTH (IN.):

- ☐ 12 in. or less
☐ 18 in. or less
☐ 24 in. or less
☐ 26 in. or less
☒ 28 in. or less
☐ 30 in. or less
☐ 32 in. or less
☐ 36 in. or less
☐ Other

STONE DEPTH (IN.):

- ☐ 8 in. or less
☒ 12 in. or less
☐ 18 in. or less
☐ 24 in. or less
☐ Other

TRENCHES:

- ☒ Individual
☐ Bed

TRENCH WIDTH (IN.):

- ☐ 12 in. or less
☐ 18 in.
☐ 24 in.
☒ 36 in.
☐ 6 ft. or less
☐ 9 ft. or less
☐ Other

3/1

WAKE COUNTY HEALTH DEPARTMENT WELL AND SEWAGE SITE, LOCATION PERMIT

ALL PERMITS VOID 60 MONTHS FROM DATE OF ISSUANCE

Pin # 1608.03435942 Project # 0940310

Tax Map No. 807 Parcel No. 4

Zoning R-30 Township Panther Branch

Owner/Contractor: Kenneth CHAULK

Location/Address: 1128 Harvey Johnson Rd

Improvement Permit

Well Permit No. **C** 18303

Operation Permit []

Date: 8/10/93

S.R. # 2726


Subdivision Name: _____

Lot No. _____

Section or Block No. _____

Preliminary Layout

Final Layout

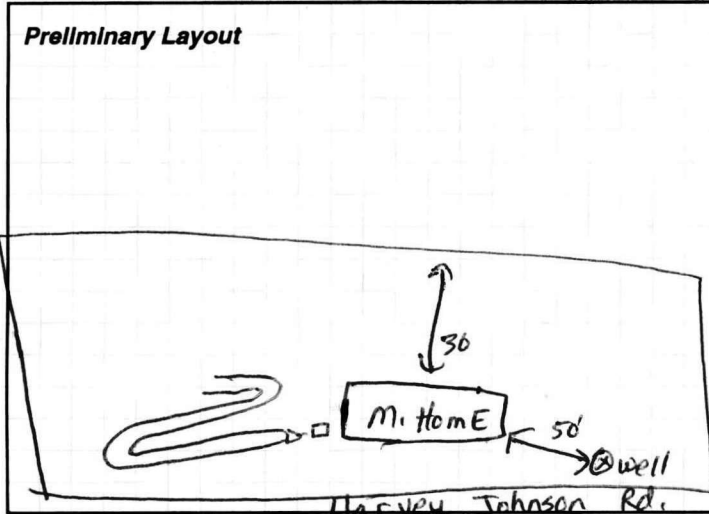

Sewage System Specifications

Repair [] Original Permit No. B36658

Garbage Disposal Unit Yes [] No [x]

House [x] Mobile Home [] Business []

No. of Bedrooms 3 Lot Area 2.30

Size of Tank 1000 gal.

Comments: _____

Nitrification Line (2) 167' x 3' 1000 sq. ft.

Depth of Stone: 12" [x] Max Depth of Trenches: 28 in.

Riser and Baffle Required [x] Pump Required []

Permit void if not in compliance with zoning regulations

Permits may be voided if site is altered or intended use changed

Layout by: H. B. Phillips

Date: 3/10/94

Installed By: MF (Building Date)

Approved By: _____

Well System
Individual [x] Semi-Public [] Public []
New [x] Replacement [] Repair []
Fee Paid: Yes [x] No []
Construction Compliance
Site Approved [] []
Well Head Approved [] []
Grouting Approved [] []

Final Inspection
Required Slab [] []
Chlorinated [] []
Required Certificate [] []
Variance (Explain) [] []
WCHD I.D. Affixed [] []
Sample Collected [] []

Bacteriological Results
Date Inspected _____ Sanitarian _____

Initial Sample: _____ Date: _____

* Re-Sample #1 _____ Date: _____

* Re-Sample #2 _____ Date: _____

* Re-chlorination as required [] Yes [] No

* Fees for all resamples

All checks payable to: **Wake County Health Department**

Comments: _____

Well Installed By: _____

Date System Finalized _____

Sanitarian _____

This report is based in part on information provided by the homeowner or his/her representative in the application submitted for this permit. The sanitarian is not responsible for false or misleading information contained in the application. The sanitarian is also not responsible for concealed conditions on the property or for statements in this report that may have resulted from false or misleading statements provided to him in the application. Neither Wake County nor the sanitarian warrants that the septic tank system will continue to function satisfactorily in the future or that the water supply will remain potable.

COPY TO HEALTH DEPARTMENT

3002.017 — 5/14/93