

Environmental Services - Water Quality
Onsite Wastewater Scan Data Entry Form

PERMIT #: **8025017**

PIN #: **0798955611**

OP DATE: **0212311983**

SYSTEM USE:

- ☒ House
☐ Mobile Home
☐ Business
☐ Other

SEWAGE TYPE:

- ☒ Domestic
☐ Industrial

PUMP/SIPHON?:

- ☐ Yes
☒ No

PRESSURE MANIFOLD:

- ☐ Yes
☒ No

SYSTEM TYPE:

- ☐ I
☒ II
☐ III
☐ IV
☐ V
☐ VI
☐ Other

SUB TYPE:

- ☒ A
☐ B
☐ C
☐ D
☐ E
☐ F
☐ G

NBR BEDROOMS:

- ☐ 1
☐ 2
☒ 3
☐ 4
☐ 5
☐ 6
☐ Other

MAINT. SCHEDULE:

- ☐ Yes
☒ No

CERT. OPERATOR

- ☐ Yes
☒ No

GT ST PT

- | | | |
|-------------------------------------|-------------------------------------|-------------------------------------|
| ☐ | ☐ | ☐ |
| ☐ | ☐ | ☐ |
| ☐ | ☒ | ☐ |
| ☐ | ☐ | ☐ |
| ☐ | ☐ | ☐ |
| ☒ | ☐ | ☒ |

SIZE

- 750
900
1,000
1,200
1,500
1,800
2,100
2,500
3,000
4,000
5,000
8,000
10,000
Other
None/NA GT or PT

DRAINFIELD SIZE(SQ. FT.)

01000

DRAIN TYPE:

- ☒ Stone
☐ EZ Flow
☐ Infiltrator
☐ Biodiffuser
☐ Cultec
☐ Drip
☐ Hancor
☐ Large Dia. Pipe
☐ Multi-Pipe
☐ Other

MAX DEPTH (IN.):

- ☐ 12 in. or less
☐ 18 in. or less
☐ 24 in. or less
☐ 26 in. or less
☐ 28 in. or less
☐ 30 in. or less
☐ 32 in. or less
☐ 36 in. or less
☒ Other

STONE DEPTH (IN.):

- ☐ 8 in. or less
☐ 12 in. or less
☒ 18 in. or less
☐ 24 in. or less
☐ Other

TRENCHES:

- ☒ Individual
☐ Bed

TRENCH WIDTH (IN.):


- ☐ 12 in. or less
☐ 18 in.
☐ 24 in.
☒ 36 in.
☐ 6 ft. or less
☐ 9 ft. or less
☐ Other

WAKE COUNTY HEALTH DEPARTMENT SEPTIC TANK LAYOUT AND PERMIT

TAX MAP NO. 301 PARCEL NO. 44(s) PERMIT NO. B 25017
CONTRACTOR Keenan-Rogland Contr. Co. (Trent Rogland)
OWNER _____ DATE 11-3-82
LOCATION 8522 Kempton Rd.
S. R. NO. 1829
SUBDIVISION NAME Leplechase LOT NO. 22 SECTION OR BLOCK NO. _____

REPAIR ☐ ORIGINAL PERMIT NO. _____
GARBAGE DISPOSAL UNIT YES ☐ NO ☒
HOUSE ☒ MOBILE HOME ☐ BUSINESS ☐
NO. BEDROOMS 3 LOT AREA 40,000 ~~sq.~~
SIZE OF TANK 1000 gal.
NITRIFICATION LINE 2(167x3) 1000 sq. ft.
DEPTH OF STONE IN LINES: 12" ☒ 18" ☐
RISER AND BAFFLE REQUIRED ☒ PUMP REQUIRED ☐
WATER SUPPLY: INDIVIDUAL ☒ PUBLIC ☒ OTHER ☐
* PERMIT VOID 36 MONTHS FROM DATE OF ISSUANCE
* PERMIT VOID IF NOT IN COMPLIANCE WITH ZONING REGULATIONS
* PERMIT MAY BE VOIDED IF SITE ALTERATIONS MADE

LAYOUT BY Kathy Tew
2-23-83
DATE

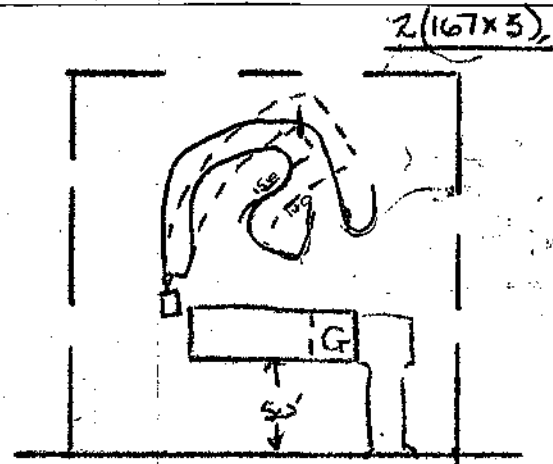

590-GP09
INSTALLED BY Junior Gully APPROVED BY Kathy Tew