

Environmental Services - Water Quality
Onsite Wastewater Scan Data Entry Form

PERMIT #: 0028709

PIN #: 1832451193

OP DATE: 0612912004

SYSTEM USE:

- ☒ House
☐ Mobile Home
☐ Business
☐ Other

SEWAGE TYPE:

- ☒ Domestic
☐ Industrial

PUMP/SIPHON?:

- ☐ Yes
☒ No

PRESSURE MANIFOLD:

- ☐ Yes
☒ No

SYSTEM TYPE:

- ☐ I
☒ II
☐ III
☐ IV
☐ V
☐ VI
☐ Other

SUB TYPE:

- ☒ A
☐ B
☐ C
☐ D
☐ E
☐ F
☐ G

NBR BEDROOMS:

- ☐ 1
☐ 2
☐ 3
☒ 4
☐ 5
☐ 6
☐ Other

MAINT. SCHEDULE:

- ☐ Yes
☒ No

CERT. OPERATOR

- ☐ Yes
☒ No

GT ST PT

- | | | |
|-------------------------------------|-------------------------------------|-------------------------------------|
| ☐ | ☐ | ☐ |
| ☐ | ☐ | ☐ |
| ☐ | ☐ | ☐ |
| ☐ | ☒ | ☐ |
| ☐ | ☐ | ☐ |
| ☐ | ☐ | ☐ |
| ☒ | ☐ | ☒ |

SIZE

- 750
900
1,000
1,200
1,500
1,800
2,100
2,500
3,000
4,000
5,000
8,000
10,000
Other
None/NA GT or PT

DRAINFIELD SIZE(SQ. FT.)

01600

DRAIN TYPE:

- ☒ Stone
☐ EZ Flow
☐ Infiltrator
☐ Biodiffuser
☐ Cultec
☐ Drip
☐ Hancor
☐ Large Dia. Pipe
☐ Multi-Pipe
☐ Other

MAX DEPTH (IN.):

- ☐ 12 in. or less
☐ 18 in. or less
☒ 24 in. or less
☐ 26 in. or less
☐ 28 in. or less
☐ 30 in. or less
☐ 32 in. or less
☐ 36 in. or less
☐ Other

STONE DEPTH (IN.):

- ☐ 8 in. or less
☒ 12 in. or less
☐ 18 in. or less
☐ 24 in. or less
☐ Other

TRENCHES:

- ☒ Individual
☐ Bed

TRENCH WIDTH (IN.):

- ☐ 12 in. or less
☐ 18 in.
☐ 24 in.
☒ 36 in.
☐ 6 ft. or less
☐ 9 ft. or less
☐ Other

WAKE COUNTY DEPARTMENT OF ENVIRONMENTAL SERVICES WELL AND SEWAGE SITE LOCATION PERMIT
NO PERMIT(S) FOR CONSTRUCTION, LOCATION OR RELOCATION ACTIVITY SHALL BE ISSUED
UNTIL AN AUTHORIZATION FOR WASTEWATER SYSTEM CONSTRUCTION HAS BEEN ISSUED

PERMIT VOID IF NOT IN COMPLIANCE WITH ZONING REGULATIONS AND/ OR IF SITE IS ALTERED OR INTENDED USE CHANGED

PERMIT#: D028709 STATUS: A APP. DATE: 11/07/2003 BLDG. PERMIT#: 0041381
PIN: 1832.01 46 3420 000 TAX MAP: 0174 0011 RECORDED: Y ORIG. PERMIT#:
TOWNSHIP: 19 WAKE FOREST JURISDICTION: WC ZONING: 40W
APPLICANT: PEEDIN FAMILY HOMES
6201 CLAMSHELL DR
WAKE FOREST, NC 27587
(919) 528 - 3153
USE: HD USE: 101 ONE-FAMILY HOUSE
EXIST USE:
DISPOSAL: BEDROOMS: 4 BASEMENT: N #EMPLOYEES: 0
SITE: ADDRESS: 8505 WINDSONGVALLEY DR
SUBDIVISION: KIMMON PLACE LOT: 61 ACRES: 0.81
DIRECTION: US1N L PURNELL R BUD SMITH R BAYNAM POND R SUNF
LOWER MEADOWS L DONLIN R WINDSONG VALLEY

Well System: WATER: COMMUNITY - TYPE: EXISTING

WELL LOG INFORMATION: DEPTH: _____ CASING DEPTH: _____ YIELD: _____ STATIC LEVEL: _____
WELLI CONTRACTOR: _____ REG.# _____ PUMP CONTRACTOR: _____ REG.# _____
Construction Compliance GROUT APPROVED ☐ DATE _____ EHS _____
WELLHEAD APPROVED ☐ DATE _____ EHS _____
SYSTEM FINALIZED ☐ DATE _____ EHS _____

COMMENTS: _____

Operation Permit

DESIGN FLOW: _____ gal./min. ACTUAL FLOW: _____ INNOVATIVE LETTER: _____

INSTALLED BY: Quality Landscaping INSTALLATION APPROVED BY: _____
PROPRIETARY SYSTEM: _____ FILTER NO: _____
COMMENTS: _____

OPERATIONS PERMIT ISSUED? Y OP DATE: 6-29-09 BY: J. Baker

This permit is based in part on information provided by the homeowner or his/her representative in the application submitted for this permit. The Environmental Health Specialist is not responsible for false or misleading information contained in the application. The Environmental Health Specialist is also not responsible for concealed conditions on the property or for statements in this report that may have resulted from false or misleading statements provided to him in the application. Neither Wake County nor the Environmental Health Specialist warrants that the septic tank system will continue to function satisfactorily in the future or that the water supply will remain potable.

As Built Information:

Date: 6-29-09 Benchmark: ST Rod reading: 4.5 Distance to Structure: _____
ST: 1200 gals ID#: 857 D.O.M.: 5304 Elev.: _____ Distance to Well: _____
PT: _____ gals ID#: _____ D.O.M.: _____ Elev.: _____
D-box/FD/PM elev.: 60 Supply Line: _____ ft. Pump/Control Panel: _____
Line 1: 7'9 _____ Date: _____
Line 2: 8'4.5 _____ Date: _____
Line 3: 9'4.75 _____ Date: _____
Line 4: 10'3.5 _____ Date: _____
Line 5: _____ Date: _____
Distance to P/L: _____ Notes: _____

WAKE COUNTY DEPARTMENT OF ENVIRONMENTAL SERVICES WELL AND SEWAGE SITE LOCATION PERMIT

NO PERMIT(S) FOR CONSTRUCTION, LOCATION OR RELOCATION ACTIVITY SHALL BE ISSUED

UNTIL AN AUTHORIZATION FOR WASTEWATER SYSTEM CONSTRUCTION HAS BEEN ISSUED

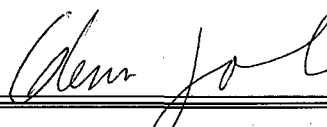
PERMIT VOID IF NOT IN COMPLIANCE WITH ZONING REGULATIONS AND/ OR IF SITE IS ALTERED OR INTENDED USE CHANGED

PERMIT#: D028709 STATUS: A APP. DATE: 11/07/2003 BLDG. PERMIT#: 0041381
PIN: 1832.01 46 3420 000 TAX MAP: 0174 0011 RECORDED: Y ORIG. PERMIT#:
TOWNSHIP: 19 WAKE FOREST JURISDICTION: WC ZONING: 40W
APPLICANT: PEEDIN FAMILY HOMES
6201 CLAMSHELL DR
WAKE FOREST, NC 27587
(919) 528 - 3153
USE: HD USE: 101 ONE-FAMILY HOUSE
EXIST USE:
DISPOSAL: BEDROOMS: 4 BASEMENT: N #EMPLOYEES: 0 FOUND DRAIN: N
SITE: ADDRESS: 8505 WINDSONG VALLEY DR
SUBDIVISION: KIMMON PLACE LOT: 61 ACRES: 0.81
DIRECTION: US1N L PURNELL R BUD SMITH R BAYNAM POND R SUNF
LOWER MEADOWS L DONLIN R WINDSONG VALLEY

IMPROVEMENT PERMIT

TANK SIZE: 1200 gal. PUMP Tank: _____ gal. SQ FT: 1600 STONE DEPTH: 12 in. MAX DEPTH LINE: 24 in.
WASTEWATER: INDIVIDUAL SEWAGE: DOMESTIC TYPE SYSTEM: II A PUMP: N P/M: N
DAILY FLOW: 480 gal/day DESIGN FEE REQ?: PAID?: WATER: COMMUNITY

COMMENTS:

IP ISSUED? Y DATE: 12/05/2003 BY: (EGJ)  PHONE#: 856-7413

AUTHORIZATION FOR WASTEWATER/WATER SYSTEM CONSTRUCTION

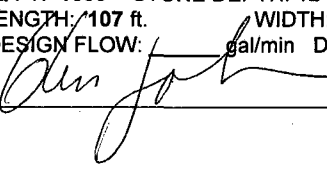
VOID SIXTY (60) MONTHS FROM DATE OF ISSUANCE

AUTHORIZATION CONDITIONS:

Contractors shall install system on contours, see attached site plan for wastewater system design and well location. No underground utilities, water lines or sprinkler systems may be located in the original system or repair areas. A septic tank filter with a riser for access is required. The wastewater system shall not be covered or placed into use until inspected by the Wake County Department of Environmental Services and an Operation Permit issued. **OTHER CONDITIONS:**

MAINTAIN ALL REGULATORY SETBACKS, NO GRADING, FILL, UTILITIES, STRUCTURES, DECKS, PATIOS OR OTHER DISTURBANCE TO DESIGNATED SEPTIC AREAS. * SCARIFY TRENCH SIDEWALLS BEFORE PLACING STONE IN TRENCHES**

TANK SIZE: 1200 gal. PUMP TANK: _____ gal. SQ FT: 1600 STONE DEPTH: 12 in. MAX DEPTH LINE: 24 in.
MAINT: N OPER: N L/O: Y TRENCH#: 5 LENGTH: 107 ft. WIDTH: 36 in. DESIGNER: _____
SUBFIELDS: _____ DESIGN HEAD PRESSURE: _____ DESIGN FLOW: _____ gal/min DOSE VOLUME: _____ gal.

CA ISSUED? Y DATE: 01/16/2004 BY: (EGJ)  PHONE#: 856-7413

LOT 61, KIMMON PLACE SUBDIVISION, PH. 4

8505 WINDSONG VALLEY DRIVE

REF: B.M. 2003, PAGE 1777

WAKE FOREST TOWNSHIP

WAKE COUNTY, NORTH CAROLINA

OCTOBER 13, 2003

ZONED R-40W

I certify that the location of structure(s) are accurately plotted on this plan. I hereby grant permission to the Representative of the Municipality to conduct inspections upon this property.

Signature of Owner or Authorized Agent

AS
BUILT

Zoning 40W By Set

Approve ✓ Date 12/1/03 SCALE 1"=50'

Revise ✓ Use 101

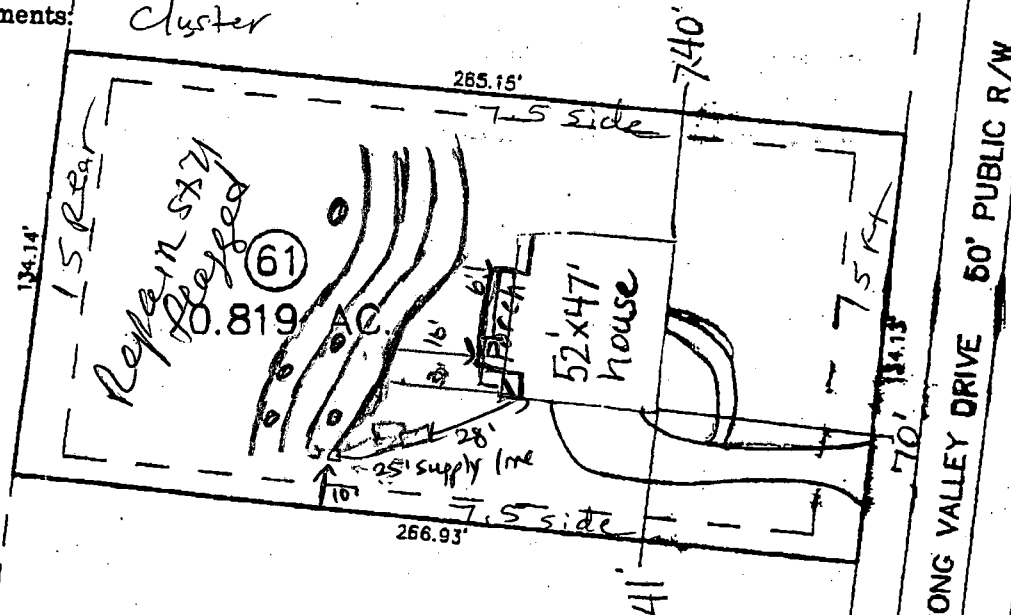
Reject MBL

PERMANENT OPEN SPACE 15 Rear 15

Side 7.5 Corner

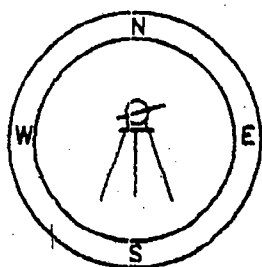
Comments: Cluster

(60) 0041381
1728709



(62)
pin# 18320146 3420
Revised Site Plan
permit 0041381
D#28709

THIS SURVEYOR DOES NOT WARRANTY THE ACCURACY OF ARCHITECTURAL DIMENSIONS. THEY ARE TO BE VERIFIED BY THE CONTRACTOR.



CAWTHORNE, MOSS & PANCIERA, P.C.

Professional Land Surveyors

239 E. Owen Ave.
Post Office Box 1253
Wake Forest, N.C. 27588
(919)556-3148

NOTES:

-THIS PLAN DOES NOT REFLECT AN ACTUAL SURVEY. IT IS A PRELIMINARY PLAN AND SHOULD BE USED FOR ITS INTENDED PURPOSE ONLY.
-NOT FOR RECORDATION, CONVEYANCES, OR SALES.

Imp Surface Tab

House 2118
Driveway 1320
walks 80

Total Imp Area
3518

Total Lot Area
35,676

9.86%

PRELIMINARY PLOT PLAN FOR

NORTHWIND PROPERTIES

C.A.

LINE Elevation

1 2.45' 107'

2 3.2' 107'

3 4.25' 107'

4 5.15' 107'

5 6.15' 107'

6 6.9' 110'

7 8.65' 50'

8 10.15' 50'

9 11.3' 100'

10 11.9' 100'

Innov. Retain

LOT 81, KIMMON PLACE SUBDIVISION, PH. 4

8505 WINDSONG VALLEY DRIVE PIN: 183201463420

REF: B.M. 2003, PAGE 1777

WAKE FOREST TOWNSHIP

WAKE COUNTY, NORTH CAROLINA

OCTOBER 13, 2003

ZONED R-40W

I certify that the location of planned or existing structure(s) are accurately shown. I understand failure to locate structures in accordance with this plot plan may require the relocation of structure(s) regardless degree of completion. I hereby grant permission to Municipal/County Representatives the right of entry to make evaluations or inspections upon this property.

Signature of Owner or Authorized Agent

50 25 0 50 100

SCALE 1"=50'

Zoning 40W By JIL

Approve Date 11.7.03

Revise Use 101 (60)

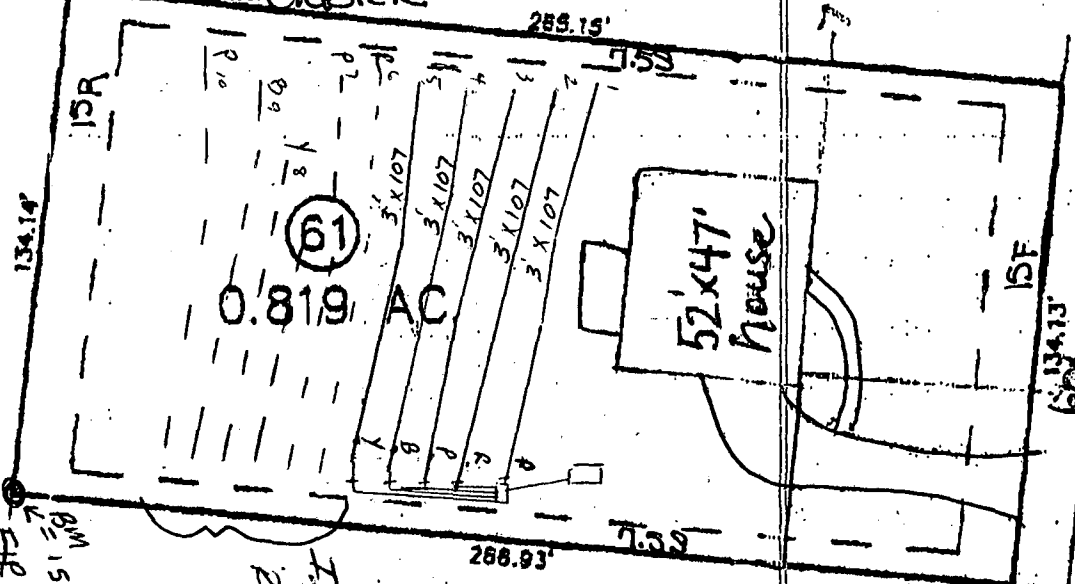
Reject MBL

Front 15 Rear 15

Side 7.5 Corner

Comments: CLUSTER

PERMANENT OPEN SPACE

0041381
D28709

Imp Surface Table
House Under roof
Drive
Walks

(62)

2118#

1220#

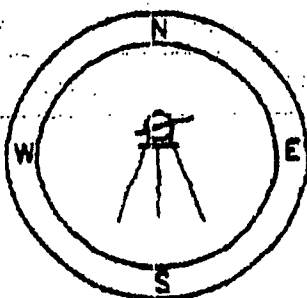
80#

Total Imp Area 3418#

Total Lot Area 35,676 SF

Percent Imp Area 9.58%

THIS SURVEYOR DOES NOT
WARRANT THE ACCURACY
OF ARCHITECTURAL DIMENSIONS.
THEY ARE TO BE VERIFIED BY
THE CONTRACTOR.

CAWTHORNE, MOSS
& PANCIRA, P.C.

Professional Land Surveyors

239 E. Owen Ave.
Post Office Box 1253
Wake Forest, N.C. 27588
(919)556-3148

NOTES:

- THIS PLAN DOES NOT REFLECT AN
ACTUAL SURVEY. IT IS A PRELIMINARY
PLAN AND SHOULD BE USED FOR ITS
INTENDED PURPOSE ONLY.
NOT FOR RECORDATION, CONVEYANCES,
SALES.