

Environmental Services - Water Quality
Onsite Wastewater Scan Data Entry Form

PERMIT #: D013667

PIN #: 0647907067

OP DATE: 0811311999

SYSTEM USE:

- ☒ House
☐ Mobile Home
☐ Business
☐ Other

SEWAGE TYPE:

- ☒ Domestic
☐ Industrial

PUMP/SIPHON?:

- ☐ Yes
☒ No

PRESSURE MANIFOLD:

- ☐ Yes
☒ No

SYSTEM TYPE:

- ☐ I
☒ II
☐ III
☐ IV
☐ V
☐ VI
☐ Other

SUB TYPE:

- ☒ A
☐ B
☐ C
☐ D
☐ E
☐ F
☐ G

NBR BEDROOMS:

- ☐ 1
☐ 2
☒ 3
☐ 4
☐ 5
☐ 6
☐ Other

MAINT. SCHEDULE:

- ☐ Yes
☒ No

CERT. OPERATOR

- ☐ Yes
☒ No

GT ST PT

- | | | |
|-------------------------------------|-------------------------------------|-------------------------------------|
| ☐ | ☐ | ☐ |
| ☐ | ☐ | ☐ |
| ☐ | ☒ | ☐ |
| ☐ | ☐ | ☐ |
| ☐ | ☐ | ☐ |
| ☒ | ☐ | ☒ |

SIZE

- 750
900
1,000
1,200
1,500
1,800
2,100
2,500
3,000
4,000
5,000
8,000
10,000
Other
None/NA GT or PT

DRAINFIELD SIZE(SQ. FT.)

00720

DRAIN TYPE:

- ☒ Stone
☐ EZ Flow
☐ Infiltrator
☐ Biodiffuser
☐ Cultec
☐ Drip
☐ Hancor
☐ Large Dia. Pipe
☐ Multi-Pipe
☐ Other

MAX DEPTH (IN.):

- ☐ 12 in. or less
☐ 18 in. or less
☐ 24 in. or less
☐ 26 in. or less
☐ 28 in. or less
☒ 30 in. or less
☐ 32 in. or less
☐ 36 in. or less
☐ Other

STONE DEPTH (IN.):

- ☐ 8 in. or less
☒ 12 in. or less
☐ 18 in. or less
☐ 24 in. or less
☐ Other

TRENCHES:

- ☒ Individual
☐ Bed

TRENCH WIDTH (IN.):

- ☐ 12 in. or less
☐ 18 in.
☐ 24 in.
☒ 36 in.
☐ 6 ft. or less
☐ 9 ft. or less
☐ Other

CH

WAKE COUNTY ENVIRONMENTAL HEALTH WELL AND SEWAGE SITE LOCATION PERMIT

NO PERMIT(S) FOR CONSTRUCTION, LOCATION OR RELOCATION ACTIVITY SHALL BE ISSUED
UNTIL AN AUTHORIZATION FOR WASTEWATER SYSTEM CONSTRUCTION HAS BEEN ISSUED

PERMIT VOID IF NOT IN COMPLIANCE WITH ZONING REGULATIONS AND/ OR IF SITE IS ALTERED OR INTENDED USE CHANGED

PERMIT#: D013667 STATUS: A APP DATE: 03/08/1999 BLDG PERMIT#: 0993185
APPLICANT: WALL, DANIEL DAY PHONE: (919) 552 - 1379
ADDRESS: 367 SHERMAN LAKE DR FAX#: (999) 999 - 9999
CITY: FUQUAY STATE: NC ZIP: 27526
OWNER: AKINS, ANNA R DAY PHONE: (999) 999 - 9999
ADDRESS: P O BOX 266 FAX#: (999) 999 - 9999
CITY: FUQUAY VARINA STATE: NC ZIP: 27526
HD USE CD: 101 ONE-FAMILY HOUSE ORIG PERMIT#: REC?: Y
EXIST USE: TAX MAP#: 0836 0011
BEDROOMS: 3 BSMT: N #EMPLOYEES: 0 WATER: I WASTEWATER: I GARB DISPOS: N
TOWNSHIP: 12 MIDDLE CREEK JURIS: WC ZON: R30 PIN: 0647.04 90-9606 000 7067
SUBD#: S 000 000 00 SUBD NAME: PRESCOTT DOWNS LOT-SEC: 84 ACRE: 1.45
IMPRV PRMT: ISSUED?: Y DATE: 04/05/1999 BY: WEL TYPE SYSTEM: II PUMP:
CNSTR AUTH: ISSUED?: Y DATE: 04/05/1999 BY: WEL MAINT: N OPER: N
RECEIPT#: 0039576 FEE: 290.00 OP DATE: BY:
WATR SAMPL: REQ?: Y APPROVED?: DATE: PROPRIETARY SYS:
ST#: 6704 MI: DIR: NAME: WAVCOTT DIR: TYP: DR
DIRECTIONS: GO 401 S-TO FUQUAY-RIGHT HWY 42-RIGHT PINEY
GROVE WILBON RD-4 MILE ON RIGHT

IMPROVEMENT PERMIT

SIZE OF TANK 1000 ST PT GALS. TOTAL SQ. FT. 720 DEPTH OF STONE 12 IN. MAX. DEPTH LINE 24-30 IN.

WASTEWATER: DOMESTIC ☒ INDUSTRIAL ☐

I.P. ISSUED BY

Ernette Lynn, R.S.

AUTHORIZATION FOR WASTEWATER SYSTEM CONSTRUCTION

VOID SIXTY (60) MONTHS FROM DATE OF ISSUANCE

AUTHORIZATION CONDITIONS

Contractor To Follow Contours, See Attached Site Plan For Wastewater System Design And Well Location. The wastewater system shall not be covered or placed into use until inspected by the Wake County Environmental Health Division and an Operation Permit issued.

OTHER CONDITIONS: Septic tank must have two access risers and approved effluent filter. Establish and install lines on contour.

SIZE OF TANK 1000 ST PT GALS. TOTAL SQ. FT. 720 DEPTH OF STONE 12 IN. MAX. DEPTH LINE 24-30 IN.

ST FILTER REQUIRED ☒ NUMBER OF TRENCHES 2 LENGTH OF TRENCHES 120 FT. WIDTH OF TRENCHES 3 FT.

C.A. ISSUED BY Ernette Lynn, R.S. INSTALLED BY Jason Matthews CTR. I.D. #

SEPTIC TANK FILTER USED

INNOV. APPL. #: IWWS- DATE 08/13/99 INSTALLATION APPROVED BY John Baker

WELL SYSTEM = PRIVATE ☒ SEMI-PUBLIC ☐ NEW ☒ REPLACEMENT ☐ EXISTING ☐

WELL LOG INFORMATION = DEPTH 190' CASING DEPTH 76' YIELD 25' STATIC LEVEL 20'

WELL CONTRACTOR W.W. 7006 REG.# 4 PUMP CONTRACTOR W.W. 7006 REG.# 846

CONSTRUCTION COMPLIANCE = GROUT APPROVED ☒ DATE 4/14/99 EHS

WCHD ID # 8819 WELLHEAD APPROVED ☒ DATE 5/6/99 EHS

NEGATIVE BACTERIOLOGICAL RESULTS ☒ DATE 7/12/99 EHS

SYSTEM FINALIZED ☒ DATE 7/12/99 EHS

COMMENTS:


This permit is based in part on information provided by the homeowner or his/her representative in the application submitted for this permit. The Environmental Health Specialist is not responsible for false or misleading information contained in the application. The Environmental Health Specialist is also not responsible for concealed conditions on the property or for statements in this report that may have resulted from false or misleading statements provided to him in the application. Neither Wake County nor the Environmental Health Specialist warrants that the septic tank system will continue to function satisfactorily in the future or that the water supply will remain potable.

1B-375 103
Installed 7/2
to Layout

IP & CA

Scale 1" = 100'

Daniel L. Wall
Lot # 84
Prescott Downs

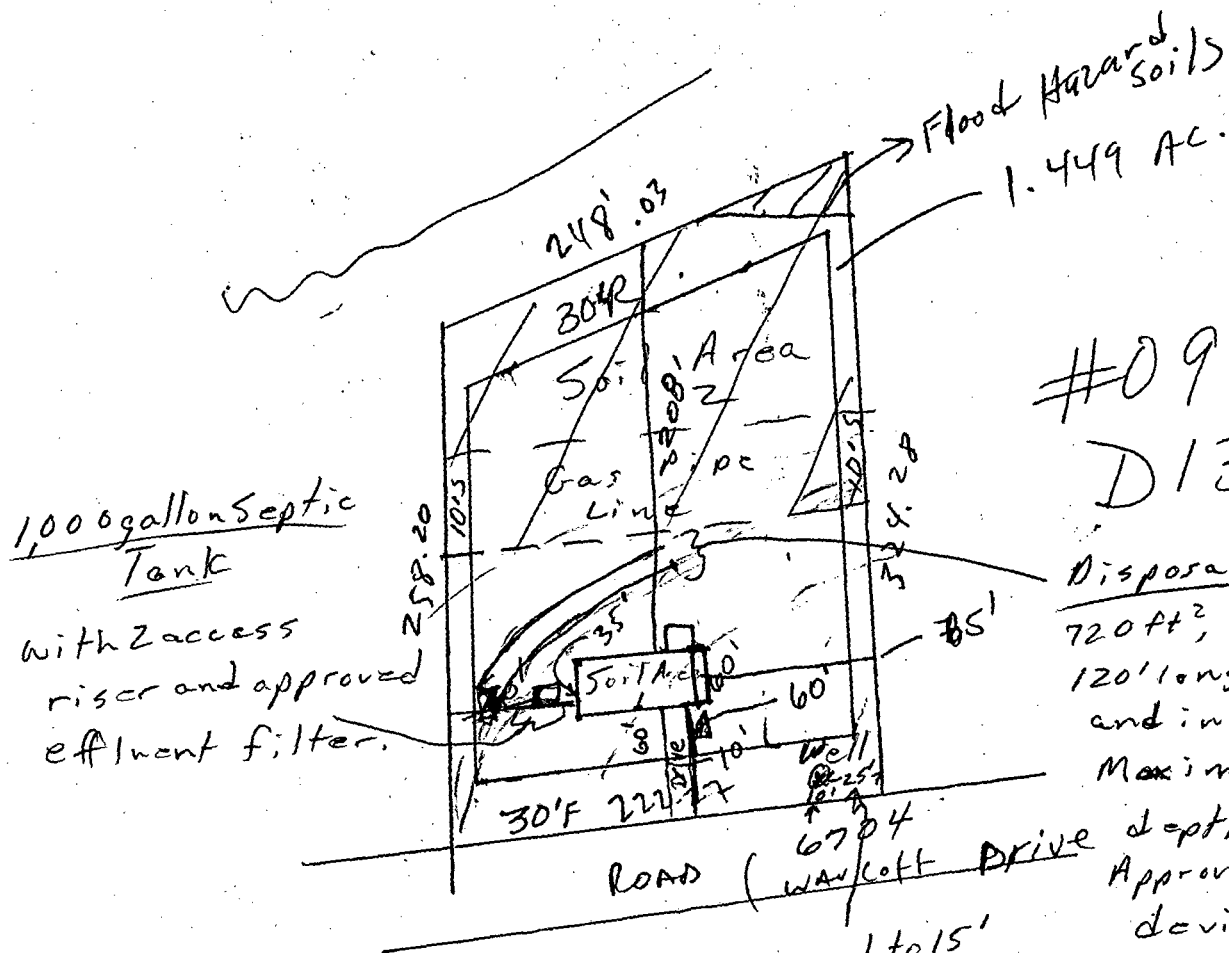

#0993185
D13667

Disposal Field

720 ft², 21 lines - 3' wide x
120' long, establish
and install on contour,
Maximum trench
depth 24-30 inches.
Approved distribution
device.

Changed to 15' d
(Conveyed to
Pool & Well Drilling 4/13/99)
R =

PIN# 0647.04 90 690 6

I certify that the location of this structure is accurately shown. Failure to locate this structure in accordance with this plot plan could require relocation of the structure regardless of its degree of completion:

Signature _____ Date 3/8/99
Check one ☒ Owner ☐ Builder/Contractor ☐ Other

Zoning R-30 By Challant
 Approve ✓ Date 3-8-99
 Revise _____ Use 101
 Reject _____ MBL _____
 Front 30 Rear 20
 Side 10 Corner _____

Side _____ Corner _____

Comments: flood cert exempted
over 200' from proposed
structure

INSPECTIONS &
LAND USE DIVISION

DATE 03/03/1999 MON

#99318	
HOT-ADD NO.	075318
0050636-0921	\$290.00
117200-01009	\$74.00
TOTAL	\$314.00
CHECK	\$314.00
000000000000	NOI
TIME 15:52	NO. 039576

WELL CONSTRUCTION RECORD

DRILLING CONTRACTOR: _____

DRILLER REGISTRATION #: _____

STATE WELL CONSTRUCTION PERMIT#: _____

1. WELL USE (Check Applicable Box): Residential ☒ Municipal ☐ Industrial ☐ Agricultural ☐ Monitoring ☐
Recovery ☐ Heat Pump Water Injection ☐ Other ☐ If Other, List Use: _____

2. WELL LOCATION: (Show sketch of the location below)

Nearest Town: Haywood County: _____

(Road, Community, or Subdivision and Lot No.)

3. OWNER Daniel Wall

ADDRESS Lot 86

(Street or Route No.)

City or Town

State

Zip Code

4. DATE DRILLED 4-14-99

5. TOTAL DEPTH 190

6. CUTTINGS COLLECTED YES ☐ NO ☒

7. DOES WELL REPLACE EXISTING WELL? YES ☐ NO ☒

8. STATIC WATER LEVEL Below Top of Casing: 70 FT.

(Use "+" if Above Top of Casing)

9. TOP OF CASING IS 1.5 FT. Above Land Surface*

* Casing Terminated at/or below land surface is illegal unless a variance is issued in accordance with 15A NCAC 2C .0118

10. YIELD (gpm): 25 METHOD OF TEST B610

11. WATER ZONES (depth): 125' 36 gpm

165' 22 gpm

12. CHLORINATION: Type _____ Amount _____

13. CASING:

If additional space is needed use back of form

LOCATION SKETCH

(Show direction and distance from at least two State Roads, or other map reference points)

From	Depth	To	Diameter	Wall Thickness or Weight/Ft.	Material
0	710'	Ft.	6 1/4	KE	60K
From	To	Ft.			
From	To	Ft.			

14. GROUT:

From	Depth	To	Material	Method
0	20'	Ft.	1/2 inch sand	
From	To	Ft.		


15. SCREEN:

From	Depth	To	Diameter	Slot Size	Material
		Ft.		in.	
From	To	Ft.		in.	
From	To	Ft.		in.	

16. SAND/GRAVEL PACK:

From	Depth	To	Size	Material
		Ft.		
From	To	Ft.		

17. REMARKS:

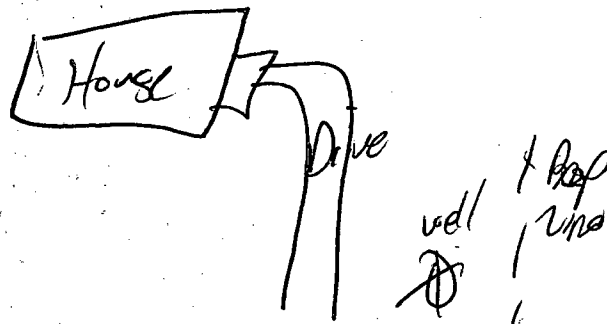

I DO HEREBY CERTIFY THAT THIS WELL WAS CONSTRUCTED IN ACCORDANCE WITH 15A NCAC 2C, WELL CONSTRUCTION STANDARDS, AND THAT A COPY OF THIS RECORD HAS BEEN PROVIDED TO THE WELL OWNER.

FOR OFFICE USE ONLY

Quad No: _____
Serial No: _____

SIGNATURE OF CONTRACTOR OR AGENT

Submit original to Division of Water Quality and copy to well owner.

DATE