

Environmental Services - Water Quality
Onsite Wastewater Scan Data Entry Form

PERMIT #: D008428

PIN #: 0770831699

OP DATE: 0512711998

SYSTEM USE:

- ☒ House
☐ Mobile Home
☐ Business
☐ Other

SEWAGE TYPE:

- ☒ Domestic
☐ Industrial

PUMP/SIPHON?:

- ☐ Yes
☒ No

PRESSURE MANIFOLD:

- ☐ Yes
☒ No

SYSTEM TYPE:

- ☐ I
☒ II
☐ III
☐ IV
☐ V
☐ VI
☐ Other

SUB TYPE:

- ☒ A
☐ B
☐ C
☐ D
☐ E
☐ F
☐ G

NBR BEDROOMS:

- ☐ 1
☐ 2
☒ 3
☐ 4
☐ 5
☐ 6
☐ Other

MAINT. SCHEDULE:

- ☐ Yes
☒ No

CERT. OPERATOR

- ☐ Yes
☒ No

GT ST PT SIZE

- | | | | |
|-------------------------------------|-------------------------------------|-------------------------------------|------------------|
| ☐ | ☐ | | 750 |
| ☐ | ☐ | ☐ | 900 |
| ☐ | ☒ | ☐ | 1,000 |
| ☐ | ☐ | ☐ | 1,200 |
| ☐ | ☐ | ☐ | 1,500 |
| ☐ | ☐ | ☐ | 1,800 |
| ☐ | ☐ | ☐ | 2,100 |
| ☐ | ☐ | ☐ | 2,500 |
| ☐ | ☐ | ☐ | 3,000 |
| ☐ | ☐ | ☐ | 4,000 |
| ☐ | ☐ | ☐ | 5,000 |
| ☐ | ☐ | ☐ | 8,000 |
| ☐ | ☐ | ☐ | 10,000 |
| ☐ | ☐ | ☐ | Other |
| ☒ | | ☒ | None/NA GT or PT |

DRAINFIELD SIZE(SQ. FT.)

01030

DRAIN TYPE:

- ☒ Stone
☐ EZ Flow
☐ Infiltrator
☐ Biodiffuser
☐ Cultec
☐ Drip
☐ Hancor
☐ Large Dia. Pipe
☐ Multi-Pipe
☐ Other

MAX DEPTH (IN.):

- ☐ 12 in. or less
☐ 18 in. or less
☒ 24 in. or less
☐ 26 in. or less
☐ 28 in. or less
☐ 30 in. or less
☐ 32 in. or less
☐ 36 in. or less
☐ Other

STONE DEPTH (IN.):

- ☐ 8 in. or less
☒ 12 in. or less
☐ 18 in. or less
☐ 24 in. or less
☐ Other

TRENCHES:

- ☒ Individual
☐ Bed

TRENCH WIDTH (IN.):

- ☐ 12 in. or less
☐ 18 in.
☐ 24 in.
☒ 36 in.
☐ 6 ft. or less
☐ 9 ft. or less
☐ Other

CH

WAKE COUNTY ENVIRONMENTAL HEALTH WELL AND SEWAGE SITE LOCATION PERMIT

NO PERMIT(S) FOR CONSTRUCTION, LOCATION OR RELOCATION ACTIVITY SHALL BE ISSUED

UNTIL AN AUTHORIZATION FOR WASTEWATER SYSTEM CONSTRUCTION HAS BEEN ISSUED

PERMIT VOID IF NOT IN COMPLIANCE WITH ZONING REGULATIONS AND/OR IF SITE IS ALTERED OR INTENDED USE CHANGED

PERMIT#: D008428 STATUS: A APP DATE: 11/21/1997 BLDG PERMIT#: 0981727
APPLICANT: ANDERSON, BILLY E DAY PHONE: (919) 552 - 6914
ADDRESS: 111 S MAIN ST FAX#: (999) 999 - 9999
CITY: FUQUAY VARINA STATE: NC ZIP: 27526
OWNER: H M ENTERPRISES WHITEHARD DAY PHONE: (999) 999 - 9999
ADDRESS: 5821 HOLLY SPRING RD FAX#: (999) 999 - 9999
CITY: RALEIGH STATE: NC ZIP: 27606
HD USE CD: 101 ONE-FAMILY HOUSE ORIG PERMIT#: REC?: Y
EXIST USE: TAX MAP#: 0721 0010
BEDROOMS: 3 BSMT: N #EMPLOYEES: 0 WATER: C WASTEWATER: I GARB DISPOS: N
TOWNSHIP: 18 SWIFT CREEK JURIS: WC ZON: R30 PIN: 0770.04 73-6554 000 83 1699
SUBD#: S 000 000 00 SUBD NAME: WHITEHART LOT-SEC: 43 ACRE: 0.73
IMPRV PRMT: ISSUED?: Y DATE: 12/18/1997 BY: SFM TYPE SYSTEM: II PUMP:
CNSTR AUTH: ISSUED?: Y DATE: 12/18/1997 BY: SFM DATE EXPIRED: 12/18/2002
RECEIPT#: FEE: OP DATE: BY:
WATR SAMPL: REQ?: APPROVED?: DATE: PROPRIETARY SYS:
ST#: 2900 MI: DIR: NAME: WHITEHART DIR: TYP: LANE
DIRECTIONS: 401S R 1010 R 1386 1ST R INTO SUB

IMPROVEMENT PERMIT

SIZE OF TANK 1000 ST PT GALS. TOTAL SQ. FT. 1030 DEPTH OF STONE 12 IN. MAX. DEPTH LINE 24 IN.

WASTEWATER: DOMESTIC ☒ INDUSTRIAL ☐

I.P. ISSUED BY

Steve Meyer

AUTHORIZATION FOR WASTEWATER SYSTEM CONSTRUCTION

VOID SIXTY (60) MONTHS FROM DATE OF ISSUANCE

AUTHORIZATION CONDITIONS

Contractor To Follow Contours, See Attached Site Plan For Wastewater System Design And Well Location. The wastewater system shall not be covered or placed into use until inspected by the Wake County Environmental Health Division and an Operation Permit issued.

OTHER CONDITIONS: _____

SIZE OF TANK 1000 ST PT GALS. TOTAL SQ. FT. 1030 DEPTH OF STONE 12 IN. MAX. DEPTH LINE 24 IN.
NUMBER OF TRENCHES 3 LENGTH OF TRENCHES 115 FT. WIDTH OF TRENCHES 3 FT.

C.A. ISSUED BY *Steve Meyer* INSTALLED BY *Johnny Jones* CTR. I.D. # _____

INNOV. APPRL. #: IWWS-_____ DATE 5/27/98 INSTALLATION APPROVED BY *Steve Meyer, R.S.*

WELL SYSTEM = PRIVATE ☐ SEMI-PUBLIC ☐ //// NEW ☐ REPLACEMENT ☐ EXISTING ☐

WELL LOG INFORMATION = DEPTH _____ CASING DEPTH _____ YIELD _____ STATIC LEVEL _____
WELL CONTRACTOR _____ REG.# _____ PUMP CONTRACTOR _____ REG.# _____

CONSTRUCTION COMPLIANCE = GROUT APPROVED ☐ DATE _____ EHS _____
WCHD ID # _____ WELLHEAD APPROVED ☐ DATE _____ EHS _____
NEGATIVE BACTERIOLOGICAL RESULTS ☐ DATE _____ EHS _____
SYSTEM FINALIZED ☐ DATE _____ EHS _____

COMMENTS: _____

This permit is based in part on information provided by the homeowner or his/her representative in the application submitted for this permit. The Environmental Health Specialist is not responsible for false or misleading information contained in the application. The Environmental Health Specialist is also not responsible for concealed conditions on the property or for statements in this report that may have resulted from false or misleading statements provided to him in the application. Neither Wake County nor the Environmental Health Specialist warrants that the septic tank system will continue to function satisfactorily in the future or that the water supply will remain potable.

As Built

071004731554

I certify that the location of planned or existing structure(s) are accurately shown. I understand failure to locate structures in accordance with this plot plan may require the relocation of structure(s) regardless degree of completion. I hereby grant permission to Municipal/County Representatives the right of entry to make evaluations or inspections upon this property.

[Signature]
Signature of Owner or Authorized Agent

4/13/98
BTS 1000
STB 103

C65 = 46.74'


Scale
1" = 100'

1081727
DE2128

2300 Whitehart Lane

[Signature]

401 S
TR SR1010
TR SR1386 GRAHAM-Newton Rd
TR Subdivision go to end of Whitehart Lane

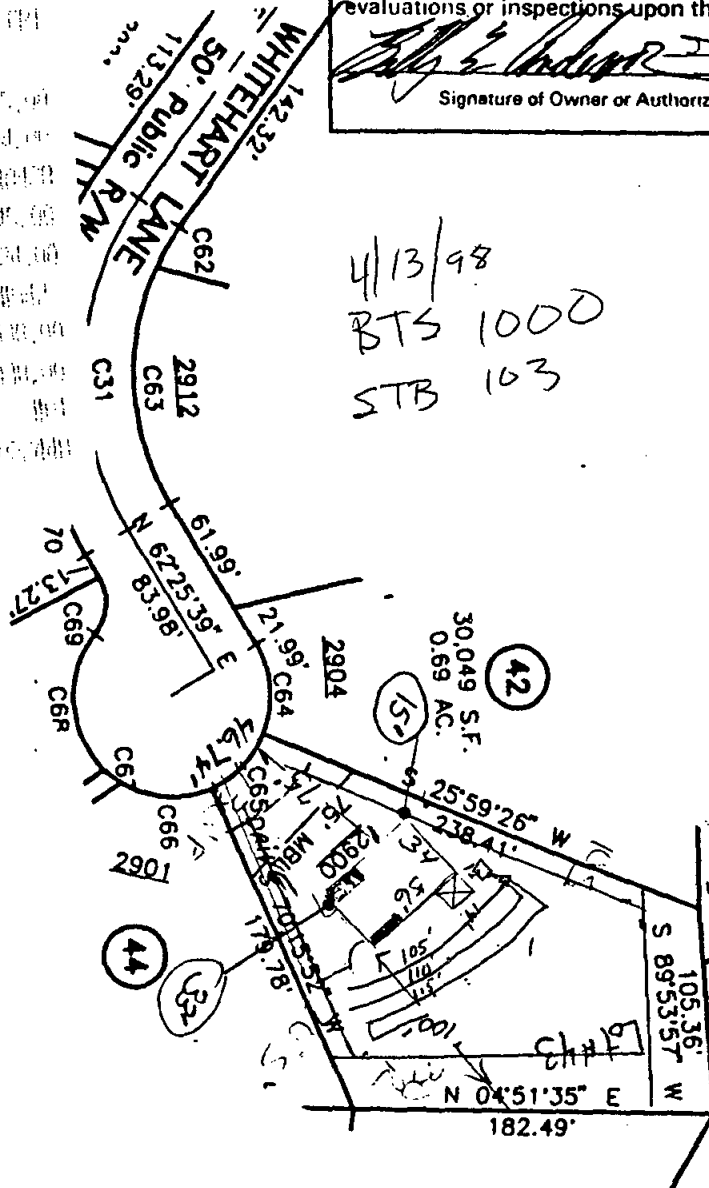

071004730554

I certify that the location of planned or existing structure(s) are accurately shown. I understand failure to locate structures in accordance with the plot plan may require the relocation of structure(s) regardless degree of completion. I hereby grant permission to Municipal/County Representatives the right of entry to make evaluations or inspections upon this property.

Billy E. Anderson
Signature of Owner or Authorized Agent


42.94 = 46.74
C65 = 592

Scale
1" = 100'

11/17/27
DENRE

27100 Whitehart Lane

Billy E. Anderson

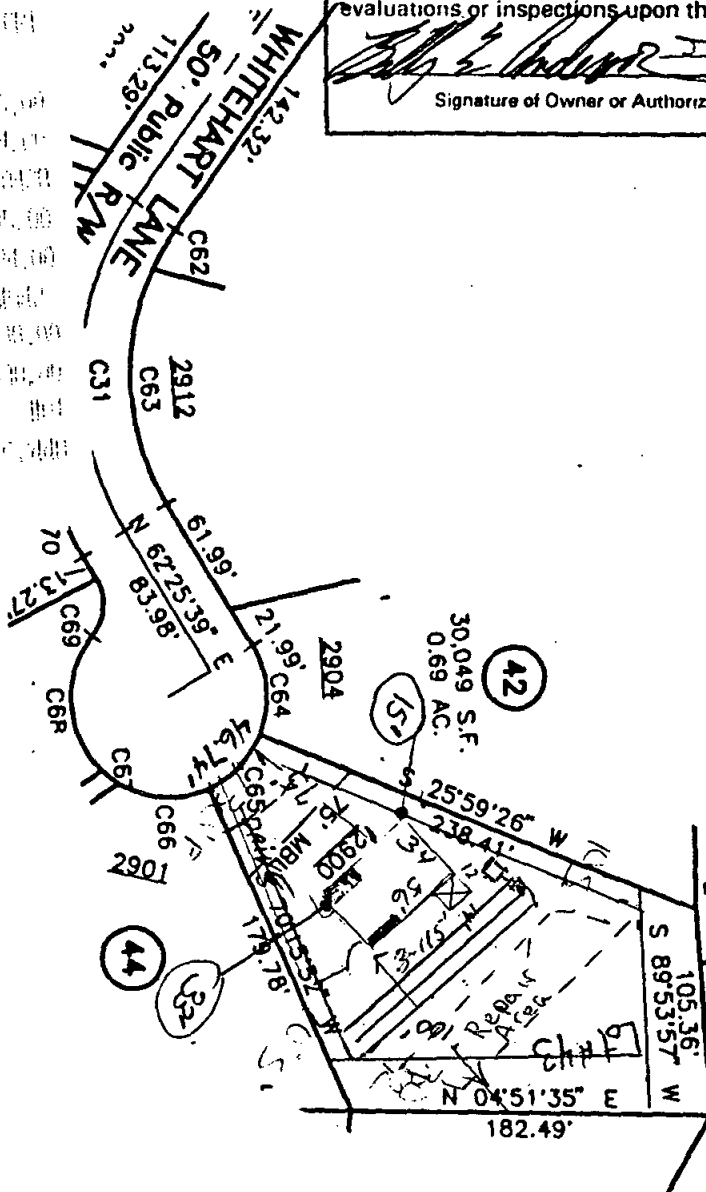

3-115' Lines

401 S
TR SR1010
TR SR1386 GRAHAM - Newton Rd
TR Subdivision go to end of Whitehart Lane