


NOTE: Make sketch of installation showing location of house, septic tanks, privies, water supplies on adjacent property, etc. Write in measurements in order that installations may be located at later date.

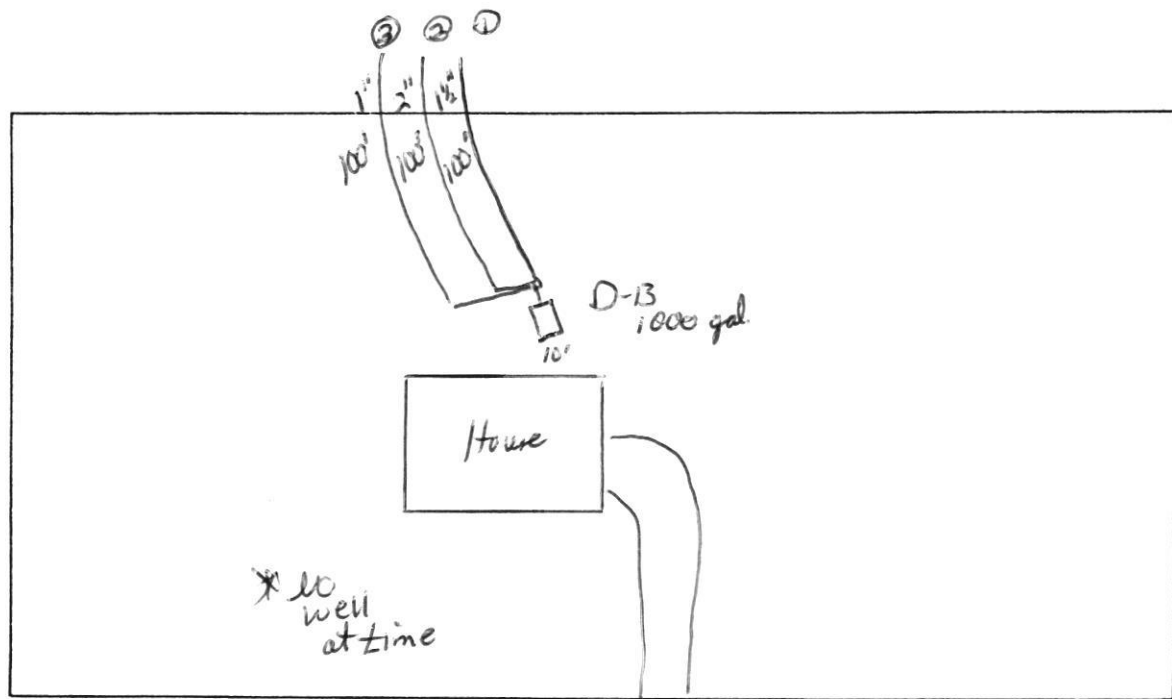

Dillon Road (Cul-D-Sac)

GRANVILLE-VANCE HEALTH DEPARTMENT—Sewage Disposal Record

Owner or Contractor Scott Salzman Date 10-17-03 S.R. No. 1711

Location/Address Dillon Lane

Subdivision/Mobile Home Park Name Wilson Place Lot Size _____

Permit No. # 3984 Lot No. 39

New System ☒ Repair _____

House ☒ Mobile Home _____ Business _____

No. Bedrooms 3 No. People _____ No. Toilets _____

Water Supply: Private ☒ Approved _____

Semi-Public _____ Unapproved _____

Public _____ None _____

Nitrification System:

Tank Size 1000 gal.

Distribution Box yes No. Lines 3

Nitrification Field 1200 Sq. Ft.

Lines: 1 2 3 4 5 6

Width 3' 3' 3' _____

Length 100' 100' 100' _____

Grade 1 1/2" 2" 1" _____

Stone Depth E Z Flow _____

Layout to be followed by installer:

** sketched on back*

Improvements Permit By Jimmy Clayton Installer Dereks' Back-hoe Service

Certificate of Completion By David Cumber Date of Inspection 2-23-04

* Construction must comply with all other applicable state and local regulations, but the permit is not a guarantee that the system will not malfunction and the Granville-Vance Health District will not be held responsible for a malfunctioning system.