

*File #: 326640 - 1
PIN #:
Tax Lot #: 13
Tax Block #:

WELL CONSTRUCTION RECORD

Owner: Claudine & Corneal V Allen

Directions

Off Lawrence Rd

WELL HEAD CONSTRUCTION

Location:

Latitude:

Longitude:

Enclosure	☒ Yes	☐ No	☐ N/A
Enclosure Floor	☐ Yes	☒ No	☐ N/A
Access Port	☐ Yes	☐ No	☒ N/A
Vent:	☒ Yes	☐ No	☐ N/A
Sample Tap	☒ Yes	☐ No	☐ N/A
Back Flow	☐ Yes	☒ No	☐ N/A
Tee (jet)	☐ Yes	☐ No	☒ N/A
Suction Line	☐ Yes	☐ No	☐ N/A
Temporary	☐ Yes	☐ No	☒ N/A
Well ID Plate	☒ Yes	☐ No	☐ N/A
Pump ID Plate	☒ Yes	☐ No	☐ N/A

EHS: Currin, Adam

Issue Date: 05/06/2021

Drilling Contractor: Southern Well Drilling LLC

Driller Registration: 3104

Date Drilled: 04/08/2021

Use of Well: SINGLE FAMILY

Total Depth: 300 Ft.

Static Water Level: 20 Ft.

Replacement Well: NO

Yield: 5 gpm

Water Zone: 1) Ft. 2) Ft.
3) Ft. 4) Ft.

Disinfection Type: GRANULAR Amount:

Casing: Depth: 120 Ft. Thickness: In. Comments:

Diameter: 6 In. Top of Casing: 12 In.

Material: PVC SCH 40

Grout:

	Depth	Material	Method
From	0 To 20 Ft.	N/A	N/A
From	0 To Ft.	N/A	N/A

* Liner Date: From 0 To Ft.

Grout:

	Depth	Material	Method
From	0 To Ft.	N/A	N/A

Issued by: Currin, Adam

Date of Issue: 05/06/2021



WF on 5-6-2021 by AWC

SEWAGE DISPOSAL SYSTEM INSTALLATION REVIEW

SEPTIC AND PUMP TANK INSPECTION

SEPTIC TANK

Manufacturer Ellis
 Date of Manufacture 1/1/21
 Stamp 518 789
 Capacity 1000
 Tee /
 Baffle /
 Sealant /
 AIR GAP /, FILTER /, RISER X

INITIAL

WIB
/
/
DATE

4/7/21
/
/
PUMP TANK

Manufacture _____
 Date of Manufacture _____
 Stamp _____
 Capacity _____
 Sealant _____
 Manhole _____
 RISER _____, SEALANT _____

MECHANICAL INSPECTION

PUMP

Manufacturer and Model # _____
 Control Panel _____
 Alarm _____
 Electrical Connection _____
 SEALANT AROUND CONDUIT _____

NITRIFICATION/DISTRIBUTION AND DRAINFIELD INSPECTION

DISTRIBUTION BOX

Level /
 Equal Distribution /
 Other _____

WIB
/
/

4/7/21
/
/

DISTRIBUTION MANIFOLD

Pipe Size /
 Gate Valves _____
 Other _____

OTHER DISTRIBUTION

Type _____

NITRIFICATION LINES

Trench Width
 Trench Length
 Trench Grade
 Stone Depth

LINE 1

3'
100'
/
20"

LINE 2

3'
100'
/
22"

LINE 3

3'
100'
/
24"

LINE 4

3'
100'
/
26"

LINE 5

LINE 6

Efflow

WELL INSPECTION

LOCATION OF WELL well is 80' from septic tank

KBS

4/9/21

COMMENTS:

N-G-EZ1203WGED

Granville – Vance District Health Department
Environmental Health

Pin _____

Permit Number 320810(5)
(CDP)

Final Sketch

Andrew Byrd
Applicants Name


Granville Ridge 13
Subdivision – Section – Lot

Physical Address: 3204 Granville Ridge Rd.

Number of Bedrooms 4


Pierce Backhoe
System Installer

4/7/21
Date

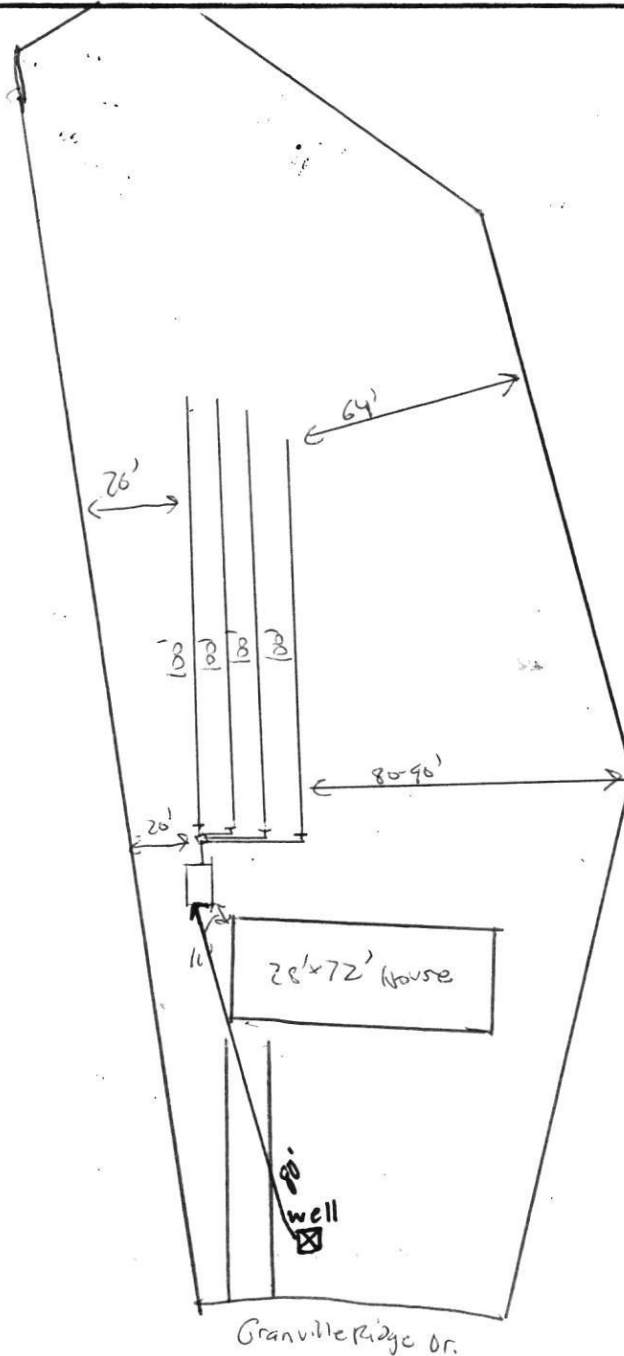

[Signature]
Authorized Signature

4/7/21
Date

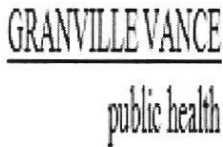

OPERATION PERMIT

Granville County Health Dept
Environmental Health
101 Hunt Drive
Oxford, NC 27565

Phone: (252) 492-5263 Fax: (252) 492-2361

For Office Use Only

*CDP File Number 320810 - 1
County ID Number: 182300099203
Evaluated For: NEW

Property Owner: Corneal V Allen & Claudine Allen

Address: 9629 Fonville Rd

Road #:

City: Wake Forest

State/Zip: NC/ 27587

Phone #: (919) 691-1123

Township:

Subdivision: Granville Ridge

Phase : NEW

Lot: 13

Structure: SINGLE FAMILY

of Bedrooms:

of People:

Water Supply: NEW WELL

Saprolite System?: ☐ Yes ☒ No

Pump Required?: ☐ Yes ☒ No

Design Flow: 480

System Classification/Description: TYPE III G. OTHER
NON-CONV. TRENCH SYSTEMS

Installer: Pearce Backhoe Service

Certification #: 4367

Specific System EZFLOW EZ 1203H-GEO

Installed:

Septic Tank Date: 01/01/2021

STB: 789

Pump Tank Date: _____

PT:

Comments: Installed new 4 bedroom system. (4) 100' lines (EZ Flow). Tank is 11' off house.

This system has been installed in compliance with applicable NC General Statutes, Rules for Sewage Treatment and Disposal, and all conditions of the Improvement Permit and Construction Authorization.

PERMIT CONDITIONS:

I. Performance: System shall perform in accordance with Rule .1961.

II. Monitoring: As required by Rule .1961.

III. Maintenance: Ground absorption sewage treatment and disposal systems shall be checked, and the contents of the septic tank removed, periodically from all compartments, to ensure proper operation of the system. The contents shall be pumped whenever the solids level is found to be more than 1/3 of the liquid depth in any compartment.

Other:

Subsurface Operator Required: ☐ Yes ☒ No

If yes, see attached sheet for additional operation conditions, maintenance and reporting.

Operation:

Other: Installed new 4 bedroom system. (4) 100' lines (EZ Flow). Tank is 11' off house.

Authorized State Agent: Bullock, Will *Will Bullock*

Date of Issue: 04/07/2021

Owner/Applicant: Corneal V Allen & Claudine Allen