

Environmental Services - Water Quality
Onsite Wastewater Scan Data Entry Form

PERMIT #: B017286

PIN #: 1776823073

OP DATE: 061111980

SYSTEM USE:

- ☒ House
☐ Mobile Home
☐ Business
☐ Other

SEWAGE TYPE:

- ☒ Domestic
☐ Industrial

PUMP/SIPHON?:

- ☐ Yes
☒ No

PRESSURE MANIFOLD:

- ☐ Yes
☒ No

SYSTEM TYPE:

- ☐ I
☒ II
☐ III
☐ IV
☐ V
☐ VI
☐ Other

SUB TYPE:

- ☒ A
☐ B
☐ C
☐ D
☐ E
☐ F
☐ G

NBR BEDROOMS:

- ☐ 1
☐ 2
☒ 3
☐ 4
☐ 5
☐ 6
☐ Other

MAINT. SCHEDULE:

- ☐ Yes
☒ No

CERT. OPERATOR

- ☐ Yes
☒ No

GT ST PT SIZE

- | | | | |
|-------------------------------------|-------------------------------------|-------------------------------------|------------------|
| ☐ | ☐ | ☐ | 750 |
| ☐ | ☒ | ☐ | 900 |
| ☐ | ☐ | ☐ | 1,000 |
| ☐ | ☐ | ☐ | 1,200 |
| ☐ | ☐ | ☐ | 1,500 |
| ☐ | ☐ | ☐ | 1,800 |
| ☐ | ☐ | ☐ | 2,100 |
| ☐ | ☐ | ☐ | 2,500 |
| ☐ | ☐ | ☐ | 3,000 |
| ☐ | ☐ | ☐ | 4,000 |
| ☐ | ☐ | ☐ | 5,000 |
| ☐ | ☐ | ☐ | 8,000 |
| ☐ | ☐ | ☐ | 10,000 |
| ☐ | ☐ | ☐ | Other |
| ☒ | | ☒ | None/NA GT or PT |

DRAINFIELD SIZE(SQ. FT.)

01002

DRAIN TYPE:

- ☒ Stone
☐ EZ Flow
☐ Infiltrator
☐ Biodiffuser
☐ Cultec
☐ Drip
☐ Hancor
☐ Large Dia. Pipe
☐ Multi-Pipe
☐ Other

MAX DEPTH (IN.):

- ☐ 12 in. or less
☐ 18 in. or less
☐ 24 in. or less
☐ 26 in. or less
☐ 28 in. or less
☐ 30 in. or less
☐ 32 in. or less
☐ 36 in. or less
☒ Other

STONE DEPTH (IN.):

- ☐ 8 in. or less
☐ 12 in. or less
☒ 18 in. or less
☐ 24 in. or less
☐ Other

TRENCHES:

- ☐ Individual
☒ Bed

TRENCH WIDTH (IN.):

- ☐ 12 in. or less
☐ 18 in.
☐ 24 in.
☐ 36 in.
☒ 6 ft. or less
☐ 9 ft. or less
☐ Other

1776 82 3023

WAKE COUNTY HEALTH DEPARTMENT SEPTIC TANK LAYOUT AND PERMIT

TAX MAP NO. 418 PARCEL NO. 121 119 PERMIT NO. 17288

CONTRACTOR RIVERCAST Builders

OWNER Go 64 E turn Left on Riley Hill Rd DATE 2/5/80

LOCATION Go 64 E turn Left on Riley Hill Rd

2320 S. R. NO. 42320

SUBDIVISION NAME PONDERRA LOT NO. 110 SECTION OR BLOCK NO. III

REPAIR ☐ ORIGINAL PERMIT NO. _____

GARBAGE DISPOSAL UNIT YES ☐ NO ☐

HOUSE ☐ MOBILE HOME ☐ BUSINESS ☐

NO. BEDROOMS 3 LOT AREA 20,000


SIZE OF TANK 1900 gal.

NITRIFICATION LINE 16 x 167 / 1002 sq. ft.

DEPTH OF STONE IN LINES: 12" ☐ 18" ☐

WATER SUPPLY: INDIVIDUAL ☐ PUBLIC ☐ OTHER ☐

- * PERMIT VOID 36 MONTHS FROM DATE OF ISSUANCE.
- * PERMIT VOID IF NOT IN COMPLIANCE WITH ZONING REGULATIONS
- * PERMIT MAY BE VOIDED IF SITE ALTERATIONS MADE

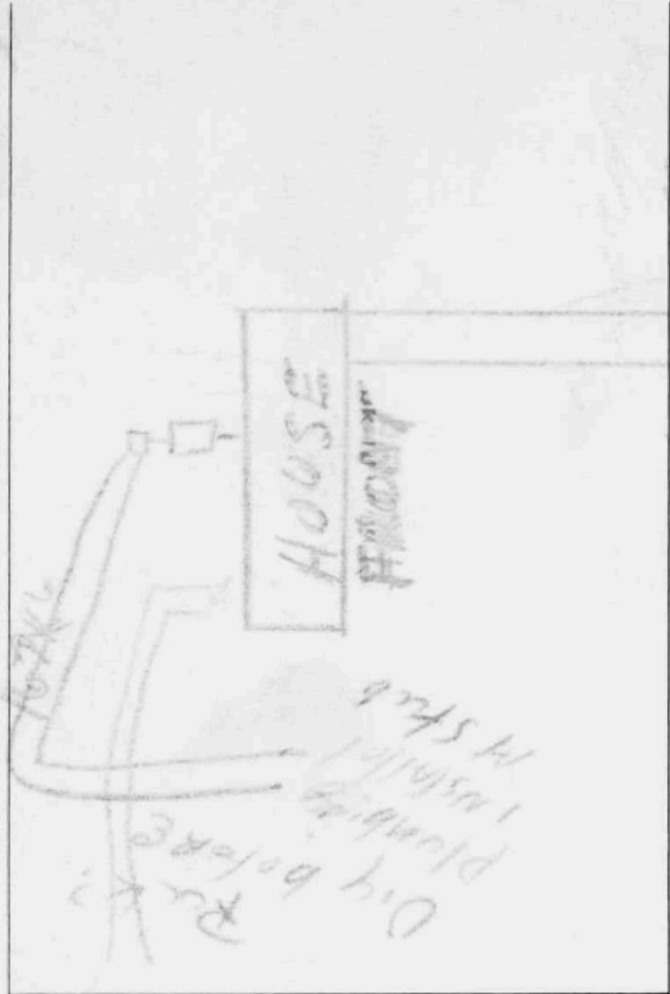

LAYOUT BY Eddie Driver

DATE 2/5/80 INSTALLED BY Eddie Driver APPROVED BY Robert Hogg