

Environmental Services - Water Quality
Onsite Wastewater Scan Data Entry Form

PERMIT #: **WA14959**

PIN #: **0770842340**

OP DATE: **11/10/2016**

SYSTEM USE:

- ☒ House
☐ Mobile Home
☐ Business
☐ Other

SEWAGE TYPE:

- ☒ Domestic
☐ Industrial

PUMP/SIPHON?:

- ☐ Yes
☒ No

PRESSURE MANIFOLD:

- ☐ Yes
☒ No

SYSTEM TYPE:

- ☐ I
☒ II
☐ III
☐ IV
☐ V
☐ VI
☐ Other

SUB TYPE:

- ☒ A
☐ B
☐ C
☐ D
☐ E
☐ F
☐ G

NBR BEDROOMS:

- ☐ 1
☐ 2
☒ 3
☐ 4
☐ 5
☐ 6
☐ Other

MAINT. SCHEDULE:

- ☐ Yes
☒ No

CERT. OPERATOR

- ☐ Yes
☒ No

GT ST PT

- | | | | |
|-------------------------------------|-------------------------------------|-------------------------------------|------------------|
| ☐ | ☐ | | 750 |
| ☐ | ☐ | ☐ | 900 |
| ☐ | ☒ | ☐ | 1,000 |
| ☐ | ☐ | ☐ | 1,200 |
| ☐ | ☐ | ☐ | 1,500 |
| ☐ | ☐ | ☐ | 1,800 |
| ☐ | ☐ | ☐ | 2,100 |
| ☐ | ☐ | ☐ | 2,500 |
| ☐ | ☐ | ☐ | 3,000 |
| ☐ | ☐ | ☐ | 4,000 |
| ☐ | ☐ | ☐ | 5,000 |
| ☐ | ☐ | ☐ | 8,000 |
| ☐ | ☐ | ☐ | 10,000 |
| ☐ | ☐ | ☐ | Other |
| ☒ | | ☒ | None/NA GT or PT |

DRAINFIELD SIZE(SQ. FT.)

01035

DRAIN TYPE:

- ☒ Stone
☐ EZ Flow
☐ Infiltrator
☐ Biodiffuser
☐ Cultec
☐ Drip
☐ Hancor
☐ Large Dia. Pipe
☐ Multi-Pipe
☐ Other

MAX DEPTH (IN.):

- ☐ 12 in. or less
☐ 18 in. or less
☒ 24 in. or less
☐ 26 in. or less
☐ 28 in. or less
☐ 30 in. or less
☐ 32 in. or less
☐ 36 in. or less
☐ Other

STONE DEPTH (IN.):



- ☐ 8 in. or less
☒ 12 in. or less
☐ 18 in. or less
☐ 24 in. or less
☐ Other

TRENCHES:

- ☒ Individual
☐ Bed

TRENCH WIDTH (IN.):

- ☐ 12 in. or less
☐ 18 in.
☐ 24 in.
☒ 36 in.
☐ 6 ft. or less
☐ 9 ft. or less
☐ Other

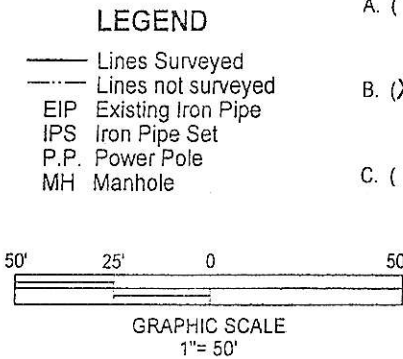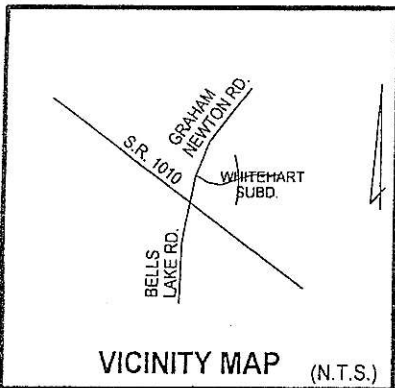

FLOOD CERTIFICATION

- A. () THE PROPERTY IS NOT LOCATED IN A COMMUNITY PARTICIPATING IN THE NATIONAL FLOOD INSURANCE PROGRAM AS OF THIS DATE.
- B. (X) THE PROPERTY IS NOT LOCATED IN THE 100 YEAR FLOOD HAZARD AREA PER F.I.R.M. MAP NO. 3720077000 J, EFFECTIVE DATE MAY 2, 2006.
- C. () A PORTION OF THIS PROPERTY IS LOCATED WITHIN A 100 YEAR FLOOD FRINGE AREA AS SHOWN BELOW.

Id Radius Arc Length Chord Ch Bear
C1 219.71' 246.46' 233.74' S 24°29'25" W

B.O.M. 1997 PG. 1646

Pin: 0770842340


I certify that the location of planned or existing structure(s) are accurately shown. I understand failure to locate structures in accordance with this plat may require the relocation of structure(s) regardless of degree of non-compliance. I hereby grant permission to Municipal/County representatives the right of entry to make evaluations or inspections upon this property.

Signature of Owner or Authorized Agent

OAKLYN SUBD.

To be removed

Site plan approved as shown for Screen Pond. Any changes to site plan voids approval. All setbacks apply for septic systems and wells, regarding any pools, decks, additions and/or accessory structures. Applicant is responsible for protecting all portions of the septic system, repair area and wells from damage during construction. Adhere to all Local and State Rules. Approved by Wake County Department of Environmental Services, Water and Waste Water Section Date 11-10-16

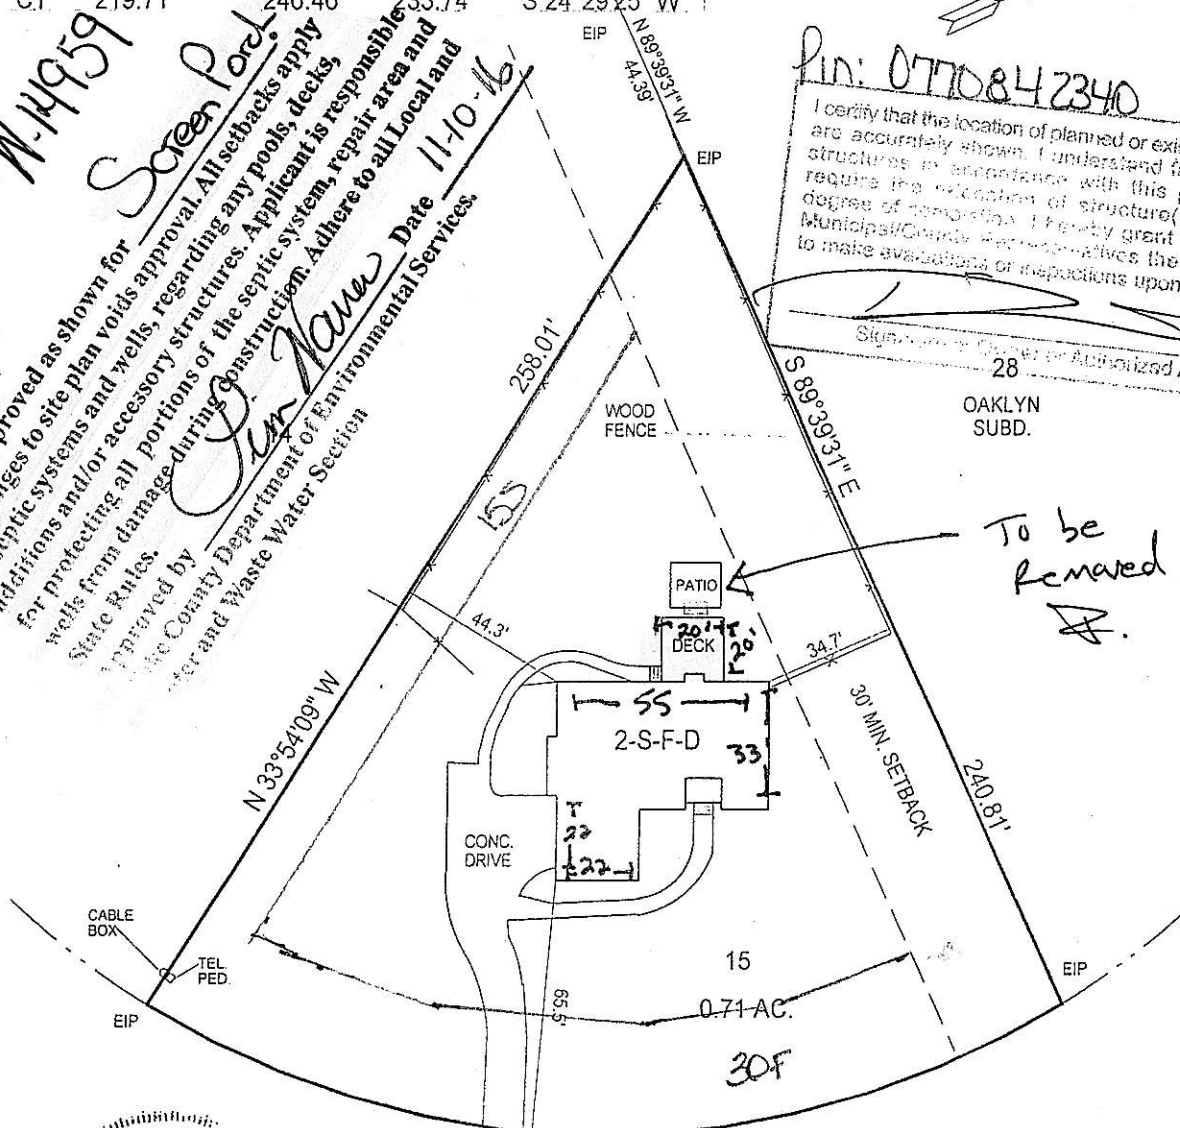

LOT 15, WHITEHART SUBD., PH. 1, RECORDED IN B.O.M. 1997, PG. 1646, WAKE CO.

3200 OAKLYN SPRINGS DR. (50' R/W)

Zoning RHON By SL

Approve ✓ Date 11/10/16

Revise - Use 434

Reject - MBL 101A

Front 30 Rear 30

Side 15 Corner -

Comments:

I, David W. Barrier, certify that this plat was drawn under my supervision from an actual survey made under my supervision; that the boundaries not surveyed are clearly indicated and any encroachments are shown.

David Barrier

PROPERTY OF
MARCIA T. OLSON
& WILLIAM J. LOEFFLER, III

3200 OAKLYN SPRINGS DR. RALEIGH, N.C.

SCALE: 1"=50'

DATE: 5/26/15

BOOK: M-240-48

DAVID W. BARRIER
Licensed Surveyor
421 S. Harrison Ave.
Cary, N.C. 27511
(919) 469-2834