

Environmental Services - Water Quality
Onsite Wastewater Scan Data Entry Form

PERMIT #: 3026094

PIN #: 0789895630

OP DATE: 0511111983

SYSTEM USE:

- ☒ House
☐ Mobile Home
☐ Business
☐ Other

SEWAGE TYPE:

- ☒ Domestic
☐ Industrial

PUMP/SIPHON?:

- ☐ Yes
☒ No

PRESSURE MANIFOLD:

- ☐ Yes
☒ No

SYSTEM TYPE:

- ☐ I
☒ II
☐ III
☐ IV
☐ V
☐ VI
☐ Other

SUB TYPE:

- ☒ A
☐ B
☐ C
☐ D
☐ E
☐ F
☐ G

NBR BEDROOMS:

- ☐ 1
☐ 2
☐ 3
☒ 4
☐ 5
☐ 6
☐ Other

MAINT. SCHEDULE:

- ☐ Yes
☒ No

CERT. OPERATOR

- ☐ Yes
☒ No

GT	ST	PT	SIZE
☐	☐		750
☐	☐	☐	900
☐	☐	☐	1,000
☐	☒	☐	1,200
☐	☐	☐	1,500
☐	☐	☐	1,800
☐	☐	☐	2,100
☐	☐	☐	2,500
☐	☐	☐	3,000
☐	☐	☐	4,000
☐	☐	☐	5,000
☐	☐	☐	8,000
☐	☐	☐	10,000
☐	☐	☐	Other
☒		☒	None/NA GT or PT

DRAINFIELD SIZE(SQ. FT.)

01200

DRAIN TYPE:

- ☒ Stone
☐ EZ Flow
☐ Infiltrator
☐ Biodiffuser
☐ Cultec
☐ Drip
☐ Hancor
☐ Large Dia. Pipe
☐ Multi-Pipe
☐ Other

MAX DEPTH (IN.):

- ☐ 12 in. or less
☐ 18 in. or less
☐ 24 in. or less
☐ 26 in. or less
☐ 28 in. or less
☐ 30 in. or less
☐ 32 in. or less
☐ 36 in. or less
☒ Other

STONE DEPTH (IN.):

- ☐ 8 in. or less
☒ 12 in. or less
☐ 18 in. or less
☐ 24 in. or less
☐ Other

TRENCHES:

- ☒ Individual
☐ Bed

TRENCH WIDTH (IN.):

- ☐ 12 in. or less
☐ 18 in.
☐ 24 in.
☒ 36 in.
☐ 6 ft. or less
☐ 9 ft. or less
☐ Other

07

WAKE COUNTY HEALTH DEPARTMENT SEPTIC TANK LAYOUT AND PERMIT

TAX MAP NO. 239 PARCEL NO. 83 PERMIT NO. B 26094

CONTRACTOR Lacy Buffaloe Bldg.

OWNER 11413 Old Creedmoor Rd DATE 3-8-83

LOCATION Pin 0789-89-5630

SUBDIVISION NAME Blackhorse Run LOT NO. 8 SECTION OR BLOCK NO. III

S. R. NO. 1831

REPAIR ☐ ORIGINAL PERMIT NO. _____

GARBAGE DISPOSAL UNIT YES ☐ NO ☒

HOUSE ☒ MOBILE HOME ☐ BUSINESS ☐

NO. BEDROOMS 4 LOT AREA 40,000 sq. ft.

SIZE OF TANK _____ gal.

NITRIFICATION LINE 2(200' x 3') 1200 sq. ft.

DEPTH OF STONE IN LINES: 12" ☒ 18" ☐


RISER AND BAFFLE REQUIRED ☒ PUMP REQUIRED ☐

WATER SUPPLY: INDIVIDUAL ☒ PUBLIC ☐ OTHER ☐

* PERMIT VOID 36 MONTHS FROM DATE OF ISSUANCE.


* PERMIT VOID IF NOT IN COMPLIANCE WITH ZONING REGULATIONS

* PERMIT MAY BE VOIDED IF SITE ALTERATIONS MADE

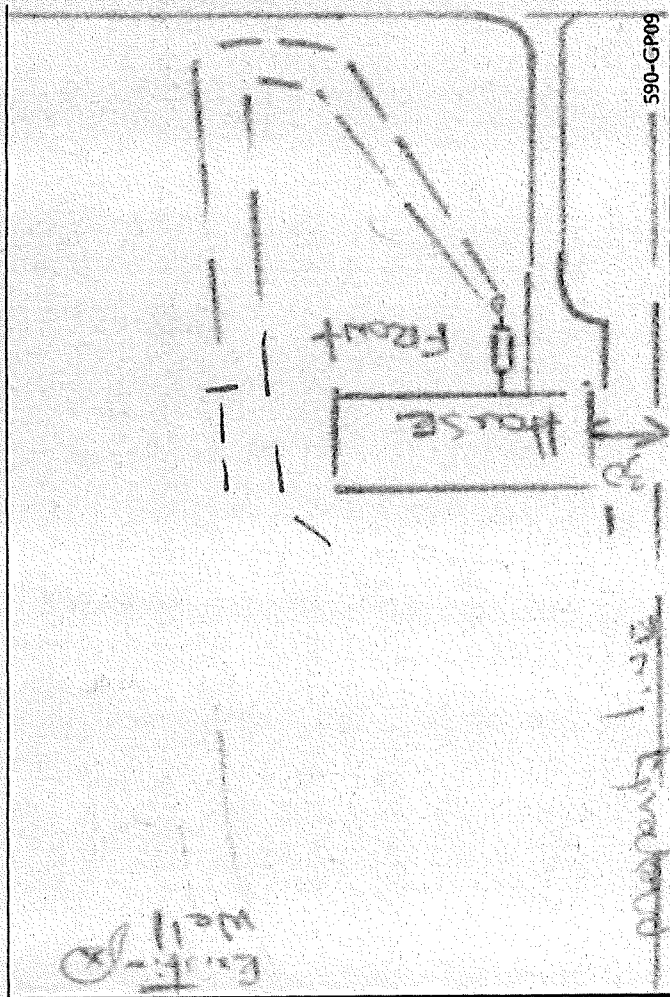


LAYOUT BY James L. Brown 590-GP09

DATE 5-11-83 INSTALLED BY Custom Tank APPROVED BY James L. Brown

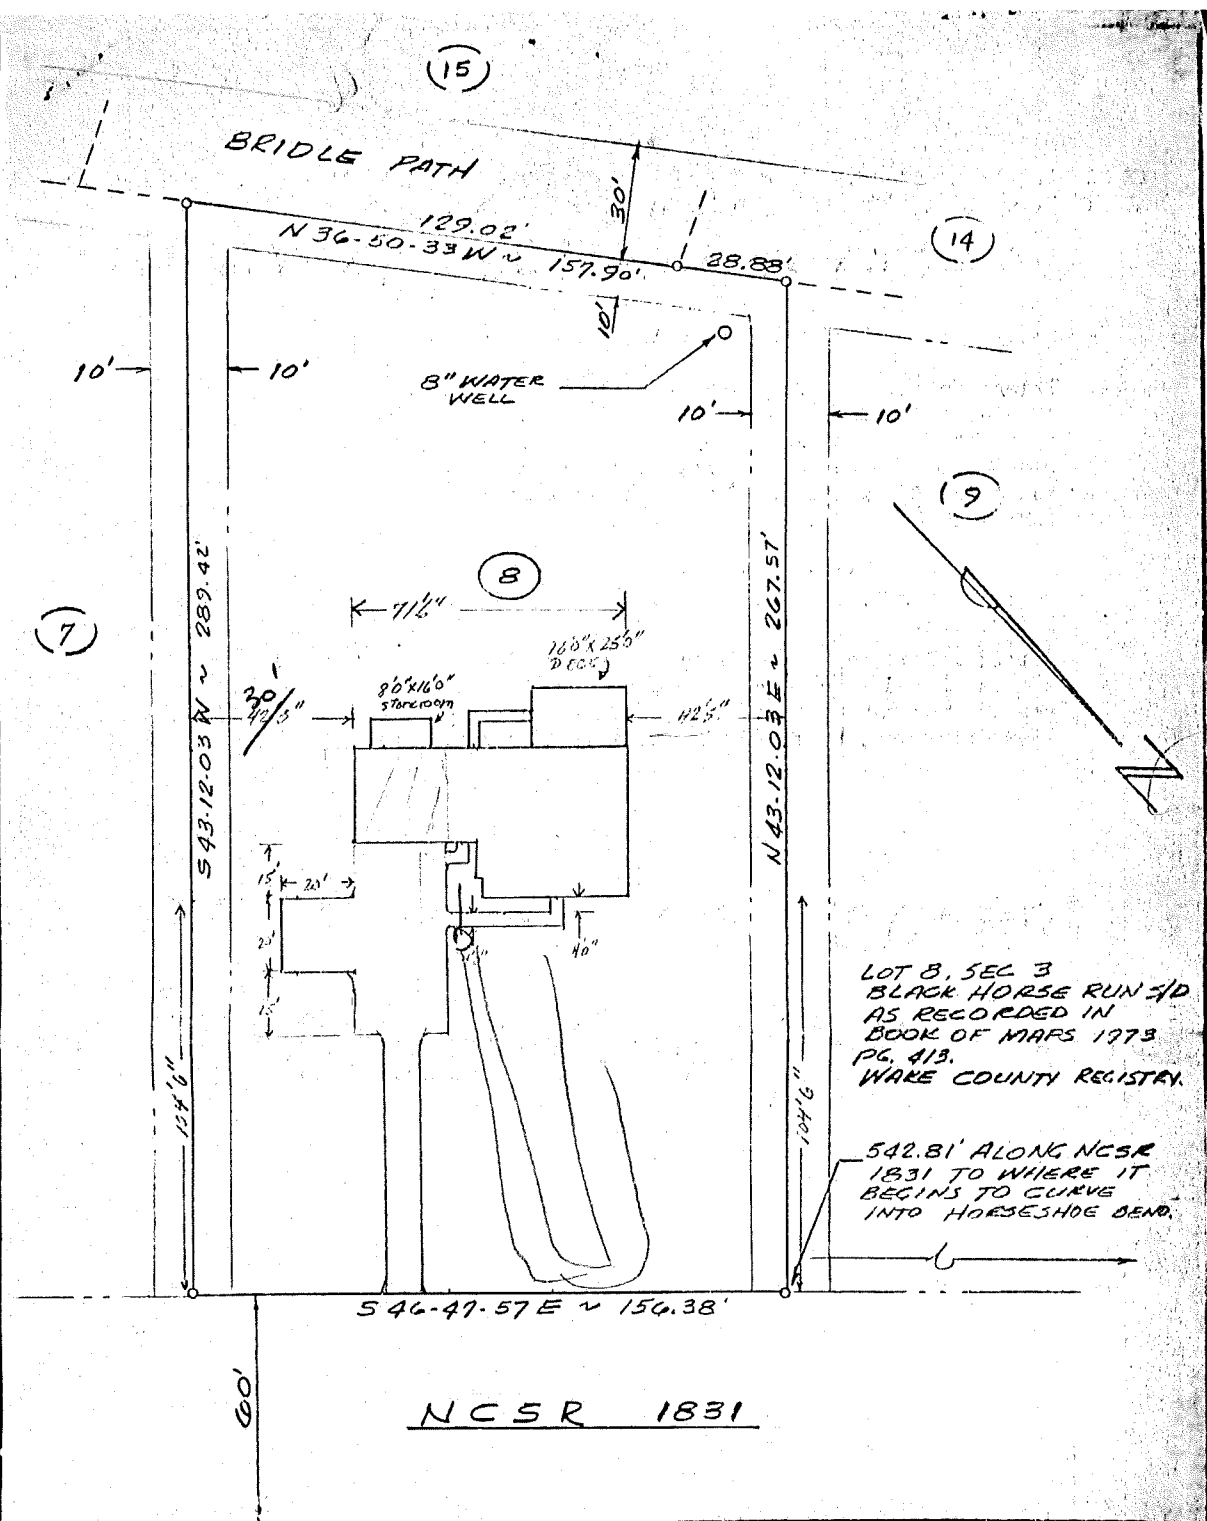

NOTE:
ALL LOT LINES HAVE A 20'
EASEMENT FOR UTILITIES, DRAINAGE
AND BURIAL OF DEBRIS.

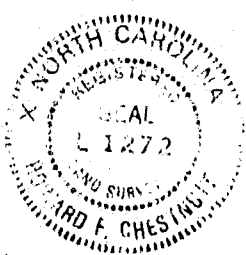

Howard F. Chestnutt
R.L.S. L-1272

PROPERTY OF		
JERRY WORTH KIRK & WIFE		
LAURA LENTZ KIRK		
LEESVILLE TWP.	WAKE CO.	NC
DATE 2-19-83	SURVEYED BY HOWARD CHESTNUTT	DRAWN BY HC
SCALE 1" = 40'	RALEIGH, NORTH CAROLINA	FILE NO.