

Environmental Services - Water Quality
Onsite Wastewater Scan Data Entry Form

PERMIT #: D 0 3 7 9 2 1

PIN #: 0 7 7 0 1 1 2 6 7 3

OP DATE: 1 0 1 0 8 1 2 0 0 9

SYSTEM USE:

- ☒ House
☐ Mobile Home
☐ Business
☐ Other

SEWAGE TYPE:

- ☒ Domestic
☐ Industrial

PUMP/SIPHON?:

- ☐ Yes
☒ No

PRESSURE MANIFOLD:

- ☐ Yes
☒ No

SYSTEM TYPE:

- ☐ I
☐ II
☒ III
☐ IV
☐ V
☐ VI
☐ Other

SUB TYPE:

- ☐ A
☐ B
☐ C
☐ D
☐ E
☐ F
☒ G

NBR BEDROOMS:

- ☐ 1
☐ 2
☐ 3
☒ 4
☐ 5
☐ 6
☐ Other

MAINT. SCHEDULE:

- ☐ Yes
☒ No

CERT. OPERATOR

- ☐ Yes
☒ No

GT ST PT

- | | | | |
|-------------------------------------|-------------------------------------|-------------------------------------|------------------|
| ☐ | ☐ | ☐ | 750 |
| ☐ | ☐ | ☐ | 900 |
| ☐ | ☐ | ☐ | 1,000 |
| ☐ | ☒ | ☐ | 1,200 |
| ☐ | ☐ | ☐ | 1,500 |
| ☐ | ☐ | ☐ | 1,800 |
| ☐ | ☐ | ☐ | 2,100 |
| ☐ | ☐ | ☐ | 2,500 |
| ☐ | ☐ | ☐ | 3,000 |
| ☐ | ☐ | ☐ | 4,000 |
| ☐ | ☐ | ☐ | 5,000 |
| ☐ | ☐ | ☐ | 8,000 |
| ☐ | ☐ | ☐ | 10,000 |
| ☐ | ☐ | ☐ | Other |
| ☒ | | ☒ | None/NA GT or PT |

DRAINFIELD SIZE(SQ. FT.)

0 1 2 0 0

DRAIN TYPE:

- ☐ Stone
☒ EZ Flow
☐ Infiltrator
☐ Biodiffuser
☐ Cultec
☐ Drip
☐ Hancor
☐ Large Dia. Pipe
☐ Multi-Pipe
☐ Other

MAX DEPTH (IN.):

- ☐ 12 in. or less
☐ 18 in. or less
☒ 24 in. or less
☐ 26 in. or less
☐ 28 in. or less
☐ 30 in. or less
☐ 32 in. or less
☐ 36 in. or less
☐ Other

STONE DEPTH (IN.):

- ☐ 8 in. or less
☒ 12 in. or less
☐ 18 in. or less
☐ 24 in. or less
☐ Other

TRENCHES:

- ☒ Individual
☐ Bed

TRENCH WIDTH (IN.):

- ☐ 12 in. or less
☐ 18 in.
☐ 24 in.
☒ 36 in.
☐ 6 ft. or less
☐ 9 ft. or less
☐ Other

WAKE COUNTY DEPARTMENT OF ENVIRONMENTAL SERVICES WELL AND SEWAGE SITE LOCATION PERMIT

NO PERMIT(S) FOR CONSTRUCTION, LOCATION OR RELOCATION ACTIVITY SHALL BE ISSUED
UNTIL AN AUTHORIZATION FOR WASTEWATER SYSTEM CONSTRUCTION HAS BEEN ISSUED

PERMIT VOID IF NOT IN COMPLIANCE WITH ZONING REGULATIONS AND/ OR IF SITE IS ALTERED OR INTENDED USE CHANGED

PERMIT#: D037921 STATUS: A APP. DATE: 09/01/2006 BLDG. PERMIT#: 0070755
PIN: 0770.03 11-8887-000 2473 TAX MAP: RECORDED: Y ORIG. PERMIT#:
TOWNSHIP: 18 SWIFT CREEK JURISDICTION: WC ZONING: R30
APPLICANT: GC CUSTOM HOMES INC
2929 BELLS POINTE CT
APEX, NC 27539
(919) 779-1997
USE: HD USE: 101 ONE-FAMILY HOUSE
EXIST USE:
DISPOSAL: BEDROOMS: 4 BASEMENT: N #EMPLOYEES: 0
SITE: ADDRESS: 3521 CASTELAINE CIR
SUBDIVISION: BROOKSHIRE MANO LOT: 10 ACRES: 0.82
DIRECTION: HWY 401 S, TR 1010, GO 4-5 MI TL WESTLAKE RD,
S/D 1 MI ON RT

Well System: WATER: INDIVIDUAL - TYPE: NEW

WELL LOG INFORMATION DEPTH: CASING DEPTH: YIELD: STATIC LEVEL:
WELL CONTRACTOR: *By the way* REG.# *1063* PUMP CONTRACTOR: REG.#
Construction Compliance GROUT APPROVED ☒ DATE *8/2/08* EHS *490*
WELLHEAD APPROVED ☒ DATE *8/2/08* EHS *490*
SYSTEM FINALIZED ☒ DATE *8/2/08* EHS *490*
COMMENTS: INDIVIDUAL WELL PLACED SEE CA FOR PLACEMENT

DESIGN FLOW: _____ gal./min. ACTUAL FLOW: _____ INNOVATIVE LETTER:
Operation Permit

INSTALLED BY: *Dennis Medlin* INSTALLATION APPROVED BY: *Leah Eversole*
PROPRIETARY SYSTEM: FILTER NO: *capolyox*
COMMENTS:
OPERATIONS PERMIT ISSUED? *Y* OP DATE: *10/8/09*
Louis A. Howard


This permit is based in part on information provided by the homeowner or his/her representative in the application submitted for this permit. The Environmental Health Specialist is not responsible for false or misleading information contained in the application. The Environmental Health Specialist is also not responsible for concealed conditions on the property or for statements in this report that may have resulted from false or misleading statements provided to him in the application. Neither Wake County nor the Environmental Health Specialist warrants that the septic tank system will continue to function satisfactorily in the future or that the water supply will remain potable.

As Built Information:

Date: *5/14* Benchmark: *ST* Rod reading: *5'* Distance to Structure: *10'*
ST: *851000* gals ID#: *STB 102* D.O.M.: *1/8/08* Elev.: *5'* Distance to Well: *100'*
PT: _____ gals ID#: _____ D.O.M.: _____ Elev.: _____
D-box/FD/PM elev.: *5'8"* Supply Line: *2* ft. Pump/Control Panel: _____
Line 1: *6'9"* Date: *5/14* Line 6: _____ Date: _____
Line 2: *6'11"* Date: _____ Line 7: _____ Date: _____
Line 3: *7'8"* Date: *↓* Line 8: _____ Date: _____
Line 4: *7'10"* Date: _____ Line 9: _____ Date: _____
Line 5: _____ Date: _____ Line 10: _____ Date: _____
Distance to P/L: _____ Notes: _____

CURVE TABLE				
CURVE	LENGTH	RADIUS	CHORD BEARING	CHORD
C1	167.20	335.00	S63°06'23"E	165.47

H.C. GRID NORTH MAD 83.
BOOK OF MAPS 2006, PAGE 1573

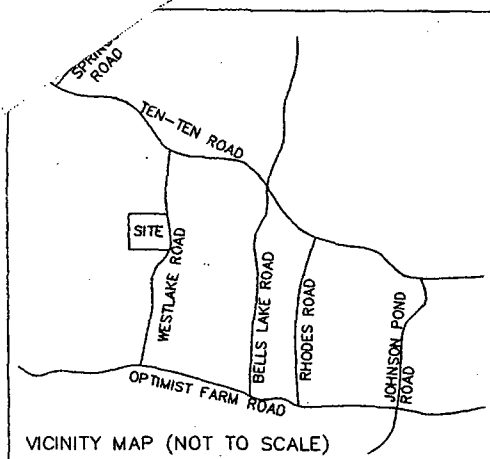

LOT 10-
HOUSE- 4900 SQ FT
DRIVEWAY- 1000 SQ FT
TOTAL- 5900 SQ FT OF IMPERVIOUS SURFACE

0070755
D 37921

BUILDING SETBACKS

FRONT = 30'
SIDE = 10'
REAR = 30'

LEGEND

LEGEND
EIP = EXISTING IRON PIPE
MH = MANHOLE
FES = FLARED END SECTION
CTV = CABLE TV PEDESTAL
TP = TELEPHONE PEDESTAL
C/L = CENTERLINE
R/W = RIGHT OF WAY

NOTES:

NOTES:
NOT FOR RECORDING, INFORMATION FOUND.
PROPERTY SUBJECT TO ANY EASEMENTS OF
RECORD.
MAXIMUM ALLOWABLE IMPERVIOUS SURFACE
AREA IN EACH LOT IS 6,862 SQ. FT.
EASEMENTS FOR INSTALLATION AND
MAINTENANCE OF UTILITIES AND DRAINAGE
FACILITIES ARE RESERVED OVER 10' AT REAR
AND 5' ON EACH SIDE LINE OF EACH LOT.
PRELIMINARY PLAT - BUILDER TO VERIFY
HOUSE DIMENSIONS AND BUILDING SETBACKS.

Zoning K30 By CHL
 Approve ✓ Date 8/30/02
 Revise _____ Use 101
 Reject _____ MBL _____
 Front 30 Rear 30
 Side 10 Corner _____
 Comments: SFO

I certify that the location of planned or existing structure(s) are accurately shown. I understand failure to locate structures in accordance with this plot plan may require the relocation of structure(s) regardless degree of completion. 1

hereby grant permission to Municipal/County
 AREA DESIGNATED AS HAVING SPECIAL FLOOD
 Repeal gives the right of entry to make
 EFFECTIVE DATE: MAY 21, 2000
 over and/or inspections upon this property.

Print# 077003118897

THIS PROPERTY ~~IS~~ NOT LOCATED IN AN AREA DESIGNATED AS HAVING SPECIAL FLOOD HAZARDS ACCORDING TO FLOOD INSURANCE RATE MAP #3720077000 J. ~~Repeals the right of entry to make~~

LOT 10 BLOCK _____ SECTION _____
SUBDIVISION BROOKSHIRE MANOR

RECORDED IN BOOK OF MAPS 2006 PAGE 1575 WAKE COUNTY REGISTRY

PLOT PLAN

~~SONYA A. WARD, HEREBY CERTIFY
THAT THIS MAP IS CORRECT, THAT
THE BUILDINGS LIE WHOLLY ON THE
LOT, AND THAT THERE ARE NO
ENCROACHMENTS OF OTHER BUILDINGS
ON THE SAID LOT, EXCEPT AS SHOWN
ON SURVEY.~~

SURVEY FOR:

G.C. CUSTOM HOMES

SWIFT CREEK TOWNSHIP

WAKE CO.

N.C

SCALE: 1" = 50'

DATE: 08/17/06

BOOK #:

WARD & ASSOCIATES, PLLC
CIVIL ENGINEERS & SURVEYORS
APEX, N.C. (919) 367-7858

WAKE COUNTY DEPARTMENT OF ENVIRONMENTAL SERVICES WELL AND SEWAGE SITE LOCATION PERMIT
NO PERMIT(S) FOR CONSTRUCTION, LOCATION OR RELOCATION ACTIVITY SHALL BE ISSUED
UNTIL AN AUTHORIZATION FOR WASTEWATER SYSTEM CONSTRUCTION HAS BEEN ISSUED

PERMIT VOID IF NOT IN COMPLIANCE WITH ZONING REGULATIONS AND/ OR IF SITE IS ALTERED OR INTENDED USE CHANGED

PERMIT#: D037921 STATUS: A APP. DATE: 09/01/2006 BLDG. PERMIT#: 0070755
PIN: 0770.03 11 ~~8887-888~~ 2473 TAX MAP: RECORDED: Y ORIG. PERMIT#:
TOWNSHIP: 18 SWIFT CREEK JURISDICTION: WC ZONING: R30
APPLICANT: GC CUSTOM HOMES INC
2929 BELLS POINTE CT
APEX, NC 27539
(919) 779 - 1997
USE: HD USE: 101 ONE-FAMILY HOUSE
EXIST USE:
DISPOSAL: BEDROOMS: 4 BASEMENT: N #EMPLOYEES: 0 FOUND DRAIN: N
SITE: ADDRESS: 3521 CASTELAINE CIR
SUBDIVISION: BROOKSHIRE MANO LOT: 10 ACRES: 0.82
DIRECTION: HWY 401 S, TR 1010, GO 4-5 MI TL WESTLAKE RD,
S/D 1 MI ON RT

IMPROVEMENT PERMIT

TANK SIZE: 1200 gal. PUMP Tank: 1200 gal. SQ FT: 1200 INNOVATIVE MAX DEPTH LINE: 24 in.
WASTEWATER: INDIVIDUAL SEWAGE: DOMESTIC TYPE SYSTEM: III G PUMP: ~~PA~~ P/M: N
DAILY FLOW: 480 gal/day DESIGN FEE REQ?: PAID?: WATER: INDIVIDUAL

COMMENTS:

IP ISSUED? Y DATE: 09/13/2006 BY: (TAH) *Thomas A. Howard* PHONE#: 369-5974

AUTHORIZATION FOR WASTEWATER/WATER SYSTEM CONSTRUCTION

VOID SIXTY (60) MONTHS FROM DATE OF ISSUANCE

AUTHORIZATION CONDITIONS:

Contractors shall install system on contours, see attached site plan for wastewater system design and well location: No underground utilities, water lines or sprinkler systems may be located in the original system or repair areas. A septic tank filter with a riser for access is required. The wastewater system shall not be covered or placed into use until inspected by the Wake County Department of Environmental Services and an Operation Permit issued. An Accepted Status System may be used in place of conventional system, if it can be placed in the permitted/authorized trench footprint (except reduction in line length and/or number as allowed for in approval) and the installation is in accordance with the accepted system approval, without unauthorized product alteration. If permit required use of an Accepted Status System, substitution with another accepted status system may be made, as long as no changes are necessary in the location of each nitrification line (including any increase in line length), trench depth or effluent distribution method. If changes are necessary, prior approval by this office is required before system installation. **OTHER CONDITIONS:**

SYSTEM DESIGNED AS A PUMP TO DISTRIBUTION BOX, HOWEVER IF GRAVITY IS ACHIEVABLE THERE WILL BE NO NEED FOR A PUMP. ACCEPTED STATUS HAS BEEN TAKEN GIVING IT A 25% REDUCTION IN DRAIN LINE LENGTH. A 1200 GALLON SEPTIC AND PUMP TANK WILL BE REQUIRED. NO FOUNDATION DRAIN IS TO BE INSTALLED AROUND HOUSE FOUNDATION. PROTECT REPAIR AREA AND MAINTAIN FOUNDATION AND PROPERTY LINE SETBACKS. INSTALL 4-100'X 3' DRAINLINES WITH A 24" MAXIMUM TRENCH BOTTOM. CALL PRIOR TO INSTALLATION WITH QUESTIONS OR CONCERNS.

INDIVIDUAL WELL PLACED SEE CA FOR PLACEMENT


WC:

10/09/06 - RECEIVED REVISION TO CHANGE FROM YES TO NO.KDJ

TANK SIZE: 1200 gal. PUMP TANK: ~~1200~~ gal. SQ FT: 1200 INNOVATIVE MAX DEPTH LINE: 24 in.
MAINT: N OPER: N L/O: Y TRENCH#: 4 LENGTH: 100 ft. WIDTH: ___ in. DESIGNER: ___
SUBFIELDS: ___ DESIGN HEAD PRESSURE: ___ DESIGN FLOW: ___ gal/min DOSE VOLUME: ___ gal.

CA ISSUED? Y DATE: 09/13/2006 BY: (TAH) *Thomas A. Howard* PHONE#: 369-5974

CA

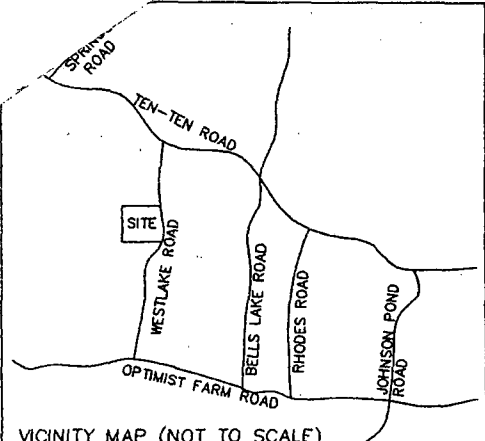

CURVE TABLE				
CURVE	LENGTH	RADIUS	CHORD BEARING	CHORD
C1	167.20	335.00	S63°06'23"E	165.47

Initial
0.3 LAR

1200 gallon septic & pump tank
Accepted status Taken - 2500 Reductio
utilize gravity if achievable otherwise
pump to D-Box.
4-100' x 3' Lines 24" Max Trench Bottom
N 85°21'40" W 150.10'

Well Place
30' off house?
50' off property
line

Repair Accepted status Pressure Man
0.3 LAR Gravity if Achievable
5-80' x 3' Lines LOT 11
24" Max Trench Bottom 0.73 AC.

LOT 10-
HOUSE- 4900 SQ FT
DRIVEWAY- 1000 SQ FT
TOTAL- 5900 SQ FT OF IMPERVIOUS SURFACE

0070755
D 37921

BUILDING SETBACKS

FRONT = 30'
SIDE = 10'
REAR = 30'

LEGEND

EIP = EXISTING IRON PIPE
MH = MANHOLE
FES = FLARED END SECTION
CTV = CABLE TV PEDESTAL
TP = TELEPHONE PEDESTAL
C/L = CENTERLINE
R/W = RIGHT OF WAY

NOTES:

NOT FOR RECORDING, INFORMATION FOUND
PROPERTY SUBJECT TO ANY EASEMENTS
RECORD.
MAXIMUM ALLOWABLE IMPERVIOUS SURFACE
AREA IN EACH LOT IS 6,862 SQ. FT.
EASEMENTS FOR INSTALLATION AND
MAINTENANCE OF UTILITIES AND DRAINAGE
FACILITIES ARE RESERVED OVER 10' AT REAR
AND 5' ON EACH SIDE LINE OF EACH LOT.
PRELIMINARY PLAT - BUILDER TO VERIFY
HOUSE DIMENSIONS AND BUILDING SETBACKS.

Zoning R30 By CHL
Approve ✓ Date 8/30/06
Revise Use 101
Reject MBL
Front 30 Rear 30
Side 10 Corner
Comments: SFO

Pin# 077003118887

THIS PROPERTY IS NOT LOCATED IN AN AREA DESIGNATED AS HAVING SPECIAL FLOOD HAZARDS ACCORDING TO
FLOOD INSURANCE RATE MAP #3720077000 J

LOT-10 BLOCK SECTION
SUBDIVISION BROOKSHIRE MANOR

RECORDED IN BOOK OF MAPS 2006 PAGE 1573 WAKE COUNTY REGISTRY

PLOT PLAN

SAW
2006348

SONYA A. WARD, HEREBY CERTIFY
THAT THIS MAP IS CORRECT, THAT
THE BUILDINGS LIE WHOLLY ON THE
LOT, AND THAT THERE ARE NO
ENCROACHMENTS OF OTHER BUILDINGS
ON THE SAID LOT, EXCEPT AS SHOWN
ON SURVEY.

SURVEY FOR:

G.C. CUSTOM HOMES

SWIFT CREEK TOWNSHIP

WAKE CO.

N.C.

SCALE: 1" = 50'

DATE: 08/17/06

BOOK #:

WARD & ASSOCIATES, PLLC
CIVIL ENGINEERS & SURVEYORS
APEX, N.C. (919) 367-7858

