PERMIT NUMBER 3330

GRANVILLE - VANCE DISTRICT HEALTH DEPARTMENT
IMPROVEMENT AND OPERATION PERMITS

COUNTY: VANCE	TAX NO. 0408 02044	TYPE OF ESTABLISHMENT		
	SR NO.	RESIDENCE X BUSINESS — OTHER —	NUMBER OF BEDROOMS: 3	NUMBER OF OCCUPANTS: 3
OWNER: WDT - CONSTRUCTION DENNIS THARRINGTON				
APPLICANT: KELCEY HAYES		WATER SUPPLY		
APPLICANT'S ADDRESS: 64 ALLEN RD		PUBLIC —	WELL X	OTHER —
PROPERTY ADDRESS/LOCATION: 64 ALLEN RD-		TYPE OF WASTEWATER SYSTEM		
		DESCRIPTION	INITIAL INSTALLATION	REPAIR
SUBDIVISION:		DESIGN FLOW:	360 gal/day	
LOT NUMBER: 1		LTAR:	0.3	
REFERENCE SKETCH (SEE PLAT FOR DETAILS)		ABSORPTION AREA:	1200 FT²	
		TRENCH WIDTH:	3'	
		TRENCH SPACING:	9' ON CENTERS	
		TOTAL TRENCH LENGTH:	400'	
		NUMBER OF TRENCHES:	5	
		GRAVEL DEPTH:	12"	
		TANK SIZE:	1000 GAL	
		CONDITIONS:	* 36" TRENCH DEPTH	

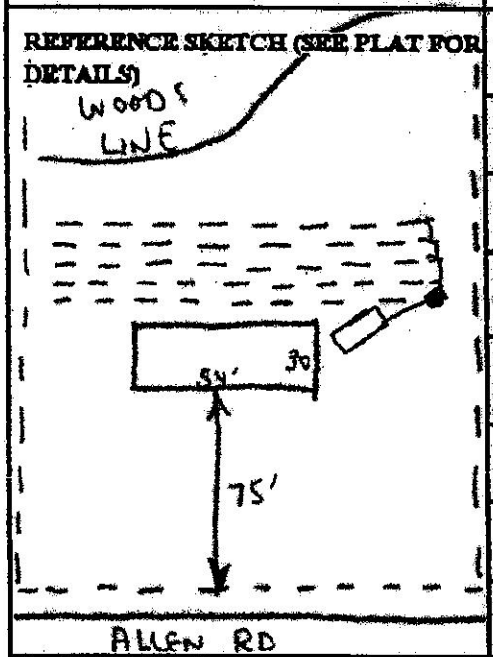

*THIS PERMIT SHALL BE ACCOMPANIED BY A LAYOUT SHOWN ON A PLAT, INCLUDING SYSTEM REQUIREMENTS.

*THE IMPROVEMENTS PERMIT MUST BE ATTACHED TO A CONSTRUCTION AUTHORIZATION BEFORE OBTAINING BUILDING PERMIT OR OTHER CONSTRUCTION PERMITS AND BEFORE A WASTEWATER SYSTEM IS INSTALLED.

*THIS IMPROVEMENT PERMIT IS SUBJECT TO REVOCATION IF THE INTENDED USE CHANGE FROM THOSE SHOWN ON THE IMPROVEMENT PERMIT. CHANGES SHALL REQUIRE HEALTH DEPARTMENT APPROVAL.

IMPROVEMENT PERMIT

FOR: KELCEY HAYES

ISSUED BY: David T. Yarn

DATE: 9-9-02

OPERATION PERMIT

SYSTEM INSTALLED BY: WADDELL

ISSUED BY: David T. Yarn

DATE: 3-4-03