PERMIT NUMBER 4075

GRANVILLE-VANCE DISTRICT HEALTH DEPARTMENT
IMPROVEMENT AND OPERATION PERMITS

COUNTY: Vance	TAX NO.	TYPE OF ESTABLISHMENT		
	SR. NO.	RESIDENCE ✓ BUSINESS ___ OTHER ___	NUMBER OF BEDROOMS: 4	NUMBER OF OCCUPANTS: 3
OWNER: Melanie Brame				
APPLICANT:		WATER SUPPLY		
APPLICANT'S ADDRESS:		PUBLIC ___	WELL ✓	OTHER ___
PROPERTY ADDRESS/LOCATION: 81 Rock Bluff Lane Kittrell, NC 27544		TYPE OF WASTEWATER SYSTEM		
		DESCRIPTION	INITIAL INSTALLATION	REPAIR Same
SUBDIVISION:		DESIGN FLOW:	480 g/day	
LOT NUMBER:		LTAR:	.4	
REFERENCE SKETCH (SEE PLAT FOR DETAILS) * See attached site plan.		ABSORPTION AREA:	1,200 ft²	
		TRENCH WIDTH:	3'	
		TRENCH SPACING:	9'	
		TOTAL TRENCH LENGTH:	400'	
		NUMBER OF TRENCHES:	4	
		GRAVEL DEPTH:	12"	
		TANK SIZE:	1,000 g	
		CONDITIONS:	Inst 11 trenches 36" - 42"	

*THIS PERMIT SHALL BE ACCOMPANIED BY A LAYOUT SHOWN ON A PLAT, INCLUDING SYSTEM REQUIREMENTS.

*THE IMPROVEMENTS PERMIT MUST BE ATTACHED TO A CONSTRUCTION AUTHORIZATION BEFORE OBTAINING BUILDING PERMIT OR OTHER CONSTRUCTION PERMITS AND BEFORE A WASTEWATER SYSTEM IS INSTALLED.

*THIS IMPROVEMENT PERMIT IS SUBJECT TO REVOCATION IF THE INTENDED USES CHANGE FROM THOSE SHOWN ON THE IMPROVEMENT PERMIT. CHANGES SHALL REQUIRE HEALTH DEPARTMENT APPROVAL.

IMPROVEMENT PERMIT FOR: Melanie Brame ISSUED BY: Mac Shingleton, RS	DATE: 12-9-03
OPERATION PERMIT SYSTEM INSTALLED BY: Adam Williams ISSUED BY: Mac Shingleton, RS	DATE: 7-13-04

Installed as 3, 4 lines.

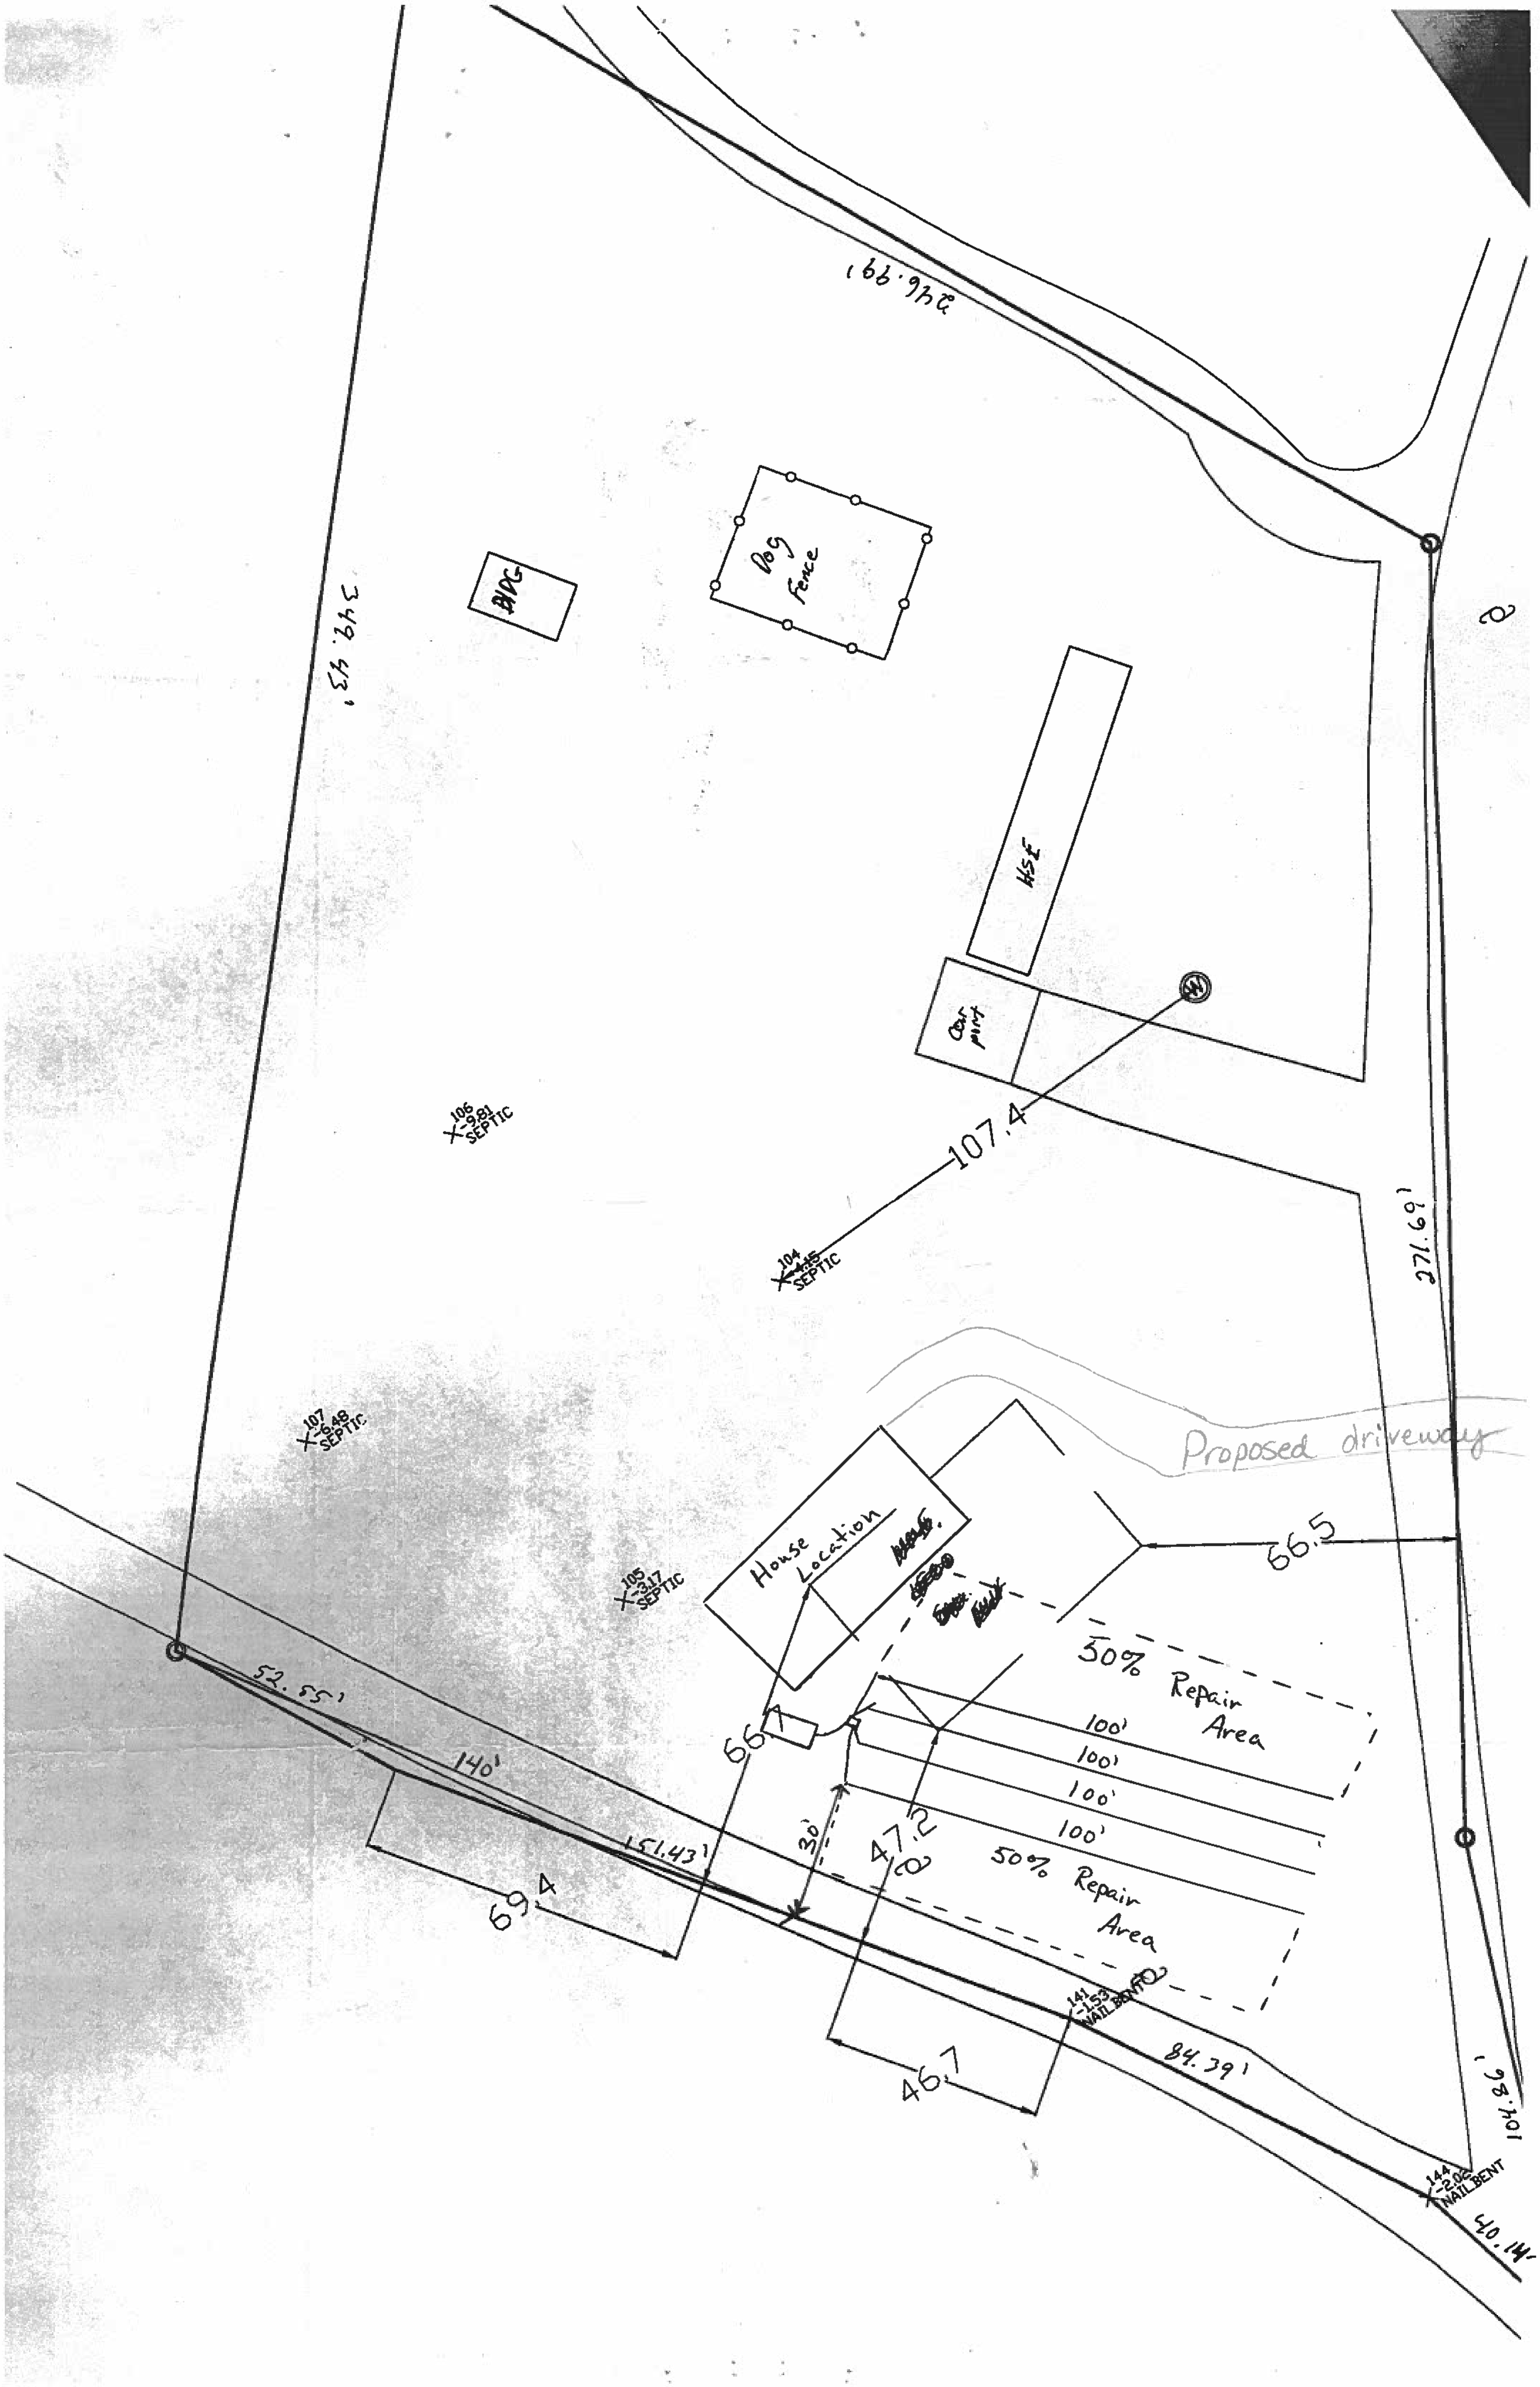

246.99'
BLDG
Dog Fence
349.43'
HSE
Car port
107.4
106 -9.81 SEPTIC
104 SEPTIC
271.69'
107 -6.48 SEPTIC
Proposed driveway
House Location
66.5
105 -3.17 SEPTIC
50% Repair Area
100'
100'
100'
100'
50% Repair Area
52.55'
140'
66
30'
47.2
151.43'
69.4
141 -1.53 NAIL BENT
84.39'
46.7
104.86'
144 -2.02 NAIL BENT
40.14'