GRANVILLE-VANCE HEALTH DEPARTMENT—Sewage Disposal Record

Owner or Contractor White, Curtis Date 8-23-91 S.R. No.

Location/Address US #1 By-pass 42 Stoneridge Dr

Subdivision/Mobile Home Park Name Cobbestone Lot Size

Permit No. # 0452 A 01018 .76 Ac Lot No. 18

New System ✓ Repair

House ✓ Mobile Home Business

No. Bedrooms 3 No. People — No. Toilets 2

Water Supply: Private ✓ Approved

Semi-Public Unapproved

Public None

Nitrification System:

Tank Size 1000 gal.

Distribution Box yes No. Lines 2

Nitrification Field 900 Sq. Ft.

Lines:	1	2	3	4	5	6
Width	3	3				
Length	150	150				
Grade	✓	✓				
Stone Depth	12	12				

Layout to be followed by installer:

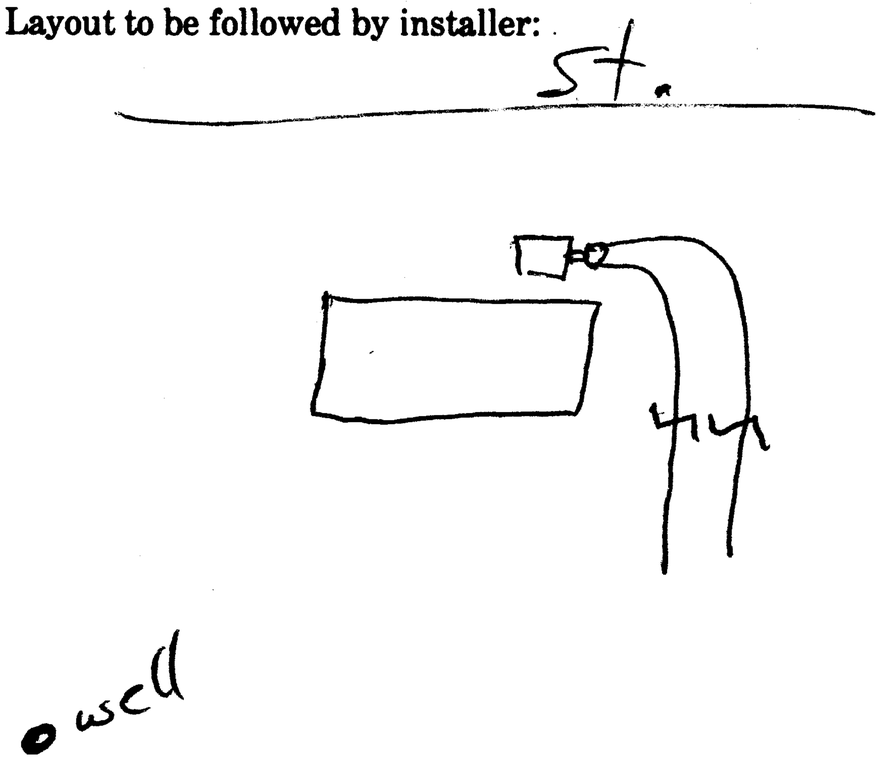

Improvements Permit By W. Vaughan Installer John Lyscue

Certificate of Completion By W. Vaughan Date of Inspection 10-5-91

* Construction must comply with all other applicable state and local regulations, but the permit is not a guarantee that the system will not malfunction and the Granville-Vance Health District will not be held responsible for a malfunctioning system.