GRANVILLE-VANCE HEALTH DEPARTMENT—Sewage Disposal Record

Owner or Contractor Newton John Date 4-18-91 S.R. No.

Location/Address Hicksboro Rd Mt Moriah Chapel Rd

Subdivision/Mobile Home Park Name 8621 Hicksboro Rd 0350 02017 Lot Size

Permit No. # Lot No. 363

New System ✓ Repair

House Mobile Home ✓ Business

No. Bedrooms 3 No. People 2 No. Toilets 2

Water Supply: Private ✓ Approved

Semi-Public Unapproved

Public None

Nitrification System:

Tank Size 100 gal.

Distribution Box yes No. Lines 3

Nitrification Field 900 Sq. Ft.

Lines:	1	2	3	4	5	6
Width	3	3	3			
Length	100	100	100			
Grade	✓	✓	✓			
Stone Depth	12	12	12			

Layout to be followed by installer: Bd

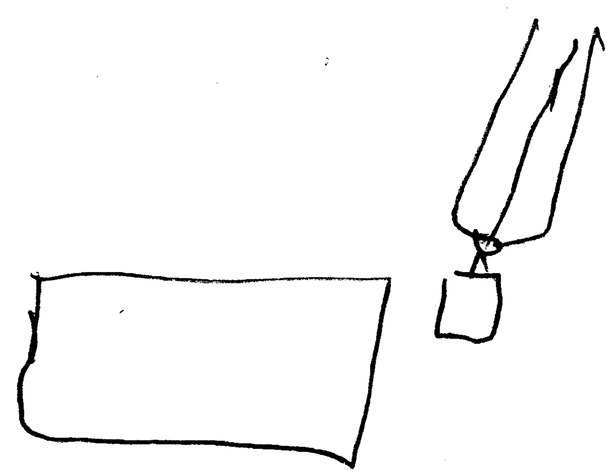

Improvements Permit By [signature] Installer Joe Aycoue

Certificate of Completion By [signature] Date of Inspection 5-31-91

* Construction must comply with all other applicable state and local regulations, but the permit is not a guarantee that the system will not malfunction and the Granville-Vance Health District will not be held responsible for a malfunctioning system.