NOTE:
This property is subject to N.C. BOARD OF TRANSPORTATION Right of Way as follows:

ALONG SR 1103

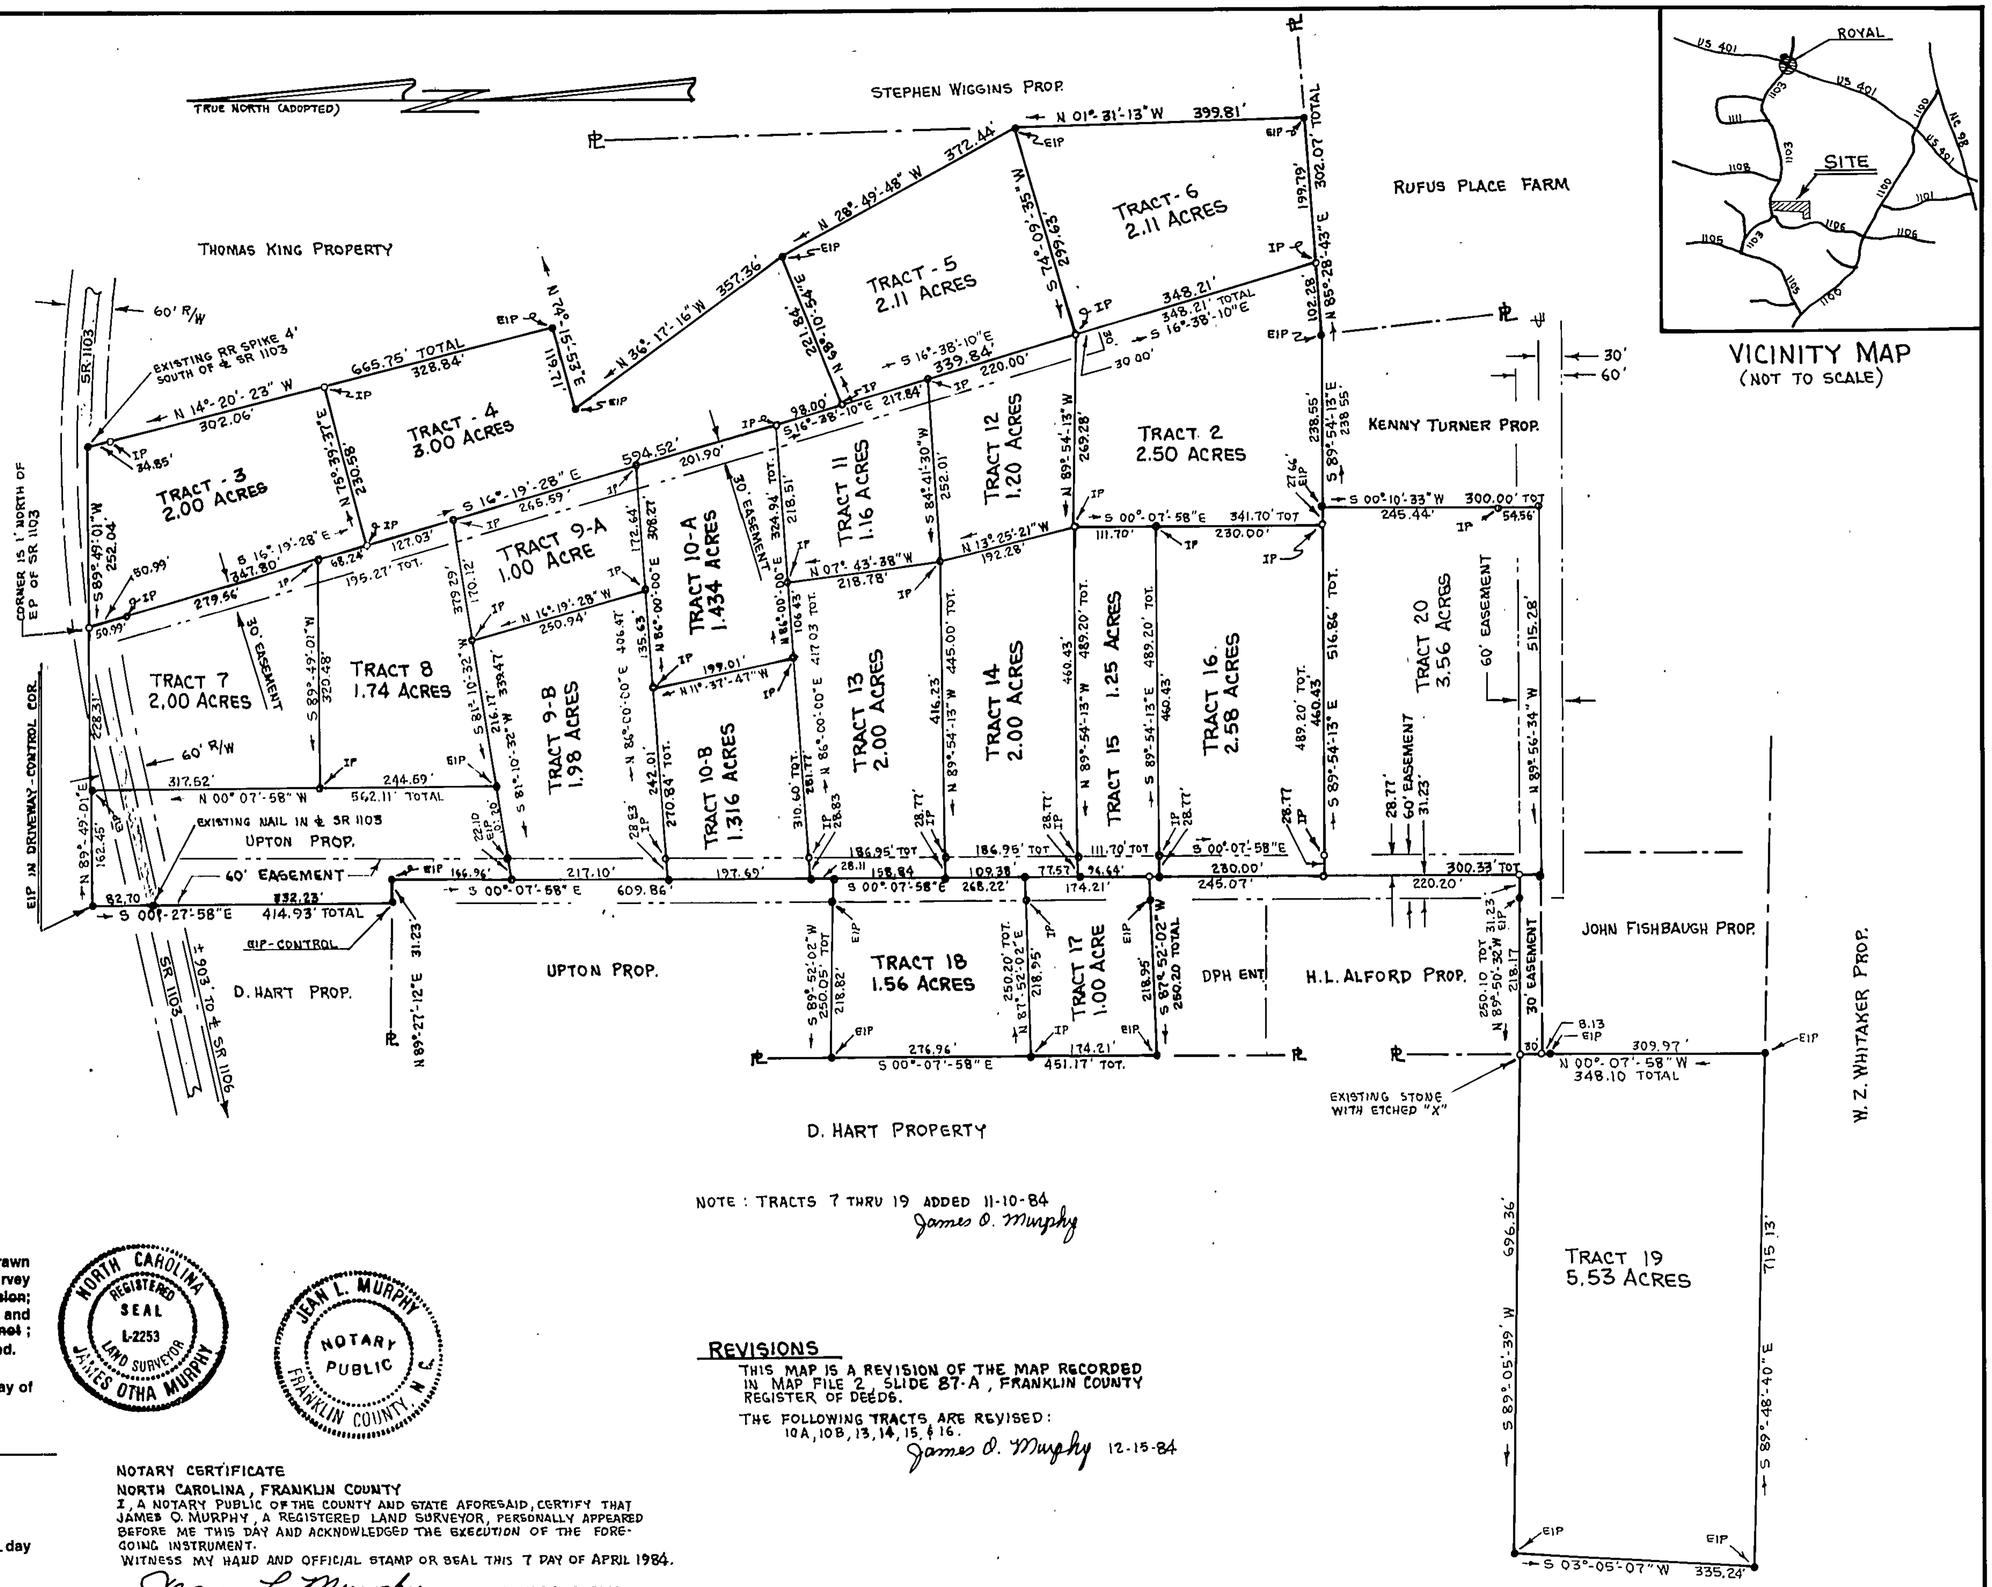

VICINITY MAP
(NOT TO SCALE)

NOTE : TRACTS 7 THRU 19 ADDED 11-10-84
James O. Murphy

State of North Carolina FRANKLIN County

I, JAMES OTHA MURPHY, certify that this map was drawn by me ~~drawn under my supervision~~ from an actual survey made by me ~~an actual survey made under my supervision~~; that the ratio of precision as calculated by latitudes and departures is 1:10,000+ that this map was ~~was not~~; prepared in accordance with G.S. 47-30 as ammended.

Witness my hand and seal this 7 day of APRIL, 19 84

James O. Murphy
Professional Engineer 4884
Registered Land Surveyor L-2253

Subscribed and sworn before me this _____ day of _____, 19 ____

Notary Public

My commission expires _____

NORTH CAROLINA REGISTERED SEAL L-2253 LAND SURVEYOR JAMES OTHA MURPHY

JEAN L. MURPHY NOTARY PUBLIC FRANKLIN COUNTY, N.C.

NOTARY CERTIFICATE
NORTH CAROLINA, FRANKLIN COUNTY
I, A NOTARY PUBLIC OF THE COUNTY AND STATE AFORESAID, CERTIFY THAT JAMES O. MURPHY, A REGISTERED LAND SURVEYOR, PERSONALLY APPEARED BEFORE ME THIS DAY AND ACKNOWLEDGED THE EXECUTION OF THE FOREGOING INSTRUMENT.
WITNESS MY HAND AND OFFICIAL STAMP OR SEAL THIS 7 DAY OF APRIL 1984.
Jean L. Murphy NOTARY PUBLIC
MY COMMISSION EXPIRES 10-28-88.

REVISIONS
THIS MAP IS A REVISION OF THE MAP RECORDED IN MAP FILE 2, SLIDE 87-A, FRANKLIN COUNTY REGISTER OF DEEDS.
THE FOLLOWING TRACTS ARE REVISED: 10A, 10B, 13, 14, 15, & 16.
James O. Murphy 12-15-84

North Carolina, Franklin County
The foregoing certificate of Jean L. Murphy, A Notary Public of Franklin County, North Carolina, is certified to be correct. This instrument was presented for registration this 8th day of January, 1985, at 1:00P.M. and duly recorded in the Office of The Register of Deeds of Franklin Co.,N.C. in Plat Record File #2, Slide 91-A.

Martha D. Shearin
Martha D. Shearin Register of Deeds
By: Wanda L. Aycock, Deputy

SURVEYED BY
JAMES O. MURPHY
Professional Engineer 4884
Registered Land Surveyor L-2253
YOUNGSVILLE N.C.
PHONE 556-2058
DATE: 4-7-84
SCALE: 1" = 50'

E I P	EXISTING IRON PIN	—S—	SEWER LINE
I P	IRON PIN	—W—	WATER LINE
℄	CENTER LINE	P P	POWER POLE
PL	PROPERTY LINE	R/W	RIGHT OF WAY
—E—	ELECTRIC POWER LINE	—T—	TELEPHONE LINE
—ET—	ELECTRIC & TELEPHONE LINE		

REVISED MAP OF FRANKLIN VINEYARDS

YOUNGSVILLE TOWNSHIP, FRANKLIN COUNTY, N.C.

BRUNING 44-131 36178

Field Book 24 25 22 Page 61 96 45