

Fax 478-5569

PAGE 1 OF 2

**Franklin County Health Department
Environmental Health Section
107 Industrial Drive-Suite C
Louisburg, North Carolina 27549**

Phone: 919-496-8100

Fax: 919-496-8136

Permit Number: 3639 Type: I PIN: 2830-75-5182 Date: 5/16/2007
Applicant: KENNETH & JEFF BROWN Owner: FIRST BAPTIST CHURCH OF ROCKY
4303 N ANDREWS AVE 200 S CHURCH ST
FT LAUDERDALE, FL 33309 ROCKY MOUNT, NC 27801
Telephone: (919) 727-0024 Telephone:
Subdivision: LAKE ROYALE Lot Number: 370 Size: 1.000

Physical Address/ Location /Directions

Description: LifeTime _____ 5 Year X

TYPE FACIL Res # EMPLOY - # BEDRMS 3 GPD 360 LTAR .35¹/_d
TYPE WAT Com TYPE SYS P/I TYPE REP N/A BSMT 0 BST FX N/A
SIZE TANK 900 SIZE CHB 1000 SIZE NITR 3x270 MTD 30"

COMMENTS Pressure manifold distribution

3 BD12 house max -

Septic Contractors are responsible for notifying the health department for final inspections, between 8:00-9:00 AM on the day of completion, Monday - Friday. Any request for final inspections received afterwards will be scheduled the same day, if possible, or the next workday. Have permit number and owner/applicant's name ready when making the call.

Actions of representatives of state or local agencies engaged in the evaluation and determination of measures required to effect the compliance with the provisions of this permit shall in no way be taken as a guarantee that wastewater disposal systems permitted and approved will function in a satisfactory manner for any given period of time, or that such employees assume any liability for damages, consequential or direct which are caused, or may be caused, by a malfunction of this wastewater treatment and disposal system.

Proper precautions must be taken to assure the proper functioning of the system after it has been covered. Do not run any heavy equipment over the system, as soft earth will allow damage to the tank and lines. Pipe all roof drains away from the septic system site to prevent flooding of the lines from surface water. Terrace the ground to prevent excessive drainage from higher areas adjacent to the system. Do not construct driveways over any part of the septic system unless proper provisions were made when the septic system was constructed. Only grass, not trees or shrubbery, should be cultivated over the lines. All plumbing fixtures should be carefully inspected periodically and any problems repaired immediately. All septic tanks should be pumped off by a permitted pump operator on a regular schedule, not to exceed every five years.

The improvement permit and construction authorization is a site approval, for the future installation of a wastewater treatment and disposal system. Changes in ownership of the site do not affect the validity of this permit. However, any alteration of the site or soil conditions, changes in the location of the proposed facility, changes to the wastewater flow and/or characteristics, or submittal of false information with the application or misrepresentation of the property lines may subject this permit to suspension or revocation.

FOR THIS TO BE A VALID CONSTRUCTION AUTHORIZATION, A LAYOUT SHEET MUST BE ATTACHED

IMPROVEMENT PERMIT

DATE 5/25/07 EHS

CONSTRUCTION AUTHORIZATION

DATE _____ EHS

Jeffrey W. [Signature]

Franklin County Health Department

Name: BROWN


Permit Number

3639

CONTRACTOR _____ TANK MANU _____ MANU DATE _____

WELL INSTALLED YES _____ NO _____ SYSTEM CODE _____

SEPTIC SYSTEM LAYOUT (SKETCH SYSTEM LAYOUT HERE)

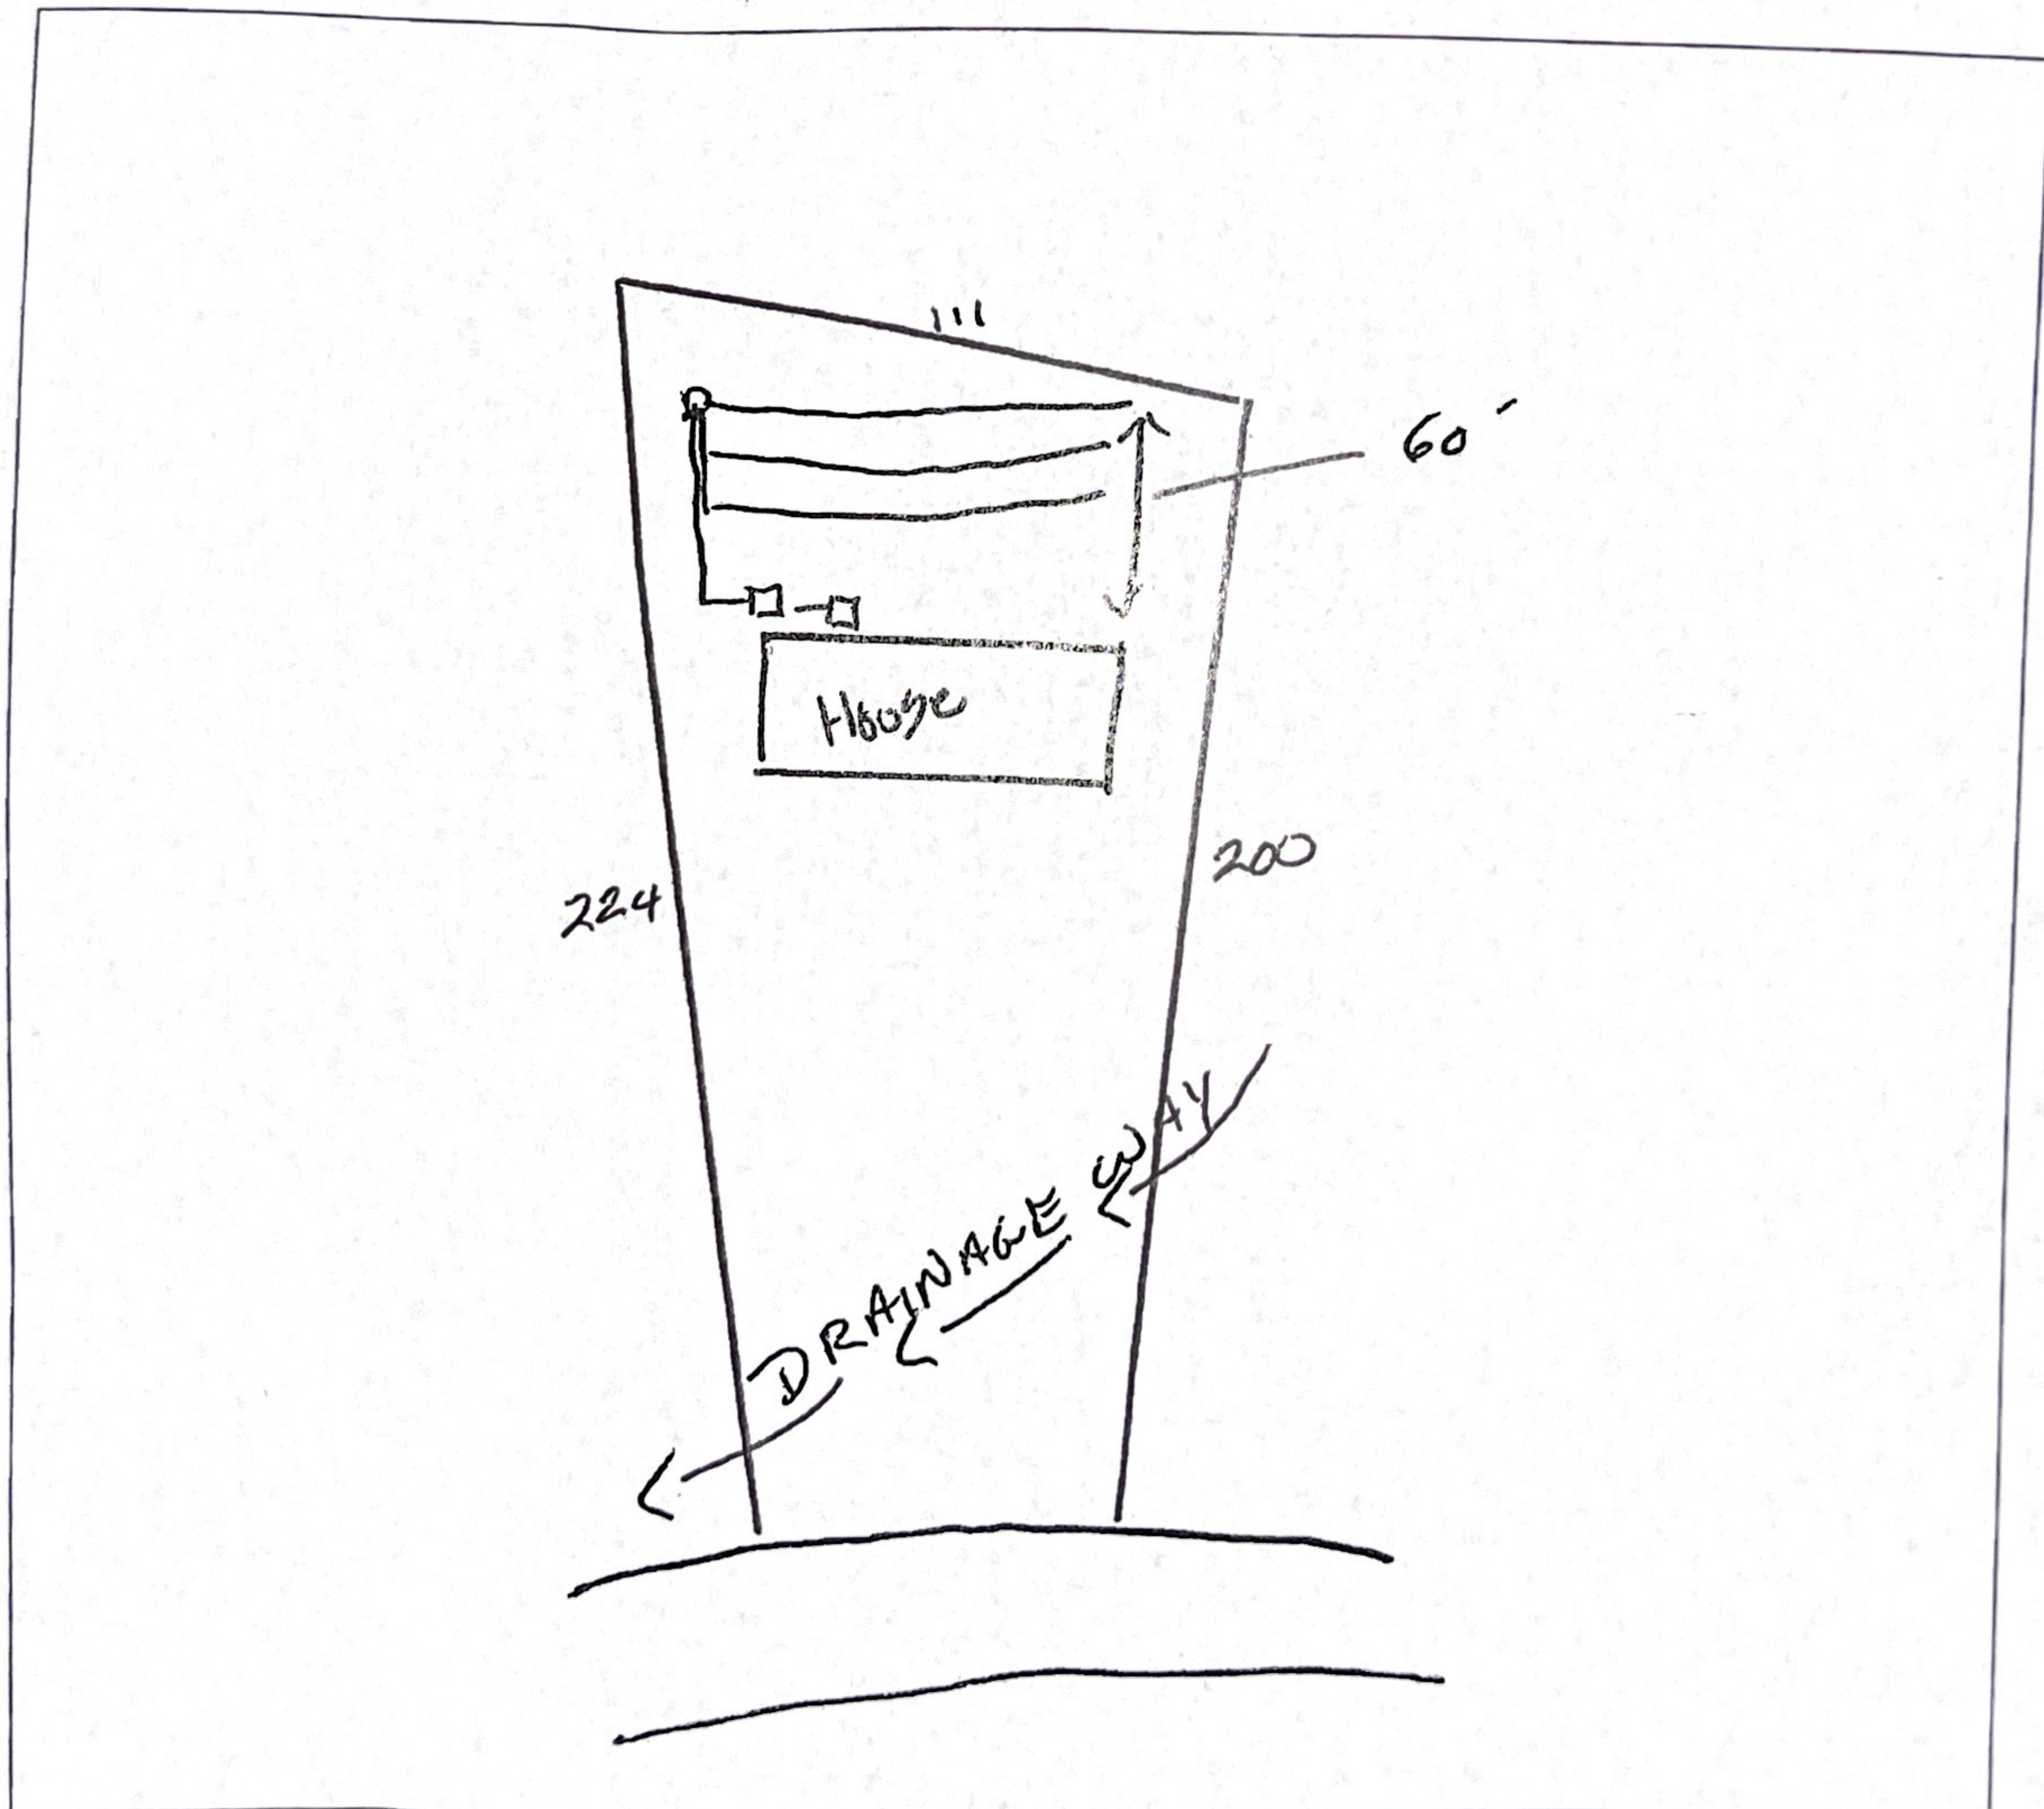

SEPTIC SYSTEM AS-BUILT
(IF DIFFERENT FROM INITIAL LAYOUT)
ON REVERSE

OPERATIONS PERMIT

DATE

EHS