

PERMIT NUMBER 0801

GRANVILLE-VANCE DISTRICT HEALTH DEPARTMENT IMPROVEMENT AND OPERATION PERMITS

ZPH 18517

COUNTY: <u>Granville</u>	TAX NO. <u>1930206837</u>	TYPE OF ESTABLISHMENTS			*THIS PERMIT SHALL BE ACCOMPANIED BY A LAYOUT SHOWN ON A PLAT, INCLUDING SYSTEM REQUIREMENTS. *THIS IMPROVEMENT PERMIT IS SUBJECT TO REVOCATION IF THE INTENDED USES CHANGE FROM THOSE SHOWN ON THE IMPROVEMENT PERMIT. CHANGES SHALL REQUIRE HEALTH DEPARTMENT APPROVAL.
	SR. NO.	RESIDENCE ☒ BUSINESS ☐ OTHER ☐	NUMBER OF BEDROOMS: <u>3</u>	NUMBER OF OCCUPANTS:	
OWNER: <u>Steven Hayes</u>	WATER SUPPLY <u>Private</u>	WELL ☒ PUBLIC ☐	OTHER ☐		
	LTAR:	<u>275</u>			
LOT NUMBER: <u>22</u>	TRENCH WIDTH:	<u>36"</u>			
REFERENCE SKETCH (SEE PLAT FOR DETAILS) <u>Be careful when clearing site</u> <u>Do not disturb soils</u> <u>Maintain all setbacks</u>	TRENCH DEPTH:	<u>18-20"</u>			
	TRENCH SPACING:	<u>9' on corner</u>			
	TOTAL TRENCH LENGTH:	<u>330'</u>			
	NUMBER OF TRENCHES:	<u>3</u>			
	GRAVEL DEPTH:	<u>accepted</u>			
	TANK SIZE:	<u>1000</u>			
	PUMP TANK SIZE:	<u>1</u>			
	DISTRIBUTION DEVICE:	<u>D box</u>			
PERMIT VALID FOR: 5 YEARS YES ☒ NO ☐ NO EXPIRATION YES ☐ NO ☒					

IMPROVEMENT PERMIT DATE: 12-9-14

FOR: Steven Hayes
ISSUED BY: Concetta Chavira ZHS

CONSTRUCTION AUTHORIZATION FOR IMPROVEMENT PERMIT#

Unless otherwise indicated, the same conditions above apply regarding system type, layout, location and installation requirements.
(The wastewater system cannot be installed until authorization is signed)

Comments: _____

Date: 12-9-14 Environmental Health Specialist: [Signature] Construction Authorization Addendum ☐ Yes ☒ No

OPERATION PERMIT

DATE: 5-19-15

SYSTEM INSTALLED BY: Dequid Brantley & Sons
ISSUED BY: [Signature]

PERFORMANCE, MONITORING, MAINTENANCE AND OPERATION
AS REQUIRED BY RULE .1961

Pin 193000683750

Permit Number 8100/1396

✓ Construction Authorization


Steven Hayes
Applicants Name

Cassette Champion
Authorized State Agent

Gresham Crossings - lot # 22
Subdivision - Section - Lot
12-9-14
Date

Be careful when clearing lot.

Do not disturb soils

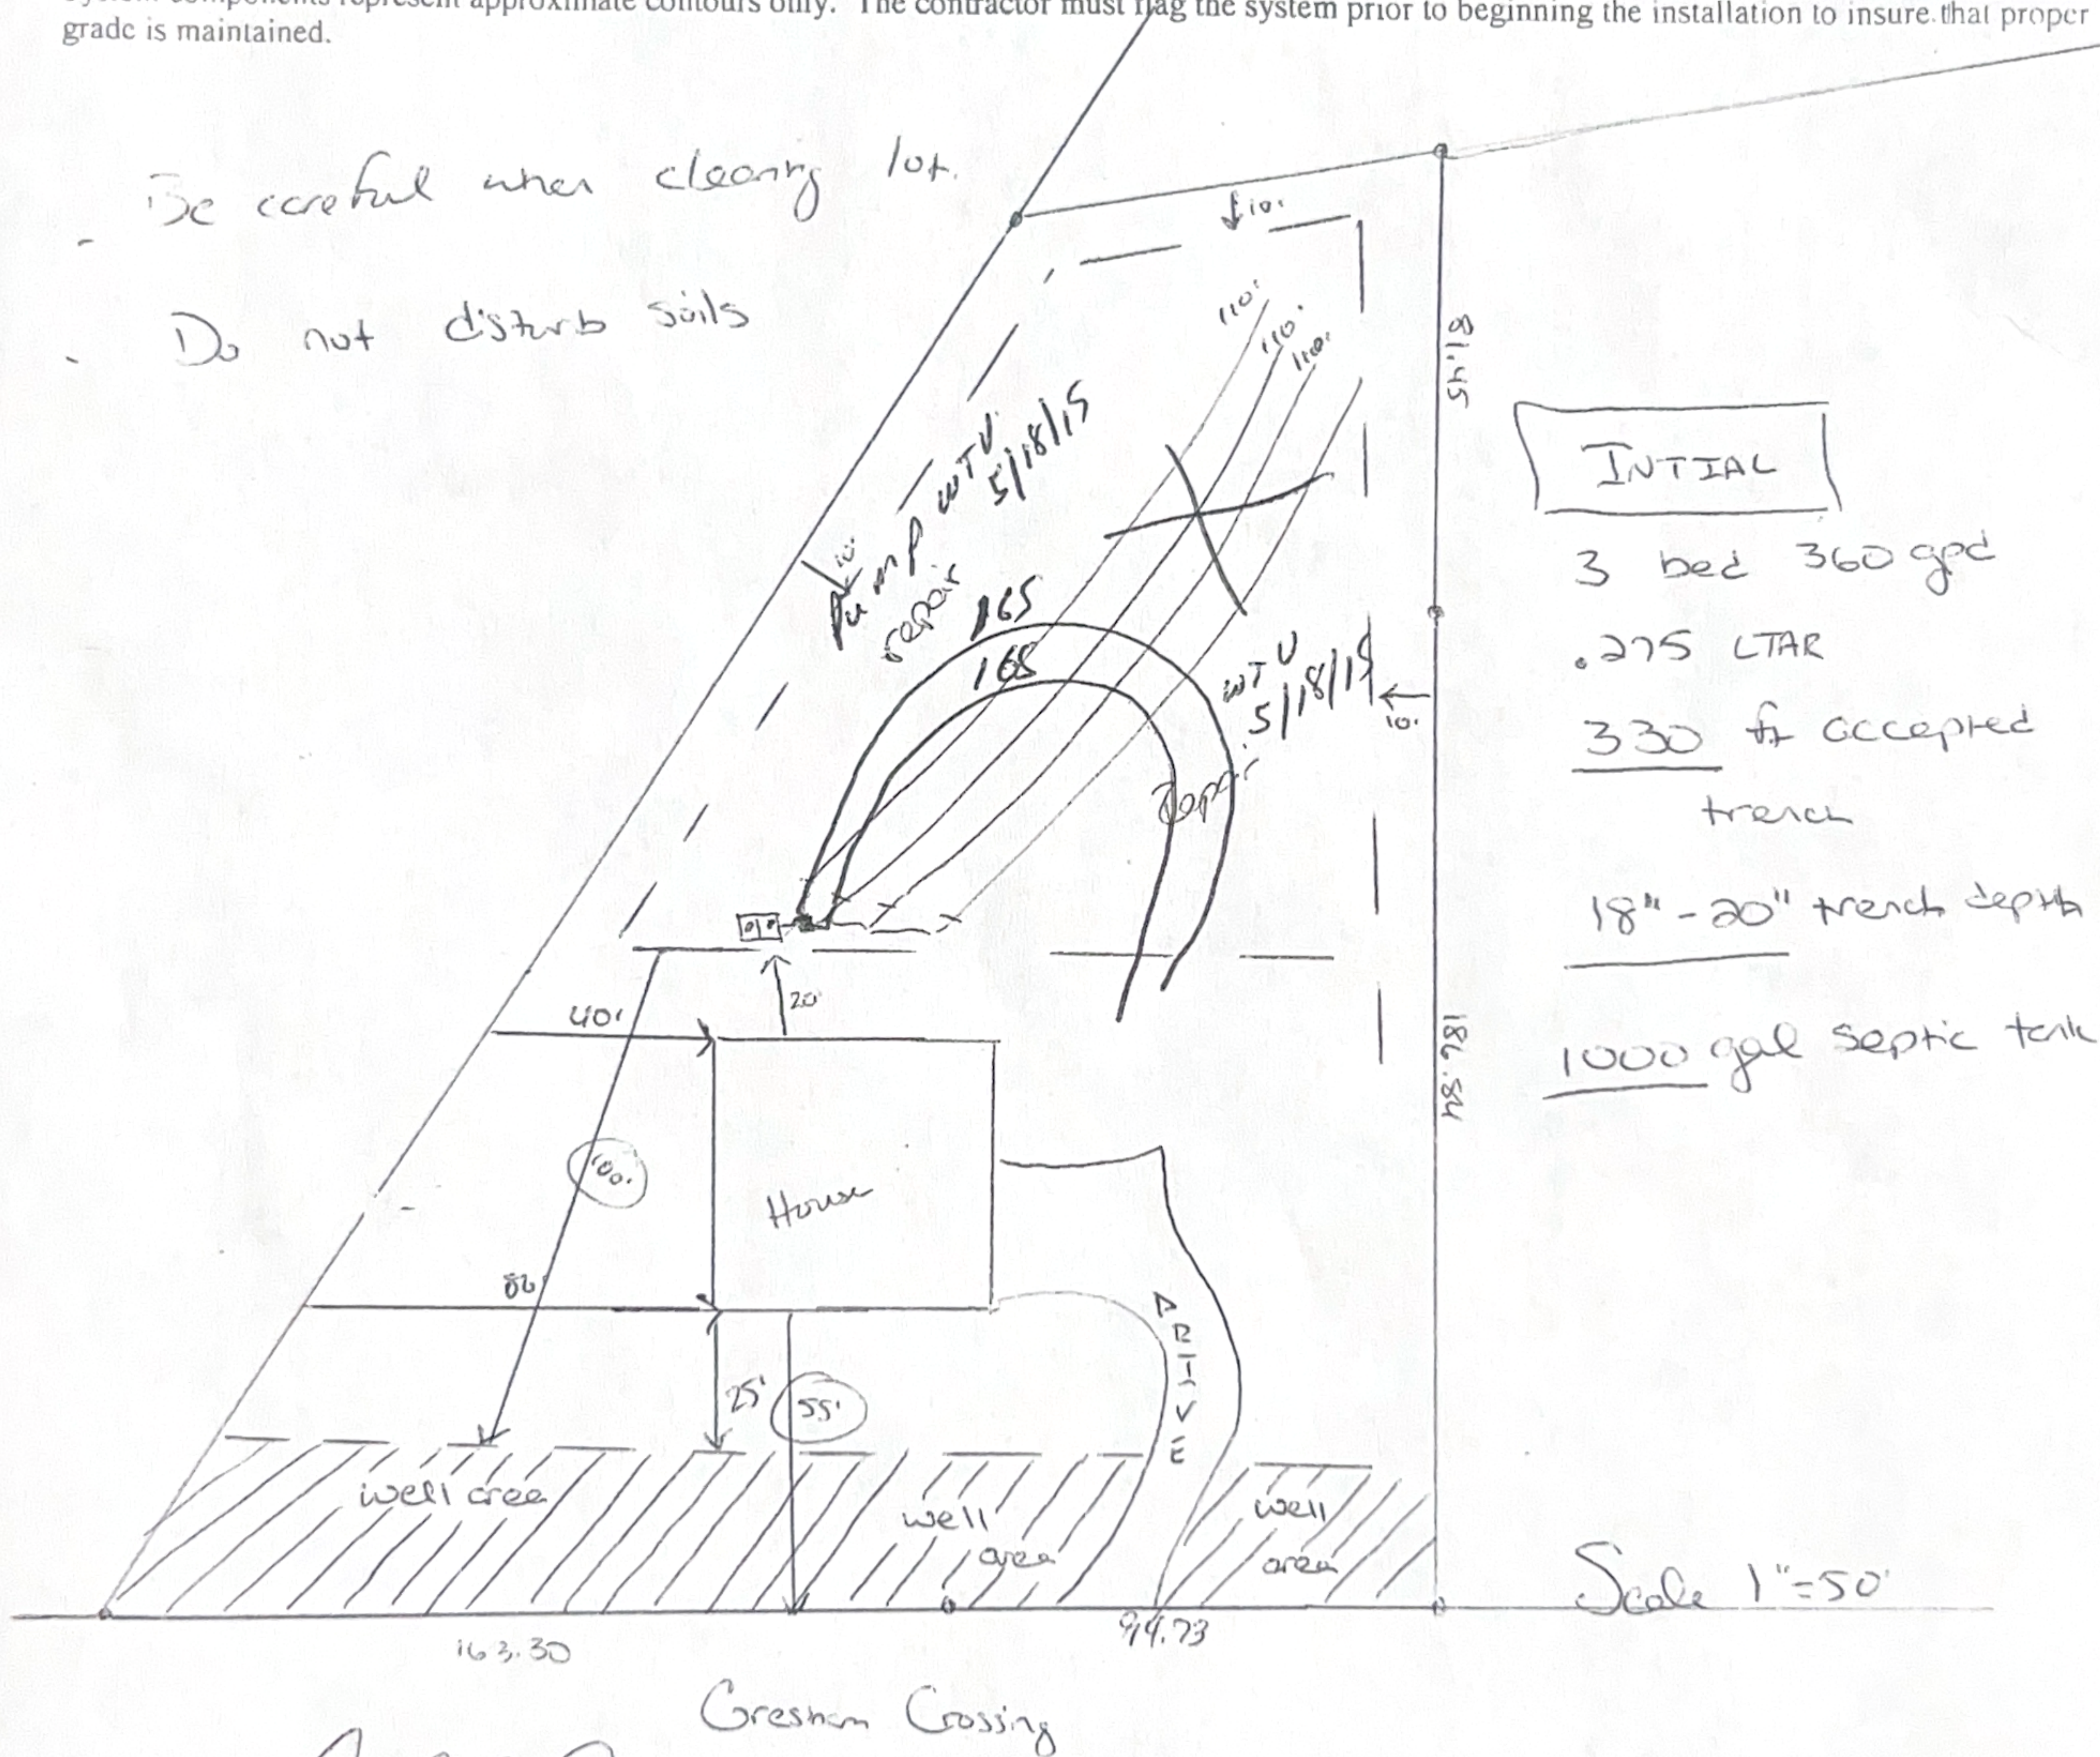

Signature _____

Date 12-9-14